



CHUCK E. CHEESE



14005 E Exposition Ave.
Aurora, CO 80012



City of Aurora Building Division

Project: **Chuck E. Cheese**

Address: **14005 E. Exposition Ave.**

Occupancy Group: **A-2**

Construction Type: **UBC III-1 HR SPK**

RSN: **1369378**

Permit: **19-1625136**

Code violations that are found during inspection are required to be corrected. Permit issuance does not grant approval of a code violation.

Field Inspection consultation is available upon request. Call 303-739-7420 to request a consultation


This plan was reviewed for adopted codes and **NOT** for compliance with **ADA** or **FHA** accessibility requirements. Contact 800-949-4232 (**ADA**) and 303-894-7822 x 325 (**FHA**) for federal accessibility requirements that apply to your project.

Accessible Seating

At least 5%, but not less than 1 of the dining surfaces shall be accessible. Accessible seating shall be identified by a sign or a marker.

53 Tables x 42" = 2,226"/24" = 92.75 x .05 = 4.63 = 5
36 Tables x 56" = 2,016"/24" = 84 x .05 = 4.20 = 5
4 Tables x 60" = 240"/24" = 10 x .05 = 0.5 = 1
4 Tables x 90" = 360"/24" = 15 x .05 = 0.75 = 1

Total Accessible Tables Required: 12

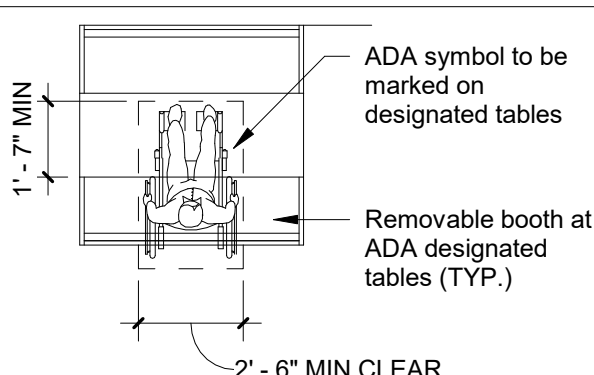

General Notes - Life Safety

- A Provide fire extinguishers within travel distance of 75'-0"
- B All penetrations through rated assemblies shall be installed per U.L. standard details and applicable codes as required to maintain the integrity of rated assemblies
- C Fire Alarm and Sprinkler system plans will be a deferred submittal.
- D Paint all exposed gas lines per local ordinances and codes.

Material Flame Spread

Material	Flame Spread
FRP Panels	175
Plastic Laminate	190
Carpet	30
LT-1 Ceiling Tile	25
LT-2 Ceiling Tile	10
Sheet Vinyl	45 Watts/CM
VCT	45 Watts/CM
Vinyl Base	75 or less
Paint	8.5 or less
Slat Wall	115

Life Safety Plan Legend

EXIT	Exit Light
→	Egress Pathway
---	Maximum Travel Distance
---	Diagonal Distance
FEC	Fire Extinguisher Cabinet
→	Direction of Egress
#	Seat Count tag
♿	Accessible Turning Radius
♿	Accessible Seating Location

OCCUPANCY LOAD

Games Area:	
A) Kiddie/Games Gross Area:	4,923 SF
B) Area Covered By Games:	1,491 SF
C) Kiddie/Games Net Area For Occupancy:	3,432 SF
D) Occupant Load:	3432sf/15 = 229 ppl
Showroom Area:	
Occupancy Based on Seating @24":	126 People
Occupancy Calculations:	
A) Games (Net Area):	229 People
B) Kiddie/Games/SR Fixed Seating:	242 People
C) Showroom (Based On Seating):	126 People
D) Kitchen:	1,654sf/200 = 8.27 People
Total Occupancy=	605 People

Cover Sheet General Notes	
A	No part of these documents supercede the other, any discrepancies require clarification from the Architect.
B	All disciplines are referenced to each other, any discrepancies require clarification from the Architect.
C	Verify all existing conditions with the drawings, any discrepancies require clarification from the Architect.
D	NIC means "Not In Contract", identifies items that are provided and installed under a separate contract. Shown for reference only.
E	OFICI means "Owner Furnished and Contractor Installed", identifies items that are provided by the owner and installed by the contractor as part of this contract.
F	Alternate items that are identified shall be priced separately, pricing shall include item and installation cost for inclusion into the contract if selected by the owner.
G	Signage will be submitted for a separate permit.
H	No water, no sewer, no structural, no changes to occupancy SF, no work in the kitchen or restrooms.

PROJECT SCOPE

This is an interior remodel of an existing free standing building. Scope of work includes minor interior and exterior cosmetic modifications to the existing Chuck E. Cheese's (CEC) store. The interior changes include relocation and addition of booths and games as shown on sheets A101 as well as the installation of new flooring throughout public spaces.

CODE SUMMARY


Use:	Restaurant
Building Code:	2018 IBC
Occupancy Class:	A2 - Restaurant
Construction Type:	III-B, Sprinklered
Building Area:	14,945 SF
Allowable Area:	-
Total Seating Capacity:	Seats (@24" per person)
Egress Load:	589
Exit:	Required
	Provided
	Required: 605 x 0.15 = 91" Total
	Provided: 200" Total

Building:	2015 International Building Code
Mechanical:	2015 International Mechanical Code
Electrical:	2017 National Electric Code
Plumbing:	2015 International Plumbing Code
Health:	-
Fire:	2015 International Fire Code
Accessibility:	2009 ICC/ANSI 117.1 Accessibility Standard
Energy:	2015 International Energy Conservation Code


The contractor shall comply with all applicable codes, ordinances and regulations in effect at the time of bidding and construction.

Index of Drawings

Sheet Number	Sheet Name	Current Revision	Current Revision Date
General			
CS1.0	Cover Sheet	1	5/22/19
CS2.0	Accessibility Standard	A	5/13/19
CS3.0	Accessibility Standard	A	5/13/19
Demolition			
D1.0	Demolition Floor Plan	A	5/13/19
D1.1	Demolition RCP Plan	A	5/13/19
D1.2	Demolition Elevations	A	5/13/19
Architectural			
A1.0	Floor Plan	1	5/22/19
A1.2	Dimension Outlet Plans	A	5/13/19
A2.0	Floor Finish Plan	A	5/13/19
A3.0	Reflected Ceiling Plan	A	5/13/19
A4.0	Exterior Elevations	A	5/13/19
A5.0	Interior Elevations	A	5/13/19
A5.1	Interior Elevations	A	5/13/19
A7.3	Interior Details	A	5/13/19
A7.4	Interior Details	A	5/13/19
A8.0	Schedules	A	5/13/19
A9.2	Enlarged Restroom Plan	1	5/22/19
Plumbing			
P1.0	Plumbing Plan		
Electrical			
AV1	Speakers Plan	1	5/22/19
E1.0	Lighting Floor Plan	1	5/22/19
E2.0	Power Floor Plan	1	5/22/19
E3.0	Electrical Details	1	5/22/19
ES1.0	Site Plan	1	5/22/19

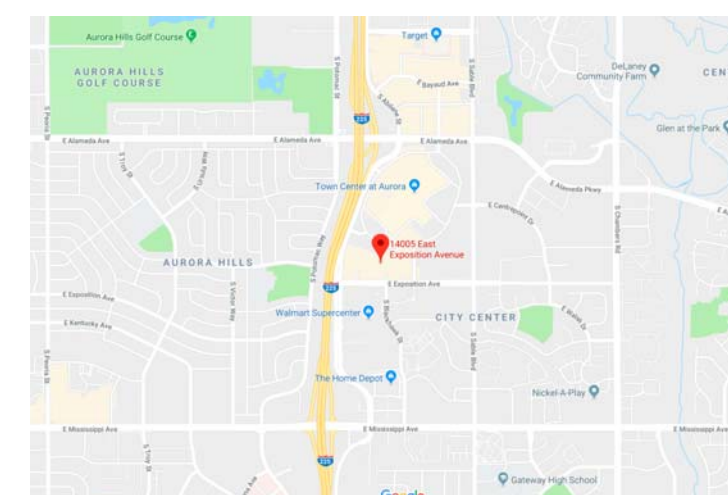

Vicinity map

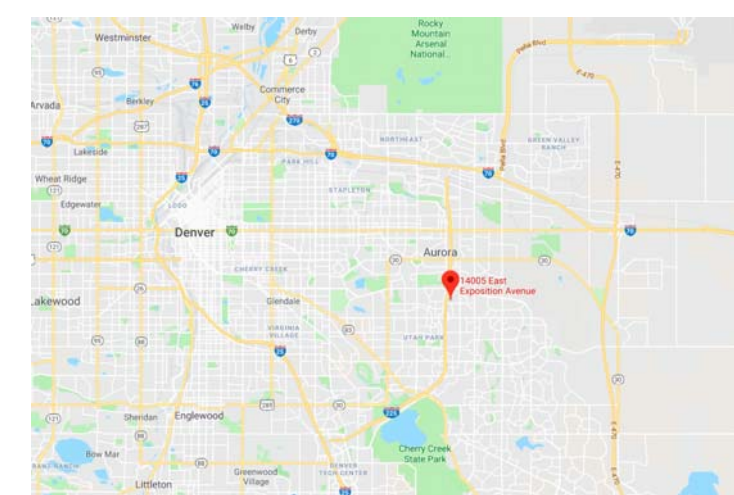

Location map

RSN: 1369378
Permit #: 19-1625136



710

14005 E Exposition Ave.
Aurora, CO 80012

Owner:
CEC ENTERTAINMENT, INC.
Irving, TX 77063
ph: 972.258.5521
Contact: Walter Boyd
wboyd@cecentertainment.com

Architect:
PKWY Architects, LLC
1000 Civic Circle
Lewisville, TX 75067
Ph: 213.122.1222
Contact: Greg Klimko

MEP Engineer:
Dialectic Engineering
310 W. 20th Street
200 Kansas City, MO 64108
ph: 816.997.9627
Contact: Joe Hillebrenner, P.E.



Architect: William D. Pounds

1	City Comments	5/22/19
A	Permit Set	5/13/19
No.	Description	Date

DRAWN BY: RM/VG
CHECKED BY: DD
PROJ. NO: 08-19413
Copyright Parkway C&A, LP 2019 ©

Cover Sheet

CS1.0



City of Aurora Building Division
Reviewed for Code Compliance
Approved as Noted: **Erick B.**
Date: **Jun 21, 2019**
2015 INTERNATIONAL CODES & 2017 NEC

301 General
301.1 Scope. The provisions of Chapter 3 shall apply where required by Chapter 2 or where referenced by a requirement in this document.

302 Floor or Ground Surfaces
Figure 302.2 Carpet Pile Height

302.3 Openings. Openings in floor or ground surfaces shall not allow passage of a sphere more than 1/2 inch (13 mm) diameter except as allowed in 407.4.3, 409.4.3, 410.4, 810.5.3 and 810.10. Elongated openings shall be placed so that the long dimension is perpendicular to the dominant direction of travel.

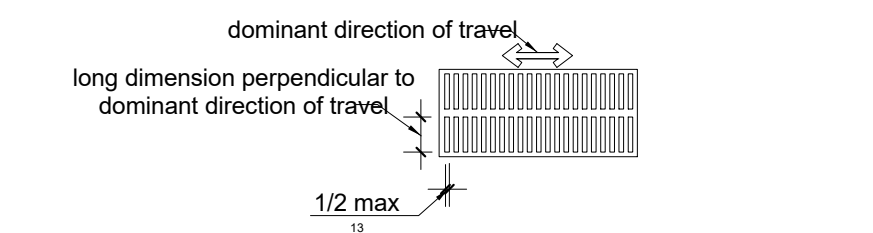


Figure 302.3 Elongated Openings in Floor or Ground Surfaces

303 Changes in Level
303.1 General. Where changes in level are permitted in floor or ground surfaces, they shall comply with 303.

EXCEPTIONS:
1. Animal containment areas shall not be required to comply with 303.
2. Areas of sport activity shall not be required to comply with 303.
303.2 Vertical. Changes in level of 1/4 inch (6.4 mm) high maximum shall be permitted to be vertical.



Figure 303.2 Vertical Change in Level

303.3 Beveled. Changes in level between 1/4 inch (6.4 mm) high minimum and 1/2 inch (13 mm) high maximum shall be beveled with a slope not steeper than 1:2.

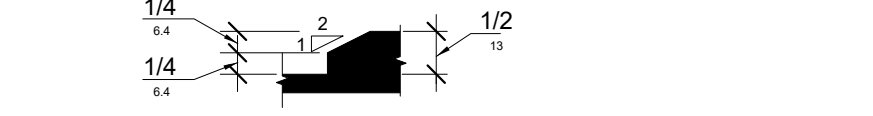


Figure 303.3 Beveled Change in Level

303.4 Ramps. Changes in level greater than 1/2 inch (13 mm) high shall be ramped, and shall comply with 405 or 406.

304 Turning Space
304.1 General. Turning space shall comply with 304.

304.3 Size. Turning space shall comply with 304.3.1 or 304.3.2.

304.3.1 Circular Space. The turning space shall be a space of 60 inches (1525 mm) diameter minimum. The space shall be permitted to include knee and toe clearance complying with 306.

304.3.2 T-Shaped Space. The turning space shall be a T-shaped space within a 60 inch (1525 mm) square minimum with arms and base 36 inches (915 mm) wide minimum. Each arm of the T shall be clear of obstructions 12 inches (305 mm) minimum in each direction and the base shall be clear of obstructions 24 inches (610 mm) minimum. The space shall be permitted to include knee and toe clearance complying with 306 only at the end of either the base or one arm.

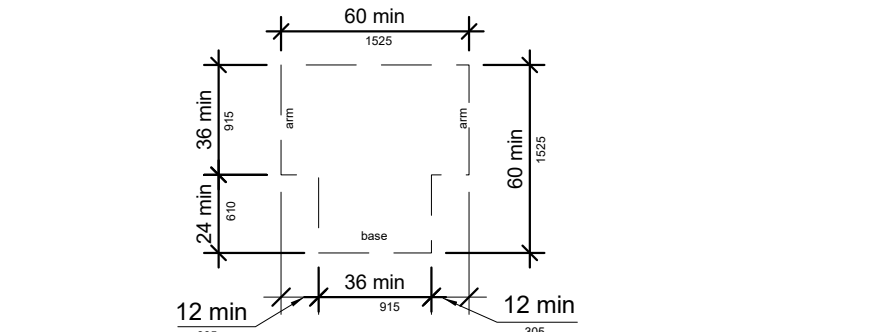


Figure 304.3.2 T-Shaped Turning Space

304.4 Door Swing. Doors shall be permitted to swing into turning spaces.

305 Clear Floor or Ground Space
305.1 General. Clear floor or ground space shall comply with 305.

305.2 Floor or Ground Surfaces. Floor or ground surfaces of a clear floor or ground space shall comply with 302. Changes in level are not permitted.

EXCEPTION: Slopes not steeper than 1:48 shall be permitted.

305.3 Size. The clear floor or ground space shall be 30 inches (760 mm) minimum by 48 inches (1220 mm) minimum.

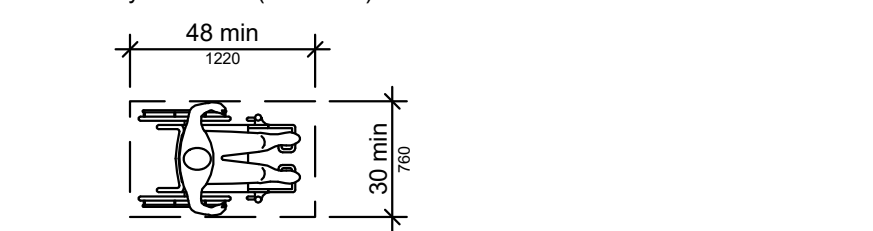


Figure 305.3 Clear Floor or Ground Space

305.4 Knee and Toe Clearance. Unless otherwise specified, clear floor or ground space shall be permitted to include knee and toe clearance complying with 306.

305.5 Position. Unless otherwise specified, clear floor or ground space shall be positioned for either forward or parallel approach to an element.

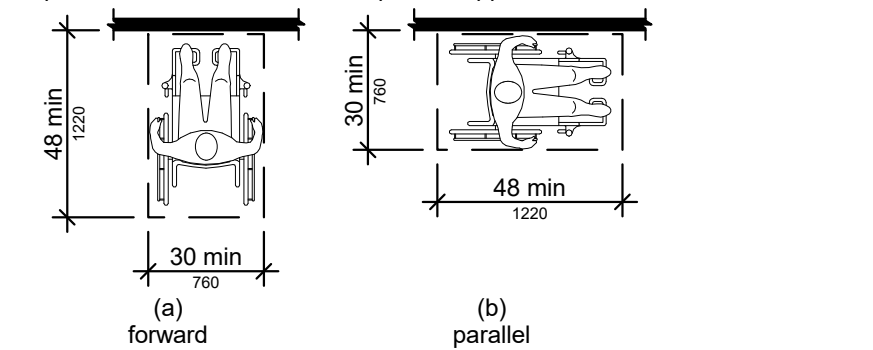


Figure 305.5 Position of Clear Floor or Ground Space

305.6 Approach. One full unobstructed side of the clear floor or ground space shall adjoin an accessible route or adjoin another clear floor or ground space.

305.7 Maneuvering Clearance. Where a clear floor or ground space is located in an alcove or otherwise confined on all or part of three sides, additional maneuvering clearance shall be provided in accordance with 305.7.1 and 305.7.2.

306 Knee and Toe Clearance
306.1 General. Where space beneath an element is included as part of clear floor or ground space, the space shall comply with 306. Additional space shall not be prohibited beneath an element but shall not be considered as part of the clear floor or ground space or turning space.

306.2 Toe Clearance.
306.2.1 General. Space under an element between the finish floor or ground and 9 inches (230mm) above the finish floor or ground shall be considered toe clearance and shall comply with 306.2.

306.2.2 Maximum Depth. Toe clearance shall extend 25 inches (635 mm) maximum under an element.

306.2.3 Minimum Required Depth. Where toe clearance is required at an element as part of a clear floor space, the toe clearance shall extend 17 inches (430 mm) minimum under the element.

306.2.4 Additional Clearance. Space extending greater than 6 inches (150 mm) beyond the available at 9 inches (230 mm) above the finish floor or ground shall not be considered toe clearance.

306.2.5 Width. Toe clearance shall be 30 inches (760 mm) wide minimum.

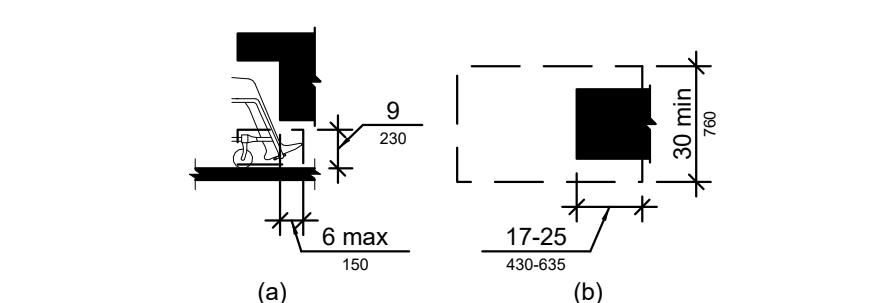


Figure 306.2 Toe Clearance

306.3 Knee Clearance.
306.3.1 General. Space under an element between 9 inches (230 mm) and 27 inches (685 mm) above the finish floor or ground shall be considered knee clearance and shall comply with 306.3.

306.3.2 Maximum Depth. Knee clearance shall extend 25 inches (635 mm) maximum under an element at 9 inches (230 mm) above the finish floor or ground.

306.3.3 Minimum Required Depth. Where knee clearance is required under an element as part of a clear floor space, the knee clearance shall be 11 inches (280 mm) deep minimum at 9 inches (230 mm) above the finish floor or ground, and 8 inches (205 mm) deep minimum at 27 inches (685 mm) above the finish floor or ground.

306.3.4 Clearance Reduction. Between 9 inches (230 mm) and 27 inches (685 mm) above the finish floor or ground, the knee clearance shall be permitted to reduce at a rate of 1 inch (25 mm) in depth for each 6 inches (150 mm) in height.

306.3.5 Width. Knee clearance shall be 30 inches (760 mm) wide minimum.

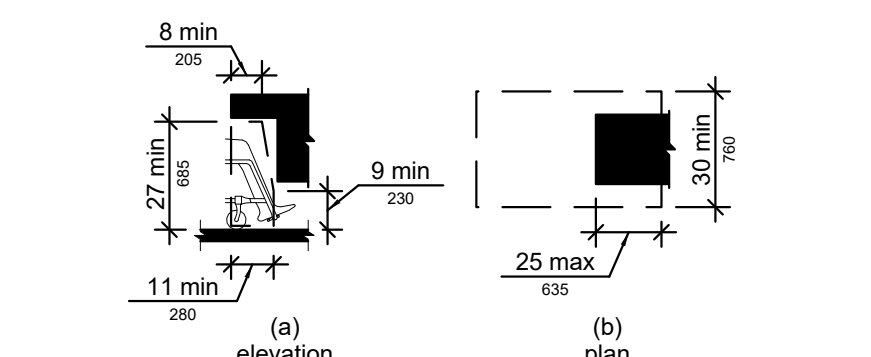


Figure 306.3 Knee Clearance

404 Doors, Doorways, and Gates
404.1 General. Doors, doorways, and gates that are part of an accessible route shall comply with 404.

EXCEPTION: Doors, doorways, and gates designed to be operated only by security personnel shall not be required to comply with 404.2.7, 404.2.8, 404.2.9, 404.3.2 and 404.3.4 through 404.3.7.

404.2.4 Maneuvering Clearances. Minimum maneuvering clearances at doors and gates shall comply with 404.2.4. Maneuvering clearances shall extend the full width of the doorway and the required latch side or hinge side clearance.

EXCEPTION: Entry doors to hospital patient rooms shall not be required to provide the clearance beyond the latch side of the door.

404.2.4.1 Swinging Doors and Gates. Swinging doors and gates shall have maneuvering clearances complying with Table 404.2.4.1.

Type of Use	Minimum Maneuvering Clearance
Approach Direction	Door or Gate Side
Approach Direction	Perpendicular to Doorway
Approach Direction	Parallel to Doorway (beyond latch side unless noted)
From front	Pull 60 inches (1525 mm)
From front	Push 48 inches (1220 mm)
From hinge side	Pull 60 inches (1525 mm)
From hinge side	Push 54 inches (1370 mm)
From hinge side	Pull 42 inches (1065 mm)
From hinge side	Push 42 inches (1065 mm)
From latch side	Pull 48 inches (1220 mm)
From latch side	Push 42 inches (1065 mm)

1. Add 12 inches (305 mm) if closer and latch are provided.
2. Add 6 inches (150 mm) if closer and latch are provided.
3. Beyond hinge side.
4. Add 6 inches (150 mm) if closer is provided.

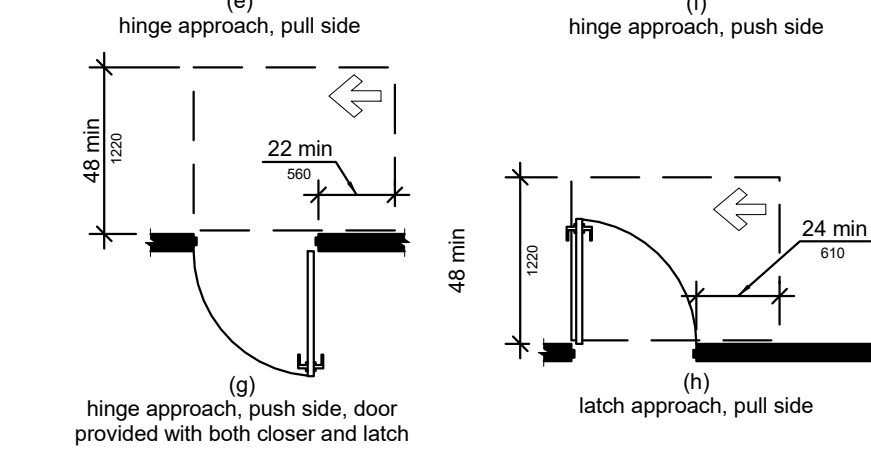
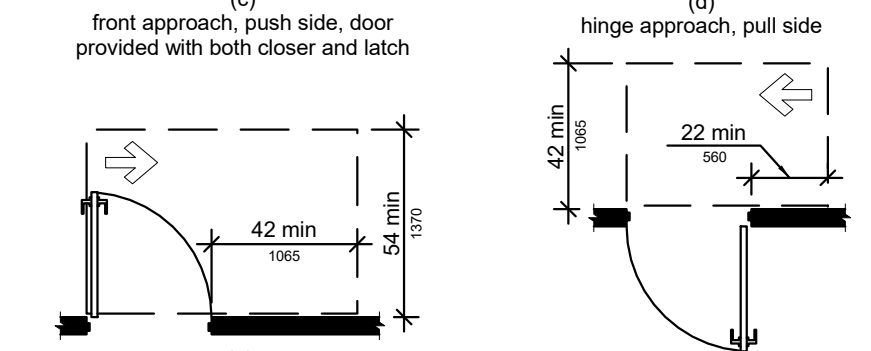
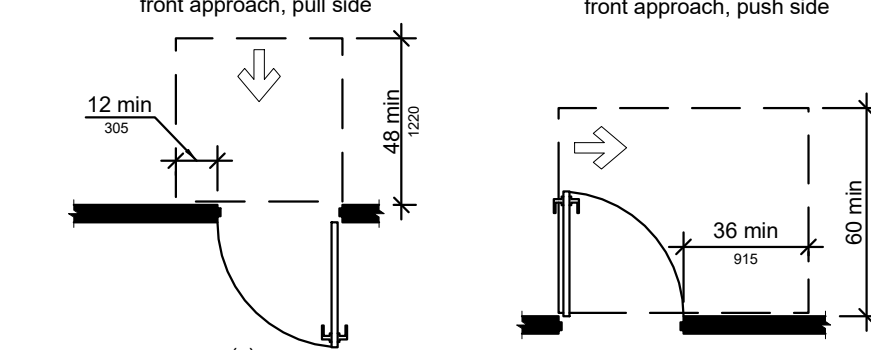
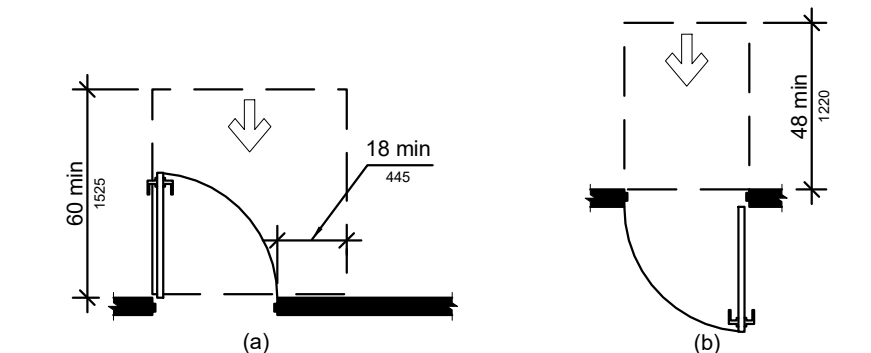


Figure 404.2.4.1 Maneuvering Clearances at Manual Swinging Doors and Gates

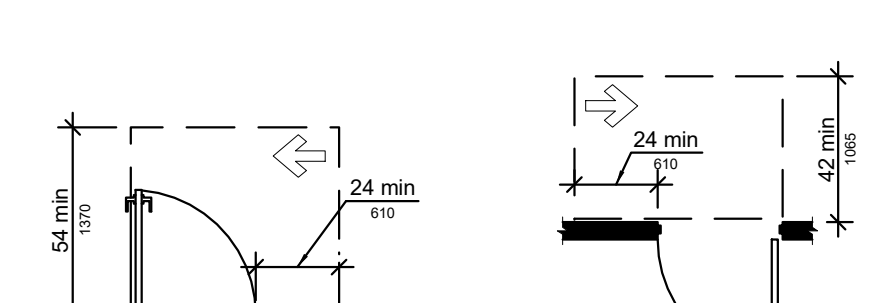


Figure 404.2.4.1 Maneuvering Clearances at Manual Swinging Doors and Gates

404.2.4.3 Recessed Doors and Gates. Maneuvering clearances for forward approach shall be provided when any obstruction within 18 inches (455 mm) of the latch side of a doorway projects more than 8 inches (205 mm) beyond the face of the door, measured perpendicular to the face of the door or gate.

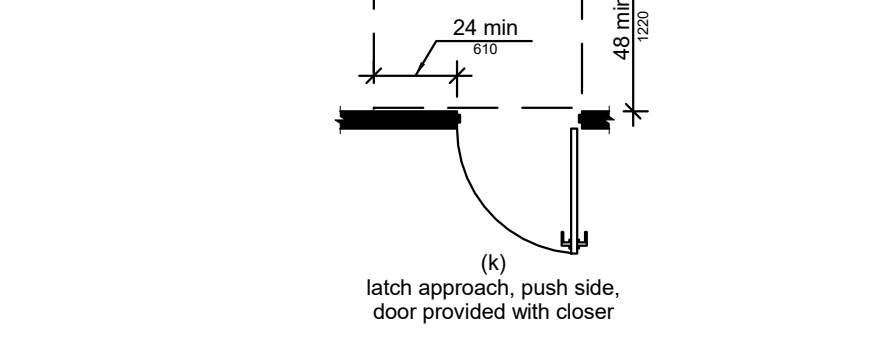


Figure 404.2.4.3 Recessed Doors and Gates

404.3.1 Clear Width. Doorways shall provide a clear opening of 32 inches (815 mm) minimum in power-on and power-off mode. The minimum clear width for automatic door systems in a doorway shall be based on the clear opening provided by all leaves in the open position.

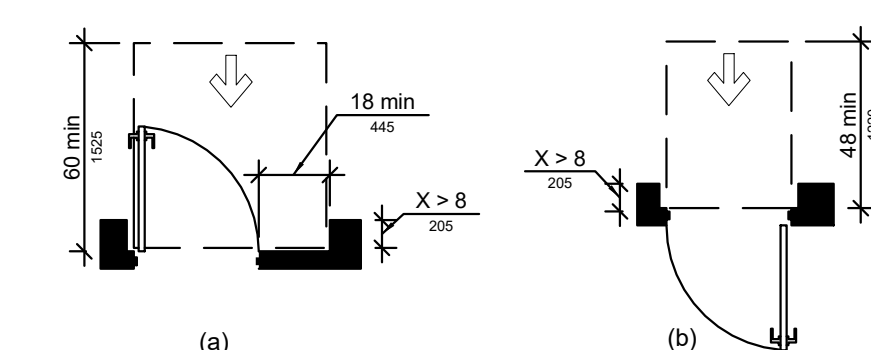


Figure 404.3.1 Clear Width

404.3.2 Maneuvering Clearance. Clearances at power-assisted doors and gates shall comply with 404.2.4. Clearances at automatic doors and gates without standby power and serving an accessible means of egress shall comply with 404.2.4.

EXCEPTION: Where automatic doors and gates remain open in the power-off condition, compliance with 404.2.4 shall not be required.

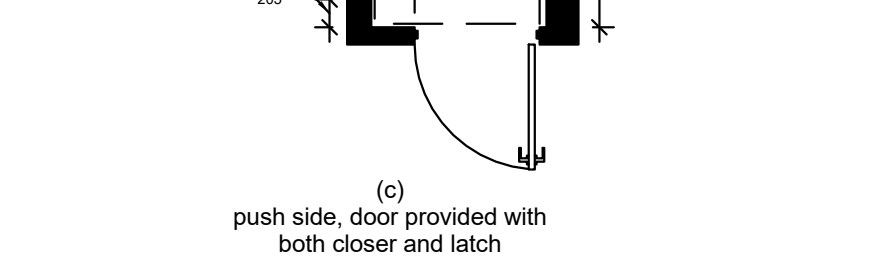


Figure 404.3.2 Maneuvering Clearance

404.3.3 Thresholds. Thresholds and changes in level at doorways shall comply with 404.2.5.

EXCEPTION: Where automatic doors and gates remain open in the power-off condition, compliance with 404.2.5 shall not be required.

404.3.4 Doors in Series and Gates in Series. Doors in series and gates in series shall comply with 404.2.6.

404.3.5 Controls. Manually operated controls shall comply with 309. The clear floor space adjacent to the control shall be located beyond the arc of the door swing.

404.3.6 Break Out Opening. Where doors and gates without standby power are a part of a means of egress, the clear break out opening at swinging or sliding doors and gates shall be 32 inches (815mm) minimum when operated in emergency mode.

EXCEPTION: Where manual swinging doors and gates comply with 404.2 and serve the same means of egress compliance with 404.3.6 shall not be required.

404.3.7 Revolving Doors, Revolving Gates, and Turnstiles. Revolving doors, revolving gates, and turnstiles shall not be part of an accessible route.

405 Ramps
405.1 General. Ramps on accessible routes shall comply with 405.

EXCEPTION: In assembly areas, aisle ramps adjacent to seating and not serving elements required to be on an accessible route shall not be required to comply with 405.

405.2 Slope. Ramp runs shall have a running slope not steeper than 1:12.

EXCEPTION: In existing sites, buildings, and facilities, ramps shall be permitted to have running slopes steeper than 1:12 complying with Table 405.2 where such slopes are necessary due to space limitations.

405.3 Cross Slope. Cross slope of ramp runs shall not be steeper than 1:48.

405.4 Floor or Ground Surfaces. Floor or ground surfaces of ramp runs shall comply with 302. Changes in level other than the running slope and cross slope are not permitted on ramp runs.

405.5 Clear Width. The clear width of a ramp run and, where handrails are provided, the clear width between handrails shall be 36 inches (915 mm) minimum.

EXCEPTION: Within employee work areas, the required clear width of ramps that are a part of common use circulation paths shall be permitted to be decreased by work area equipment provided that the decrease is essential to the function of the work being performed.

405.6 Rise. The rise for any ramp run shall be 30 inches (760 mm) maximum.

405.7 Landings. Ramps shall have landings at the top and the bottom of each ramp run. Landings shall comply with 405.7.

405.8 Handrails. Ramp runs with a rise greater than 6 inches (150 mm) shall have handrails complying with 505.

EXCEPTION: Within employee work areas, handrails shall not be required where ramps that are part of common use circulation paths are designed to prevent the installation of handrails complying with 505. Ramps not subject to the exception to 405.5 shall be designed to maintain a 36 inch (915mm) minimum clear width when handrails are installed.

405.9 Edge Protection. Edge protection complying with 405.9.1 or 405.9.2 shall be provided on each side of ramp runs and at each side of ramp landings.

EXCEPTIONS:
1. Edge protection shall not be required on ramps that are not required to have handrails and have sides complying with 406.3.
2. Edge protection shall not be required on the sides of ramp landings serving an adjoining ramp run or stairway.
3. Edge protection shall not be required on the sides of ramp landings having a vertical drop-off of 1/2 inch (13 mm) maximum within 10 inches (255 mm) horizontally of the min. landing area specified in 405.7.

405.9.1 Extended Floor or Ground Surface. The floor or ground surface of the ramp run or landing shall extend 12 inches (305 mm) minimum beyond the inside face of a handrail complying with 505.

405.9.2 Curbs or Barrier. A curb or barrier shall be provided that prevents the passage of a 4 inch (100 mm) diameter sphere, where any portion of the sphere is within 4 inches (100 mm) of the finish floor or ground surface.

405.9.3 Extended Floor or Ground Surface Edge Protection

405.9.4 Curbs or Barrier. A curb or barrier shall be provided that prevents the passage of a 4 inch (100 mm) diameter sphere, where any portion of the sphere is within 4 inches (100 mm) of the finish floor or ground surface.

405.9.5 Extended Floor or Ground Surface Edge Protection

405.9.6 Curbs or Barrier. A curb or barrier shall be provided that prevents the passage of a 4 inch (100 mm) diameter sphere, where any portion of the sphere is within 4 inches (100 mm) of the finish floor or ground surface.

405.9.7 Extended Floor or Ground Surface Edge Protection

405.9.8 Curbs or Barrier. A curb or barrier shall be provided that prevents the passage of a 4 inch (100 mm) diameter sphere, where any portion of the sphere is within 4 inches (100 mm) of the finish floor or ground surface.

405.9.9 Extended Floor or Ground Surface Edge Protection

405.9.10 Curbs or Barrier. A curb or barrier shall be provided that prevents the passage of a 4 inch (100 mm) diameter sphere, where any portion of the sphere is within 4 inches (100 mm) of the finish floor or ground surface.

404.2.10 Door and Gate Surfaces. Swinging door and gate surfaces within 10 inches (255 mm) of the finish floor or ground measured vertically shall have a smooth surface on the push side extending the full width of the door or gate. Parts creating horizontal or vertical joints in these surfaces shall be within 1/16 inch (1.6 mm) of the same plane as the other. Cavities created by added kick plates shall be capped.

EXCEPTIONS:
1. Sliding doors shall not be required to comply with 404.2.10.
2. Tempered glass doors without stiles and having a bottom rail or shoe with the top leading edge tapered at 60 degrees minimum from the horizontal shall not be required to meet the 10 inch (255mm) bottom smooth surface height requirement.
3. Doors and gates that do not extend to within 10 inches (255 mm) of the finish floor or ground shall not be required to comply with 404.2.10.
4. Existing doors and gates without smooth surfaces within 10 inches (255 mm) of the finish floor or ground shall not be required to provide smooth surfaces complying with 404.2.10 provided that if added kick plates are installed, cavities created by such kick plates are capped.

404.2.11 Vision Lights. Doors, gates, and side lights adjacent to doors or gates, containing one or more glazing panels that permit viewing through the panels shall have the bottom of at least one glazed panel located 43 inches (1092 mm) above the finish floor.

EXCEPTION: Vision lights with the top part more than 66 inches (1675 mm) from the finish floor or ground shall not be required to comply with 404.2.11.

404.3 Automatic and Power-Assisted Doors and Gates. Automatic doors and automatic gates shall comply with 404.3. Full-powered automatic doors shall comply with ANSI/BHMA A156.10 (incorporated by reference, see "Referenced Standards" in Chapter 1). Low-energy and power assisted doors shall comply with ANSI/BHMA A156.19 (1997 or 2002 edition) (incorporated by reference, see "Referenced Standards" in Chapter 1).

404.3.1 Clear Width. Doorways shall provide a clear opening of 32 inches (815 mm) minimum in power-on and power-off mode. The minimum clear width for automatic door systems in a doorway shall be based on the clear opening provided by all leaves in the open position.

404.3.2 Maneuvering Clearance. Clearances at power-assisted doors and gates shall comply with 404.2.4. Clearances at automatic doors and gates without standby power and serving an accessible means of egress shall comply with 404.2.4.

EXCEPTION: Where automatic doors and gates remain open in the power-off condition, compliance with 404.2.4 shall not be required.

404.3.3 Thresholds. Thresholds and changes in level at doorways shall comply with 404.2.5.

404.3.4 Doors in Series and Gates in Series. Doors in series and gates in series shall comply with 404.2.6.

404.3.5 Controls. Manually operated controls shall comply with 309. The clear floor space adjacent to the control shall be located beyond the arc of the door swing.

404.3.6 Break Out Opening. Where doors and gates without standby power are a part of a means of egress, the clear break out opening at swinging or sliding doors and gates shall be 32 inches (815mm) minimum when operated in emergency mode.

EXCEPTION: Where manual swinging doors and gates comply with 404.2 and serve the same means of egress compliance with 404.3.6 shall not be required.

404.3.7 Revolving Doors, Revolving Gates, and Turnstiles. Revolving doors, revolving gates, and turnstiles shall not be part of an accessible route.

405 Ramps
405.1 General. Ramps on accessible routes shall comply with 405.

EXCEPTION: In assembly areas, aisle ramps adjacent to seating and not serving elements required to be on an accessible route shall not be required to comply with 405.

405.2 Slope. Ramp runs shall have a running slope not steeper than 1:12.

EXCEPTION: In existing sites, buildings, and facilities, ramps shall be permitted to have running slopes steeper than 1:12 complying with Table 405.2 where such slopes are necessary due to space limitations.

405.3 Cross Slope. Cross slope of ramp runs shall not be steeper than 1:48.

405.4 Floor or Ground Surfaces. Floor or ground surfaces of ramp runs shall comply with 302. Changes in level other than the running slope and cross slope are not permitted on ramp runs.

405.5 Clear Width. The clear width of a ramp run and, where handrails are provided, the clear width between handrails shall be 36 inches (915 mm) minimum.

EXCEPTION: Within employee work areas, the required clear width of ramps that are a part of common use circulation paths shall be permitted to be decreased by work area equipment provided that the decrease is essential to the function of the work being performed.

405.6 Rise. The rise for any ramp run shall be 30 inches (760 mm) maximum.

405.7 Landings. Ramps shall have landings at the top and the bottom of each ramp run. Landings shall comply with 405.7.

405.8 Handrails. Ramp runs with a rise greater than 6 inches (150 mm) shall have handrails complying with 505.

EXCEPTION: Within employee work areas, handrails shall not be required where ramps that are part of common use circulation paths are designed to prevent the installation of handrails complying with 505. Ramps not subject to the exception to 405.5 shall be designed to maintain a 36 inch (915mm) minimum clear width when handrails are installed.

405.9 Edge Protection. Edge protection complying with 405.9.1 or 405.9.2 shall be provided on each side of ramp runs and at each side of ramp landings.

EXCEPTIONS:
1. Edge protection shall not be required on ramps that are not required to have handrails and have sides complying with 406.3.
2. Edge protection shall not be required on the sides of ramp landings serving an adjoining ramp run or stairway.
3. Edge protection shall not be required on the sides of ramp landings having a vertical drop-off of 1/2 inch (13 mm) maximum within 10 inches (255 mm) horizontally of the min. landing area specified in 405.7.

405.9.1 Extended Floor or Ground Surface. The floor or ground surface of the ramp run or landing shall extend 12 inches (305 mm) minimum beyond the inside face of a handrail complying with 505.

405.9.2 Curbs or Barrier. A curb or barrier shall be provided that prevents the passage of a 4 inch (100 mm) diameter sphere, where any portion of the sphere is within 4 inches (100 mm) of the finish floor or ground surface.

405.9.3 Extended Floor or Ground Surface Edge Protection

405.9.4 Curbs or Barrier. A curb or barrier shall be provided that prevents the passage of a 4 inch (100 mm) diameter sphere, where any portion of the sphere is within 4 inches (100 mm) of the finish floor or ground surface.

405.9.5 Extended Floor or Ground Surface Edge Protection

405.9.6 Curbs or Barrier. A curb or barrier shall be provided that prevents the passage of a 4 inch (100 mm) diameter sphere, where any portion of the sphere is within 4 inches (100 mm) of the finish floor or ground surface.

405.9.7 Extended Floor or Ground Surface Edge Protection

405.9.8 Curbs or Barrier. A curb or barrier shall be provided that prevents the passage of a 4 inch (100 mm) diameter sphere, where any portion of the sphere is within 4 inches (100 mm) of the finish floor or ground surface.

405.9.9 Extended Floor or Ground Surface Edge Protection

405.9.10 Curbs or Barrier. A curb or barrier shall be provided that prevents the passage of a 4 inch (100 mm) diameter sphere, where any portion of the sphere is within 4 inches (100 mm) of the finish floor or ground surface.

405.9.11 Extended Floor or Ground Surface Edge Protection

405.9.12 Curbs or Barrier. A curb or barrier shall be provided that prevents the passage of a 4 inch (100 mm) diameter sphere, where any portion of the sphere is within 4 inches (100 mm) of the finish floor or ground surface.

405.9.13 Extended Floor or Ground Surface Edge Protection

405.9.14 Curbs or Barrier. A curb or barrier shall be provided that prevents the passage of a 4 inch (100 mm) diameter sphere, where any portion of the sphere is within 4 inches (100 mm) of the finish floor or ground surface.

405.9.15 Extended Floor or Ground Surface Edge Protection

405.9.16 Curbs or Barrier. A curb or barrier shall be provided that prevents the passage of a 4 inch (100 mm) diameter sphere, where any portion of the sphere is within 4 inches (100 mm) of the finish floor or ground surface.

405.9.17 Extended Floor or Ground Surface Edge Protection

405.9.18 Curbs or Barrier. A curb or barrier shall be provided that prevents the passage of a 4 inch (100 mm) diameter sphere, where any portion of the sphere is within 4 inches (100 mm) of the finish floor or ground surface.

405.9.19 Extended Floor or Ground Surface Edge Protection

405.9.20 Curbs or Barrier. A curb or barrier shall be provided that prevents the passage of a 4 inch (100 mm) diameter sphere, where any portion of the sphere is within 4 inches (100 mm) of the finish floor or ground surface.

405.9.21 Extended Floor or Ground Surface Edge Protection

405.9.22 Curbs or Barrier. A curb or barrier shall be provided that prevents the passage of a 4 inch (100 mm) diameter sphere, where any portion of the sphere is within 4 inches (100 mm) of the finish floor or ground surface.

405.9.23 Extended Floor or Ground Surface Edge Protection


405.9.24 Curbs or Barrier. A curb or barrier shall be provided that prevents the passage of a 4 inch (100 mm) diameter sphere, where any portion of the sphere is within 4 inches (100 mm) of the finish floor or ground surface.

405.9.25 Extended Floor or Ground Surface Edge Protection

405.9.26 Curbs or Barrier. A curb or barrier shall be provided that prevents the passage of a 4 inch (100 mm) diameter sphere, where any portion of the sphere is within 4 inches (100 mm) of the finish floor or ground surface.

405.2 Slope. Ramp runs shall have a running slope not steeper than 1:12.

EXCEPTION: In existing sites, buildings, and facilities, ramps shall be permitted to have running slopes steeper than 1:12 complying with Table 405.2 where such slopes are necessary due to space limitations.

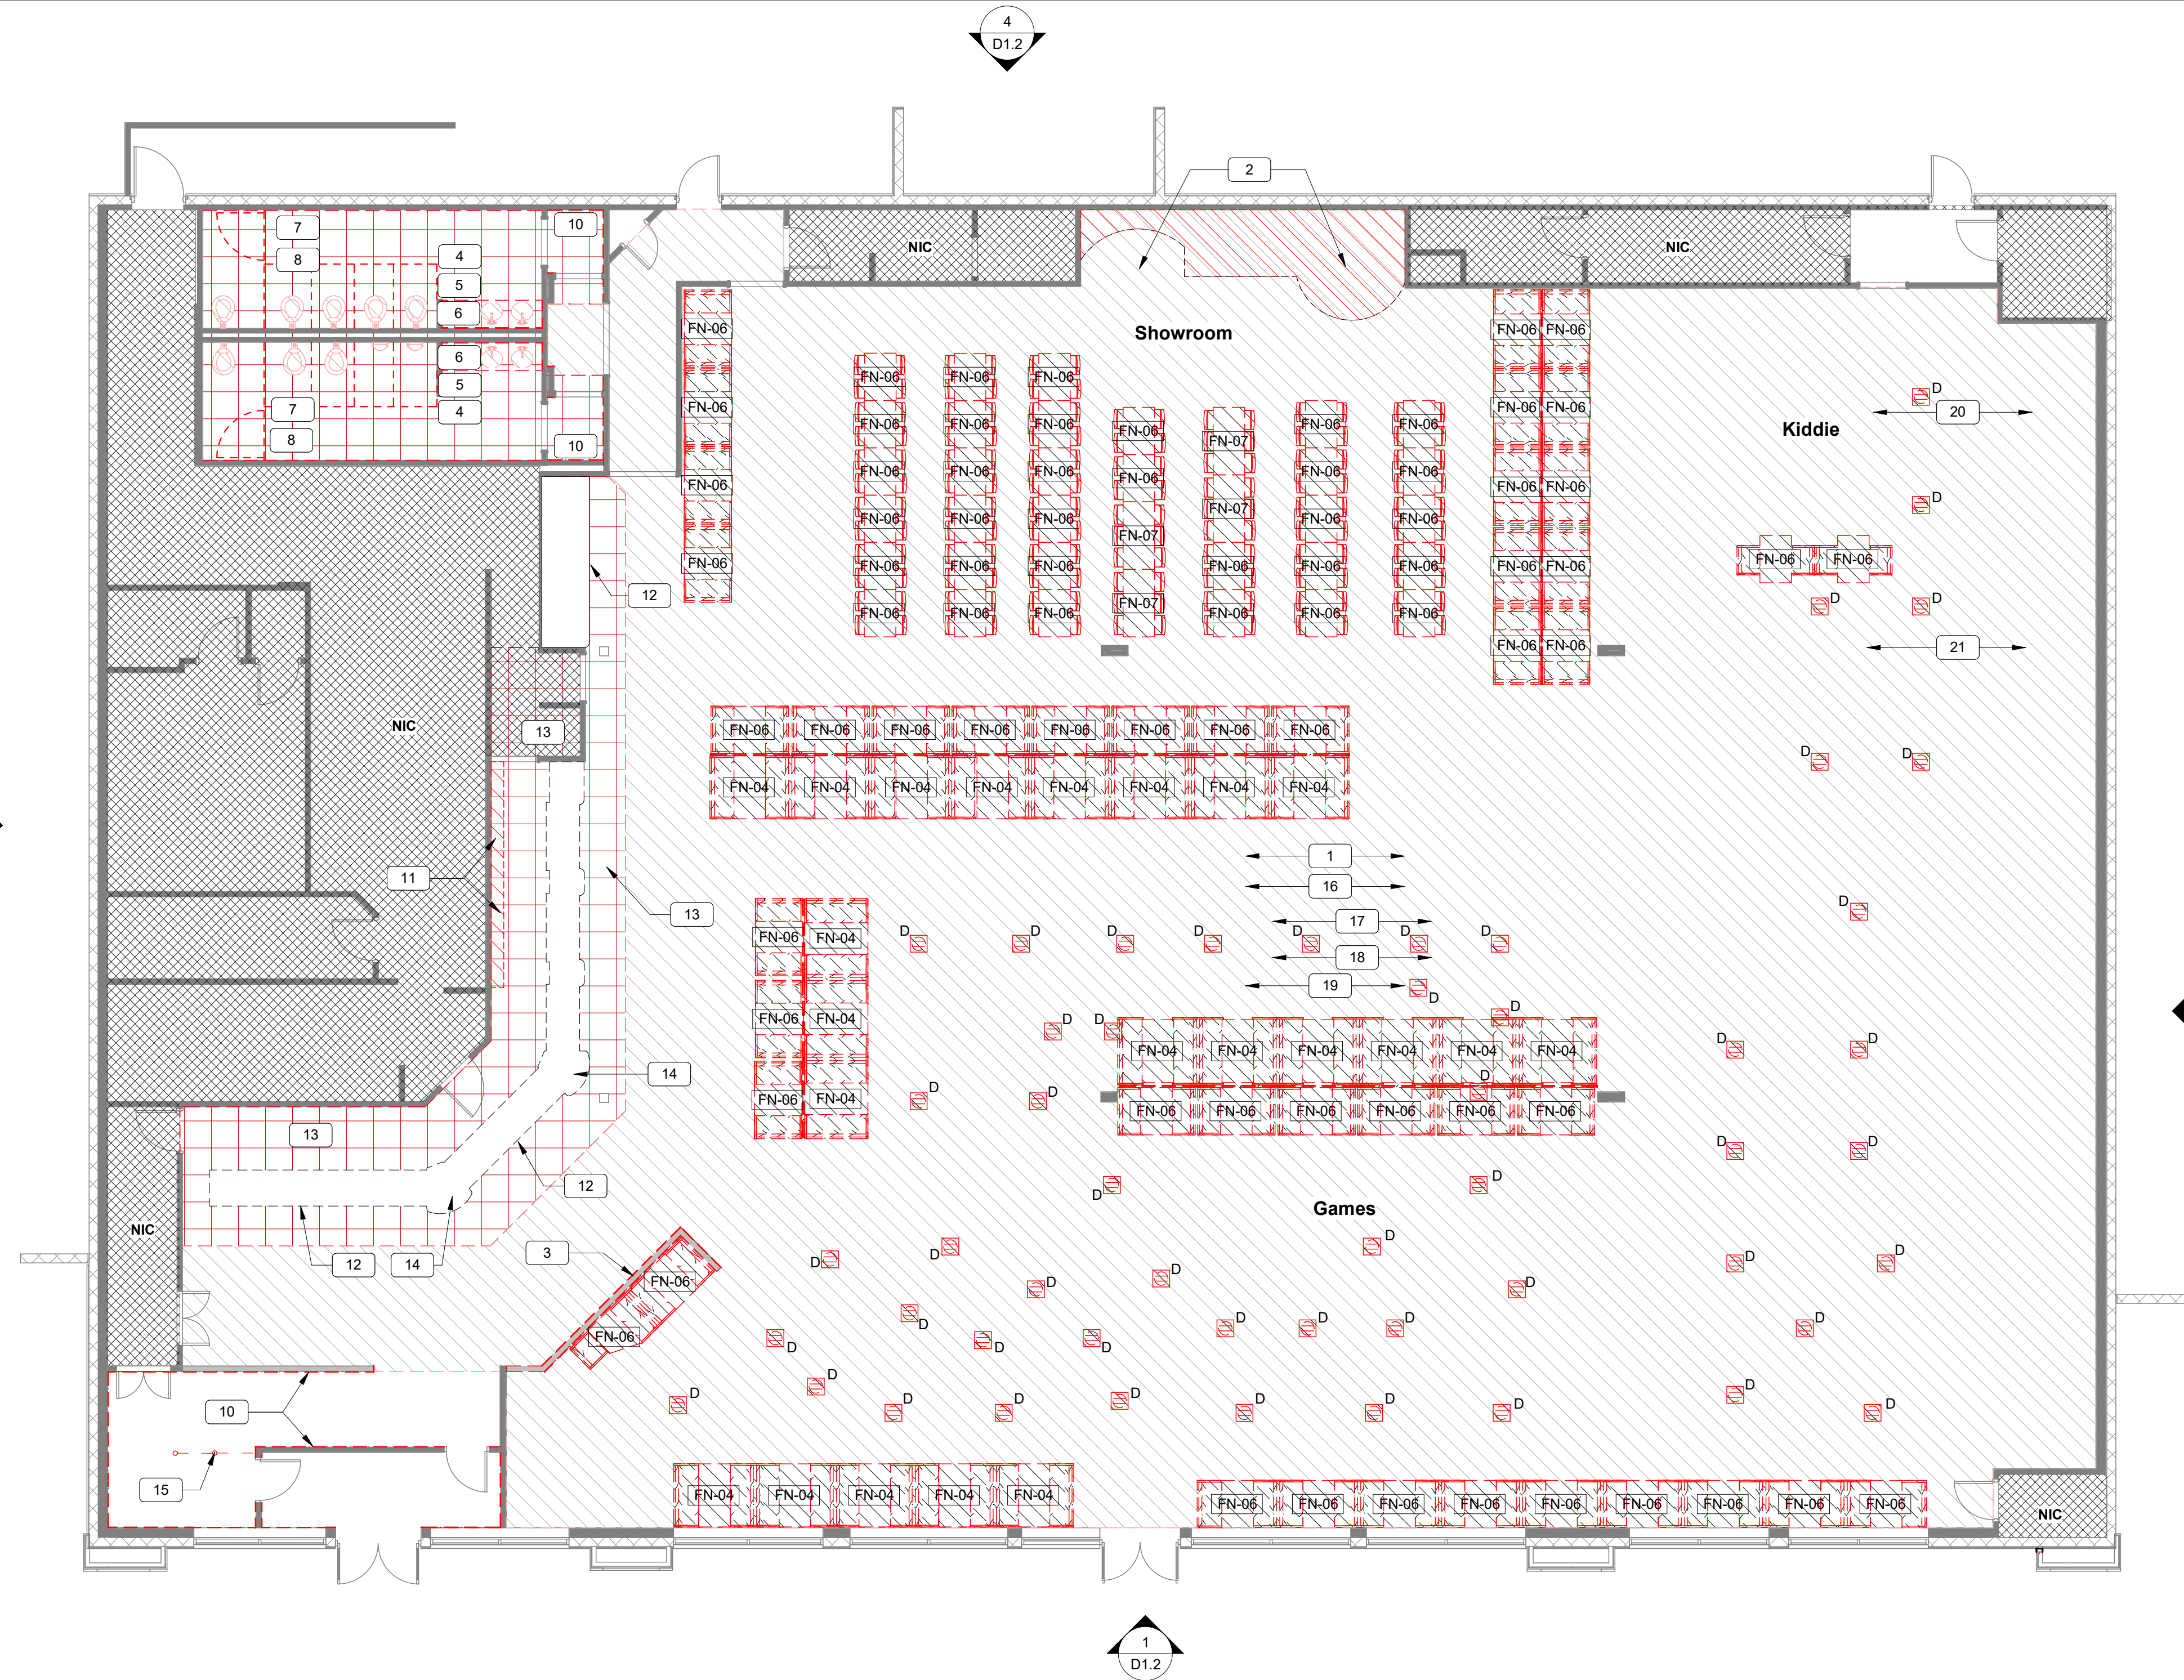

1 Floor Plan
1/8" = 1'-0"
TRUE NORTH

Code violations that are found during inspection are required to be corrected. Permit issuance does not grant approval of a code violation.

Field Inspection consultation is available upon request. Call 303-739-7420 to request a consultation

General Notes - Demolition

Key #	Demolition Notes
A	Existing conditions are based on field observations. The demolition plan is for reference only. Contractor to verify existing conditions prior to the start of work.
B	Demolish indicated structures and fixtures in an orderly and careful manner.
C	Provide temporary supports, shoring and bracing as required to protect existing structural items remaining in place. Verify and coordinate existing utilities to be removed and/or relocated.
D	Erect weatherproof closures for exterior openings created by demolition work.
E	Demolished items shall be removed from site and legally disposed of.
F	Protect existing landscape materials, appurtenances, and structures which are to remain.
G	Remove all floor finishes down to substrate.
H	Remove walls and structures down to surface which may be refinished.
J	Where the scope of work requires penetration of the existing slab, the GC shall verify existing slab's construction type. Do not saw cut concrete slab, core drill only. Where a slab on grade is to be found, the GC shall patch, repair and install reinforcing #5 x 18" dowels with 9" embedment @ 18" o.c. along perimeter of new work. GC to notify owner if a structural supported slab is to be found existing. Do not cut any portion of the slab's structural reinforcing. The GC & his sub-contractors shall maintain the integrity of the existing slab.
K	Disconnect, remove and cap designated MEP utilities and fixtures within demolition areas. Mark location of disconnected utilities.
L	Remove abandoned electric wiring to source of supply. Verify that abandoned wiring and equipment serves only abandoned facilities. Coordinate utility service outages with utility company. Cut conduit flush with or beneath walls and floors, and refinish surfaces.
M	When encountered, inform owner of presence of contaminated materials. Contaminated materials are to be removed by others. Verify that previously removed materials are acceptable prior to commencement of demolition work.

Legend - Demo Plan

---	Scope of Work	⌵	Door to be removed
NIC	Not In Contract	?	Key Note
[---]	Construction to be removed		
---	Existing wall to remain		

Demolition keyed notes

- Demolish existing Lights in pedestals
- Remove Studio C (robotics) and background
- Remove half Wall
- Remove all Plumbing Fixtures
- Remove all Accessories and partitions
- Remove Vanity countertop
- Remove all wall and floor tile, replace substrates as needed and paint wall
- Remove lighting fixtures
- Remove Marlite in vestibule & entry half area
- Remove existing merchandise cubbies cabinet
- Remove existing laminate at front countertop, salad bar and beverage bar and prepare for new mosaic FRP
- Remove existing floor tile and install Wood look FRP
- Remove existing electrical at countertop
- Remove Stanchions at kids check entry
- Demolish and secure Floor outlets (+/- 65 count) throughout Kiddies and Games room areas
- Demolish existing furniture salvage table bases for reuse, Showroom tables may can save.
- Demolish existing Carpet, throughout, include carpeted aux and storage rooms
- Demolish existing Decor
- Demolish existing Toddler zone
- Demolish existing Skytubes



710

14005 E Exposition Ave.
Aurora, CO 80012

Owner:
CEC ENTERTAINMENT, INC.
Irving, TX 77063
ph: 972.258.5521
Contact: Walter Boyd
wboyd@cecertainment.com

Architect:
PKWY Architects, LLC
1000 Civic Circle
Lewisville, TX 75067
Ph: 213.122.122
Contact: Greg Klimko

MEP Engineer:
Dialectic Engineering
310 W. 20 th street
200 kansas City, MO 64108
ph: 816.997.9627
Contact: Joe Hillsbrenner, P.E.



Architect: William D. Pounds

A	Permit Set	5/13/19
No.	Description	Date

DRAWN BY: RM/VG
CHECKED BY: DD
PROJ. NO: 08-19413
Copyright Parkway C&A, LP 2019 ©


Demolition Floor Plan



City of Aurora Building Division
Reviewed for Code Compliance
Approved as Noted: **Erick B.**
Date: Jun 21, 2019
2015 INTERNATIONAL CODES & 2017 NEC

RSN: 1369378
Permit #: 19-1625136

D1.0

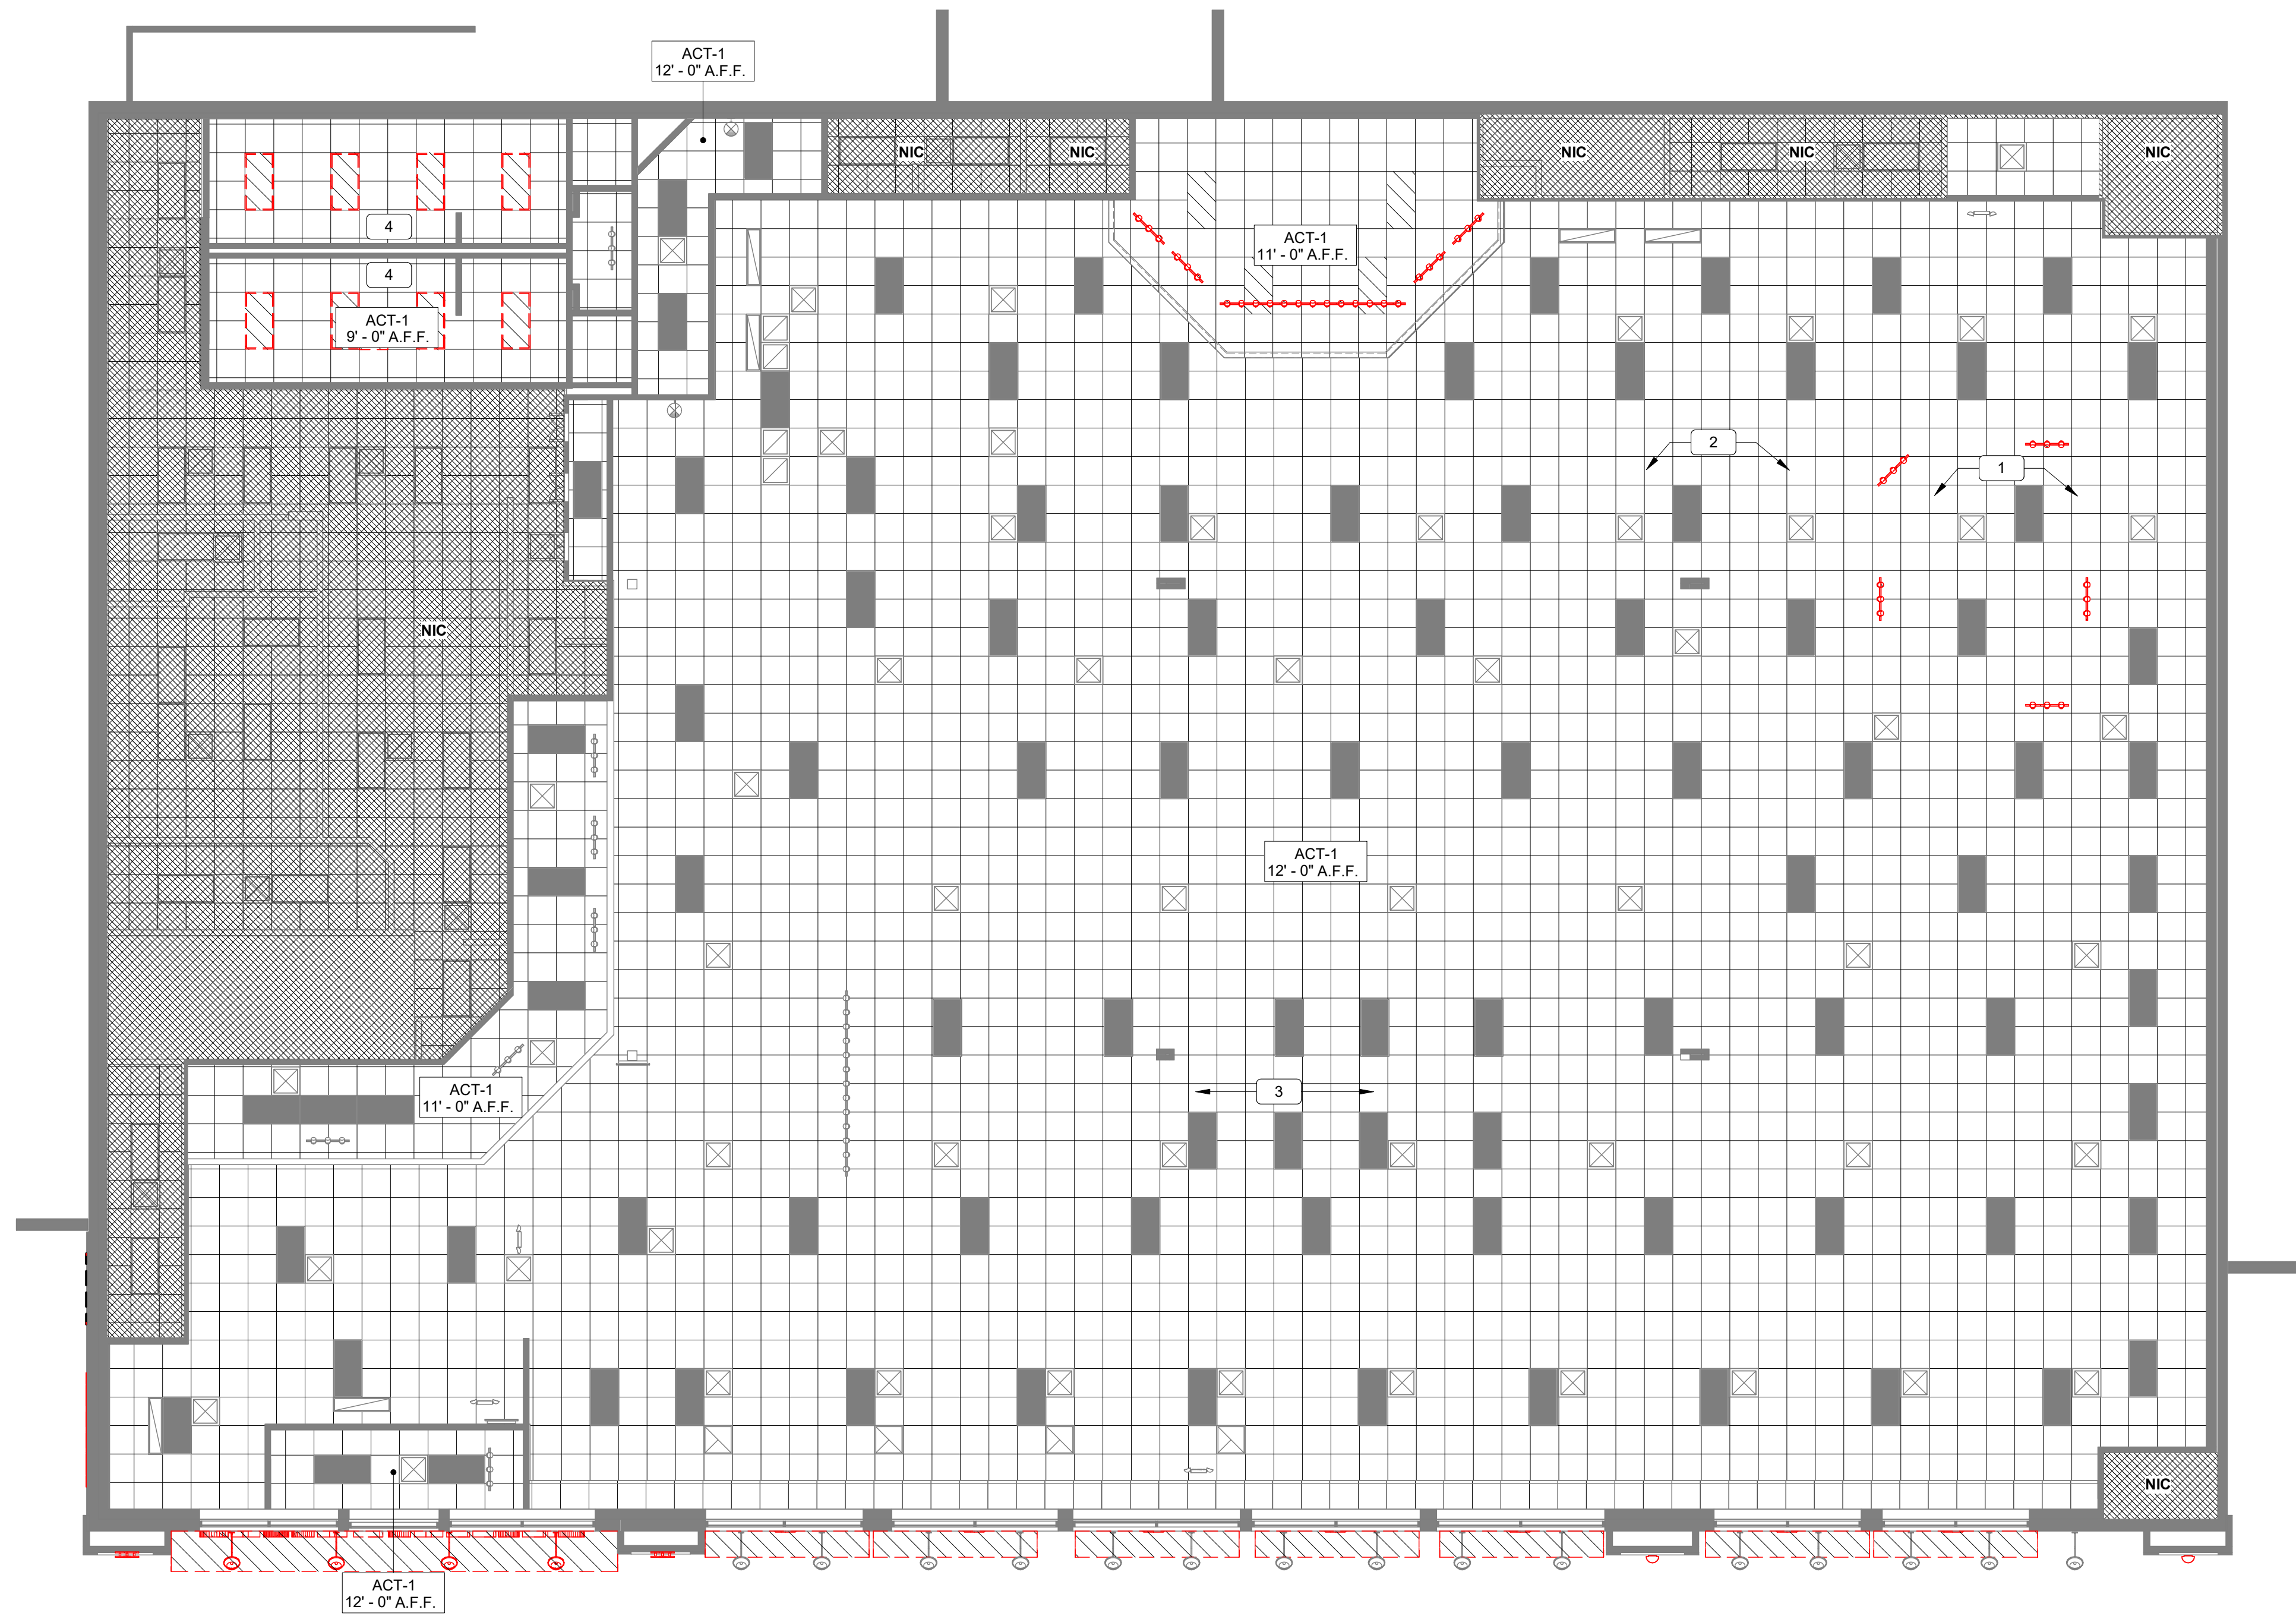

1 Demo Reflected Ceiling Plan

Provide a sign stating "EXIT" in raised, visual characters and braille adjacent to each door in an area of refuge, an exterior area for assisted rescue, an exit stairway or ramp, an exit passageway and the exit discharge.

2015 IBC 1013.4




General Notes - Demolition

Key #	Demolition Notes
A	Existing conditions are based on field observations. The demolition plan is for reference only. Contractor to verify existing conditions prior to the start of work.
B	Demolish indicated structures and fixtures in an orderly and careful manner.
C	Provide temporary supports, shoring and bracing as required to protect existing structural items remaining in place. Verify and coordinate existing utilities to be removed and/or relocated.
D	Erect weatherproof closures for exterior openings created by demolition work.
E	Demolished items shall be removed from site and legally disposed of.
F	Protect existing landscape materials, appurtenances, and structures which are to remain.
G	Remove all floor finishes down to substrate.
H	Remove walls and structures down to surface which may be refinished.
J	Where the scope of work requires penetration of the existing slab, the GC shall verify existing slab's construction type. Do not saw cut concrete slab, core drill only. Where a slab on grade is to be found, the GC shall patch, repair and install reinforcing #3 x 18" supported with 9" embedment @ 18" o.c. along perimeter of new work. GC to notify owner if a structural dowelled slab is to be found existing. Do not cut any portion of a slab's structural reinforcement. The GC & its sub-contractors shall maintain the integrity of the existing slab.
K	Disconnect, remove and cap designated MEP utilities and fixtures within demolition areas. Mark location of disconnected utilities.
L	Remove abandoned electric wiring to source of supply. Verify that abandoned wiring and equipment serves only abandoned facilities. Coordinate utility service outages with utility company. Cut conduit flush with or beneath walls and floors, and refinish surfaces.
M	When encountered, inform owner of presence of contaminated materials. Contaminated materials are to be removed by others. Verify that previously removed materials are acceptable prior to commencement of demolition work.

Legend - Demo Plan

	Scope of Work		Door to be removed
NIC	Not In Contract		
	Construction to be removed		Key Note
	Existing wall to remain		

 Legend - Reflected Ceiling Plan

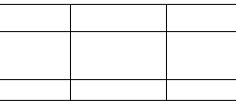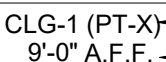	Gypsum ceiling
	Acoustical lay-in ceiling
	Exposed Structure, No Ceiling
	Cove lights
	<u>Ceiling Tag</u> Ceiling Finish Code Ceiling Height (A.F.F.)
	24" x 48" Troffer
	Can Light
	Wall Washer
	Suspended Incandescent Light
	Pendant
	Interior Wall Sconce
	Exterior Wall Sconce
	48" Industrial Fluorescent Strip
	Wall mount Television
	Exit Sign
	Supply Diffuser (Ref. Mechanic)
	Return Diffuser (Ref. Mechanic)
	Exhaust Diffuser (Ref. Mechanic)
	Access Panel

Demolition keyed notes

1	Install (10) 2x4 lights from show & Skytubes Demo
2	Replace damaged ceiling tile, area indicate salvage undamage tile for use as replacement throughout
3	Relocate of (10) Track lights
4	Remove all ceiling tile and lights fixtures



710

14005 E Exposition Ave.
Aurora, CO 80012

Owner:
CEC ENTERTAINMENT, INC.
Irving, TX 77063
ph: 972.258.5521
Contact: Walter Boyd
wboyd@cecentertainment.com

Architect:
PKWY Architects, LLC
1000 Civic Circle
Lewisville, TX 75287
Ph: 213.122.122
Contact: Greg Klimko

MEP Engineer:
Dialectic Engineering
310 W. 20 th street
200 Kansas City, MO 64108
ph: 816.997.9627
Contact: Joe Hillebrenner, P.E.



Architect: William D. Pounds

A	Permit Set	5/13/19
No.	Description	Date

DRAWN BY: RM/VG
CHECKED BY: DD
PROJ. NO: 08-19413
Copyright Parkway C&A, LP 2019 ©

Demolition RCP Plan

D1.1




City of Aurora Building Division
Reviewed for Code Compliance
Approved as Noted: **Erick B.**
Date: **Jun 21, 2019**
2015 INTERNATIONAL CODES & 2017 NEC


RSN: 1369378
Permit #: 19-1625136

Code violations that are found during inspection are required to be corrected. Permit issuance does not grant approval of a code violation.


Field Inspection consultation is available upon request. Call 303-739-7420 to request a consultation

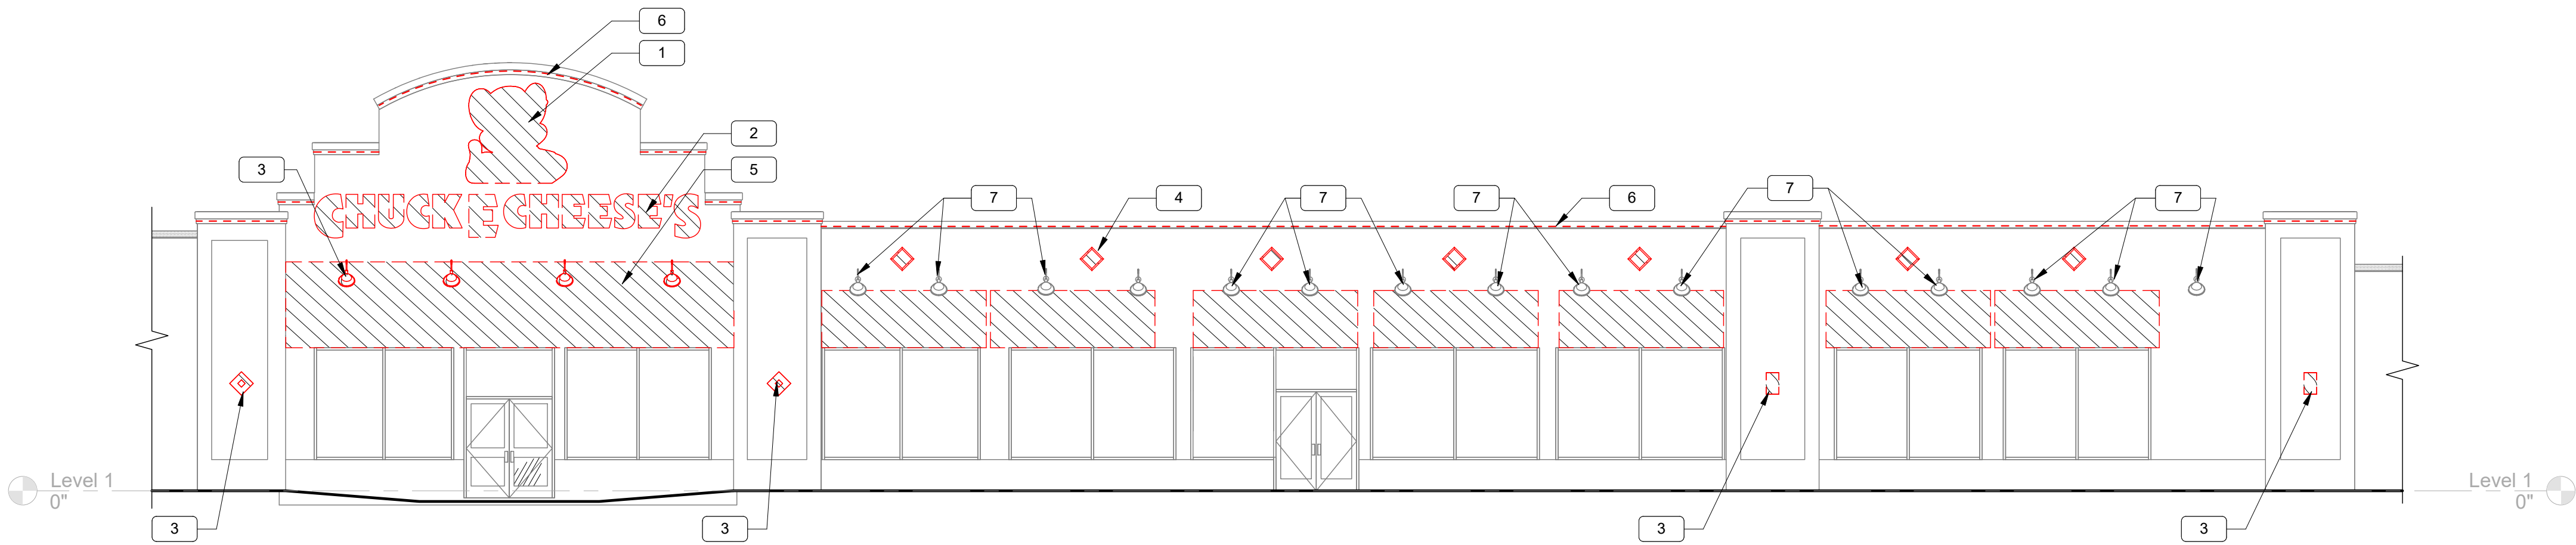


1 South Elevation
1/8" = 1'-0"

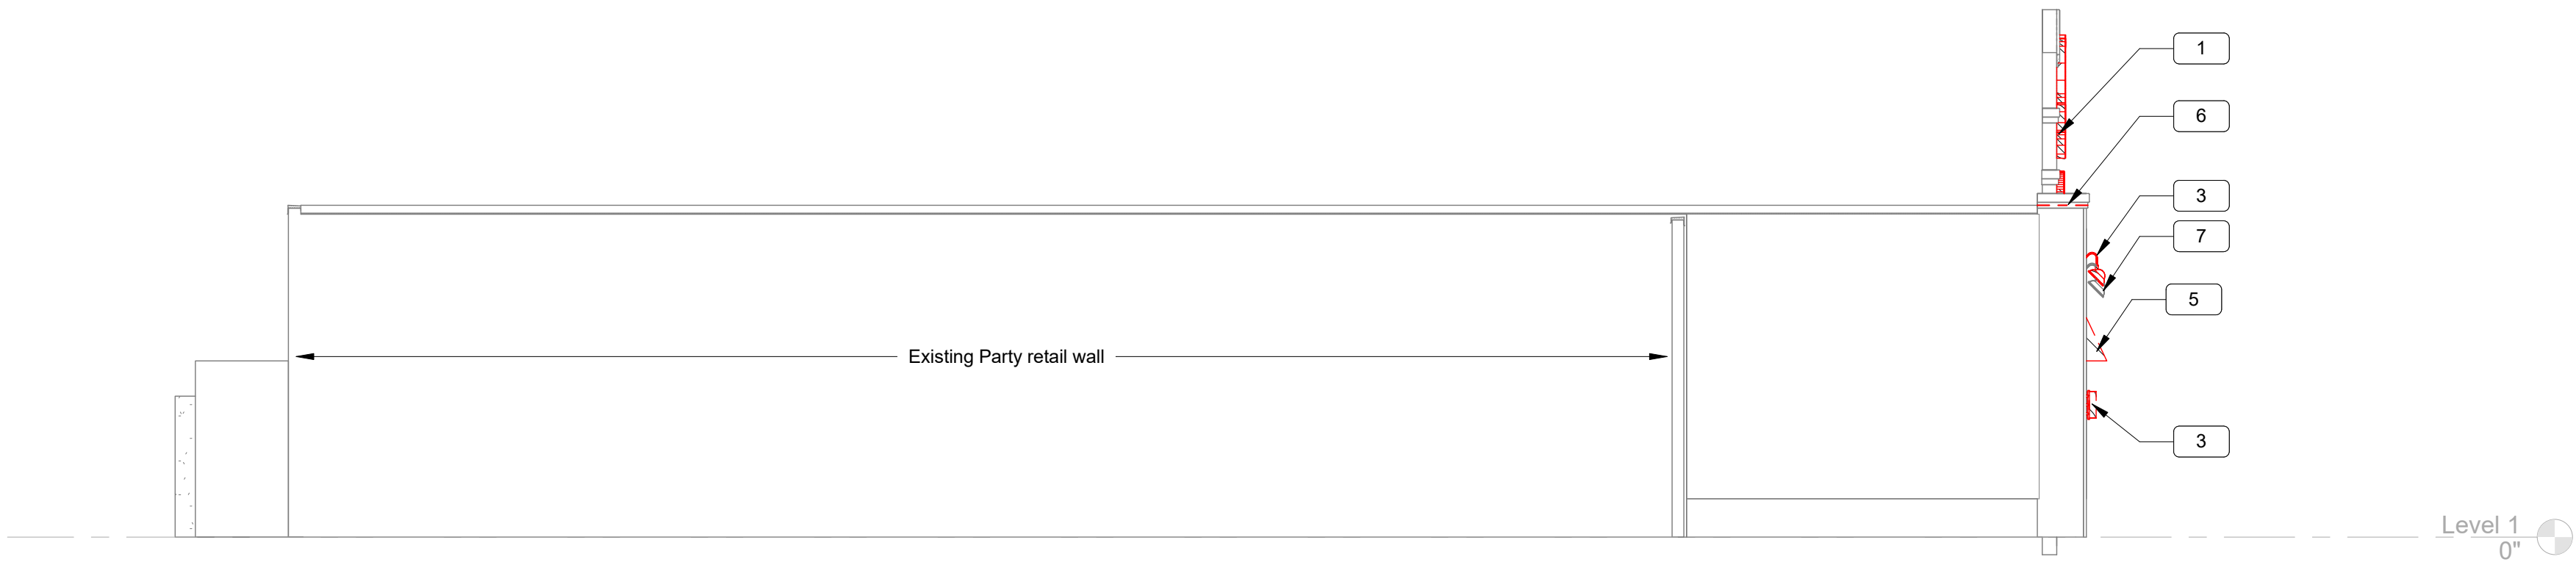

2 East Elevation
1/8" = 1'-0"

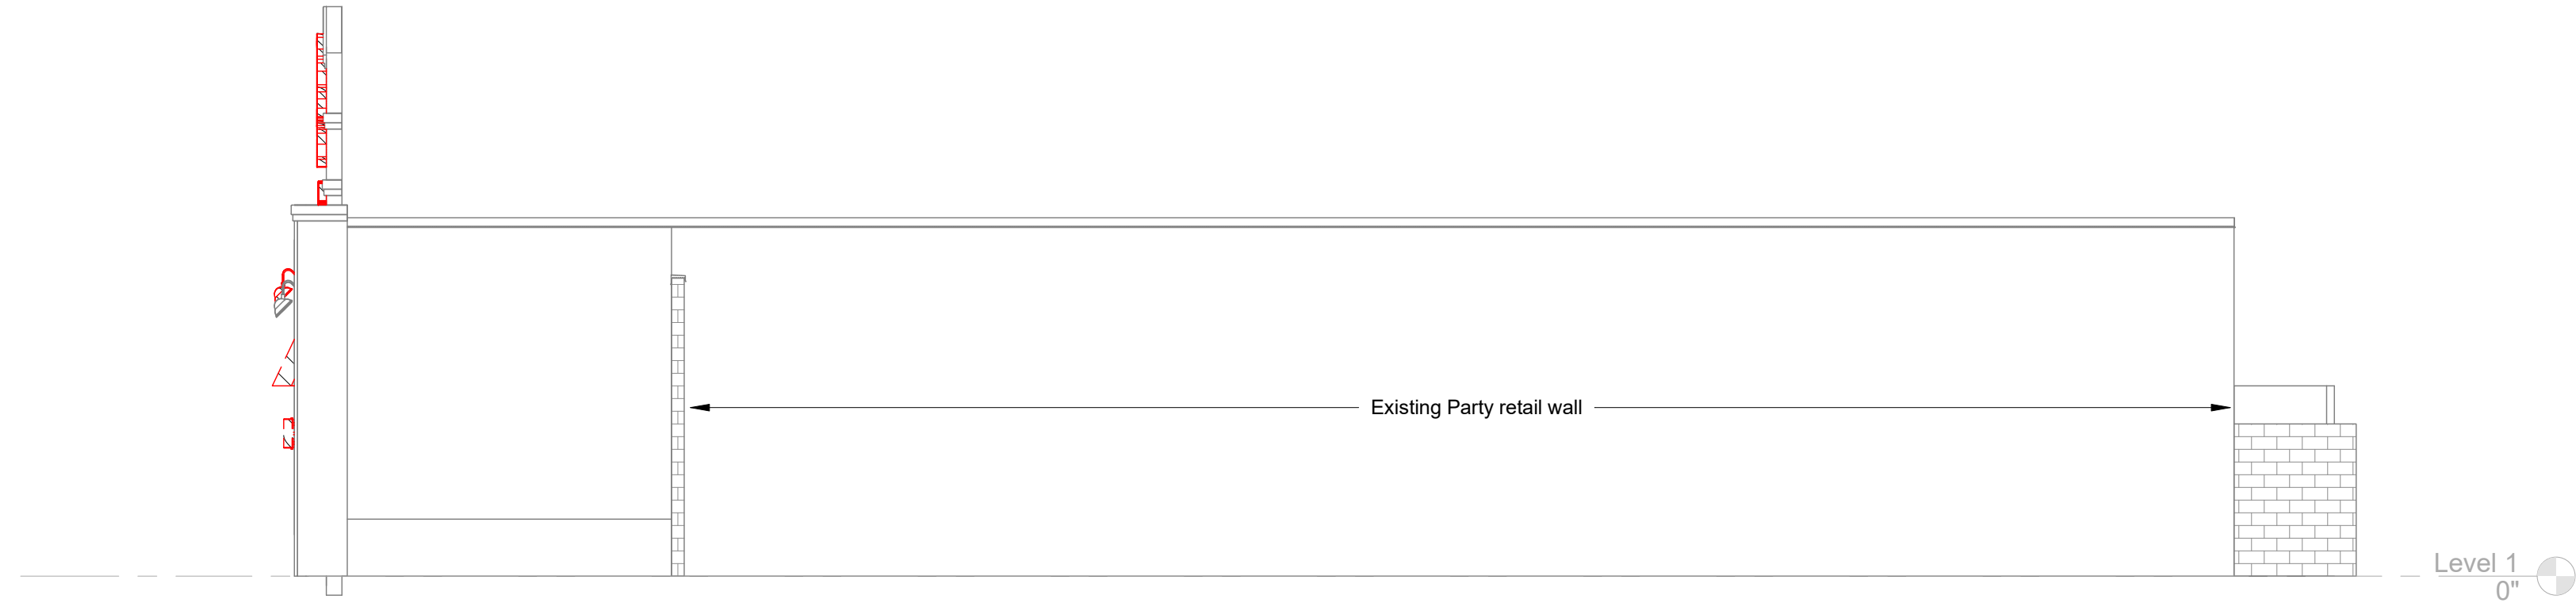

3 West Elevations
1/8" = 1'-0"

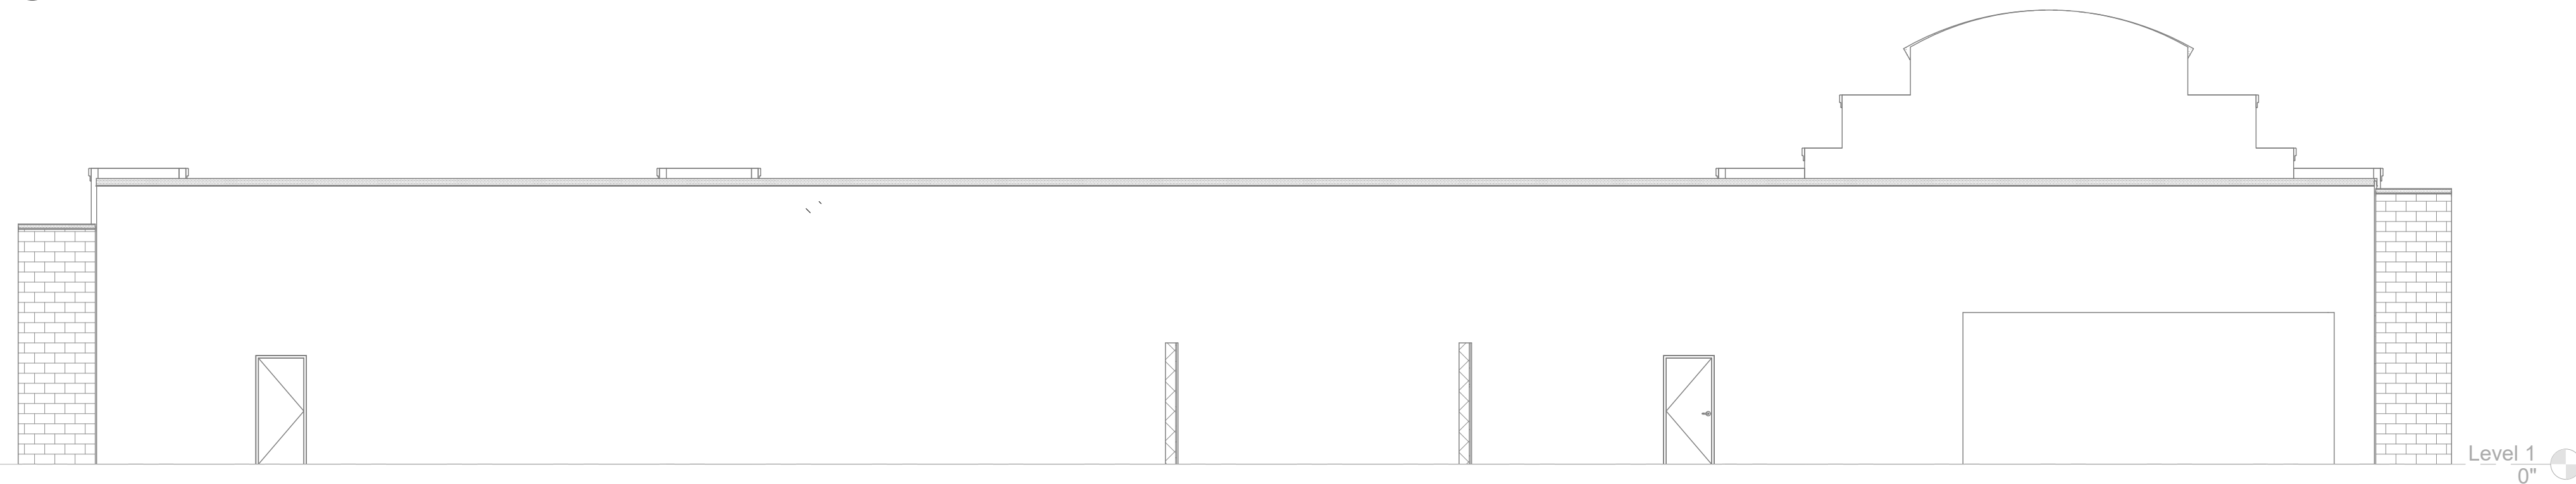

4 North Elevation
1/8" = 1'-0"

General Notes - Demolition

Key #	Demolition Notes
A	Existing conditions are based on field observations. The demolition plan is for reference only. Contractor to verify existing conditions prior to the start of work.
B	Demolish indicated structures and fixtures in an orderly and careful manner.
C	Provide temporary supports, shoring and bracing as required to protect existing structural items remaining in place. Verify and coordinate existing utilities to be removed and/or relocated.
D	Erect weatherproof closures for exterior openings created by demolition work.
E	Demolished items shall be removed from site and legally disposed of.
F	Protect existing landscape materials, appurtenances, and structures which are to remain.
G	Remove all floor finishes down to substrate.
H	Remove walls and structures down to surface which may be refinished.
J	Where the scope of work requires penetration of the existing slab, the GC shall verify existing slab's construction type. Do not saw cut concrete slab, core drill only. Where a slab on grade is to be found, the GC shall patch, repair and install reinforcing #5 x 18" dowels with 9" embedment @ 18" o.c. along perimeter of new work. GC to notify owner if a structural supported slab is to be found existing. Do not cut any portion of the slab's structural reinforcing. The GC & his sub-contractors shall maintain the integrity of the existing slab.
K	Disconnect, remove and cap designated MEP utilities and fixtures within demolition areas. Mark location of disconnected utilities.
L	Remove abandoned electric wiring to source of supply. Verify that abandoned wiring and equipment serves only abandoned facilities. Coordinate utility service outages with utility company. Cut conduit flush with or beneath walls and floors, and refinish surfaces.
M	When encountered, inform owner of presence of contaminated materials. Contaminated materials are to be removed by others. Verify that previously removed materials are acceptable prior to commencement of demolition work.

Legend - Demo Plan

---	Scope of Work	---	Door to be removed
NIC	Not In Contract	---	Key Note
---	Construction to be removed	---	
---	Existing wall to remain		

Demolition keyed notes

1	Replace CEC Head logo
2	Replace CEC wall mounted words
3	Remove lighting fixtures
4	Remove existing accent diamond typ
5	Remove existing awning typ
6	Demolish Led accent along parapet
7	Wall Washer lights to remain

Code violations that are found during inspection are required to be corrected. Permit issuance does not grant approval of a code violation.

Field Inspection consultation is available upon request. Call 303-739-7420 to request a consultation



City of Aurora Building Division
Reviewed for Code Compliance
Approved as Noted: **Erick B.**
Date: **Jun 21, 2019**
2015 INTERNATIONAL CODES & 2017 NEC

RSN: 1369378
Permit #: 19-1625136

CONSTRUCTION • ARCHITECTURE

PKWY

PKWY Architects, LLC
1000 Civic Circle Lewisville, TX 75067
parkwayconstruction.com (972) 221-1979

Architect:

Contact: W.D. Pounds
(469) 322-3714

Project Manager:

Contact: Jeremy Blaisdell
(469) 322-3732



710

14005 E Exposition Ave.
Aurora, CO 80012

Owner:


CEC ENTERTAINMENT, INC.
Irving, TX 77063
ph: 972.258.5521
Contact: Walter Boyd
wboyd@cecentertainment.com

Architect:

PKWY Architects, LLC
1000 Civic Circle
Lewisville, TX 75287
Ph: 213.122.122
Contact: Greg Klimko

MEP Engineer:

Dialectic Engineering
310 W. 20 th street
200 kansas City, MO 64108
ph: 816.997.9627
Contact: Joe Hillsbrenner, P.E.

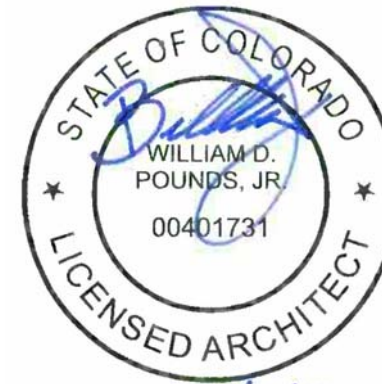

Architect: William D. Pounds

A	Permit Set	5/13/19
No.	Description	Date

DRAWN BY: RM/VG


CHECKED BY: DD

PROJ. NO: 08-19413

Copyright Parkway C&A, LP 2019 ©

Demolition Elevations

D1.2

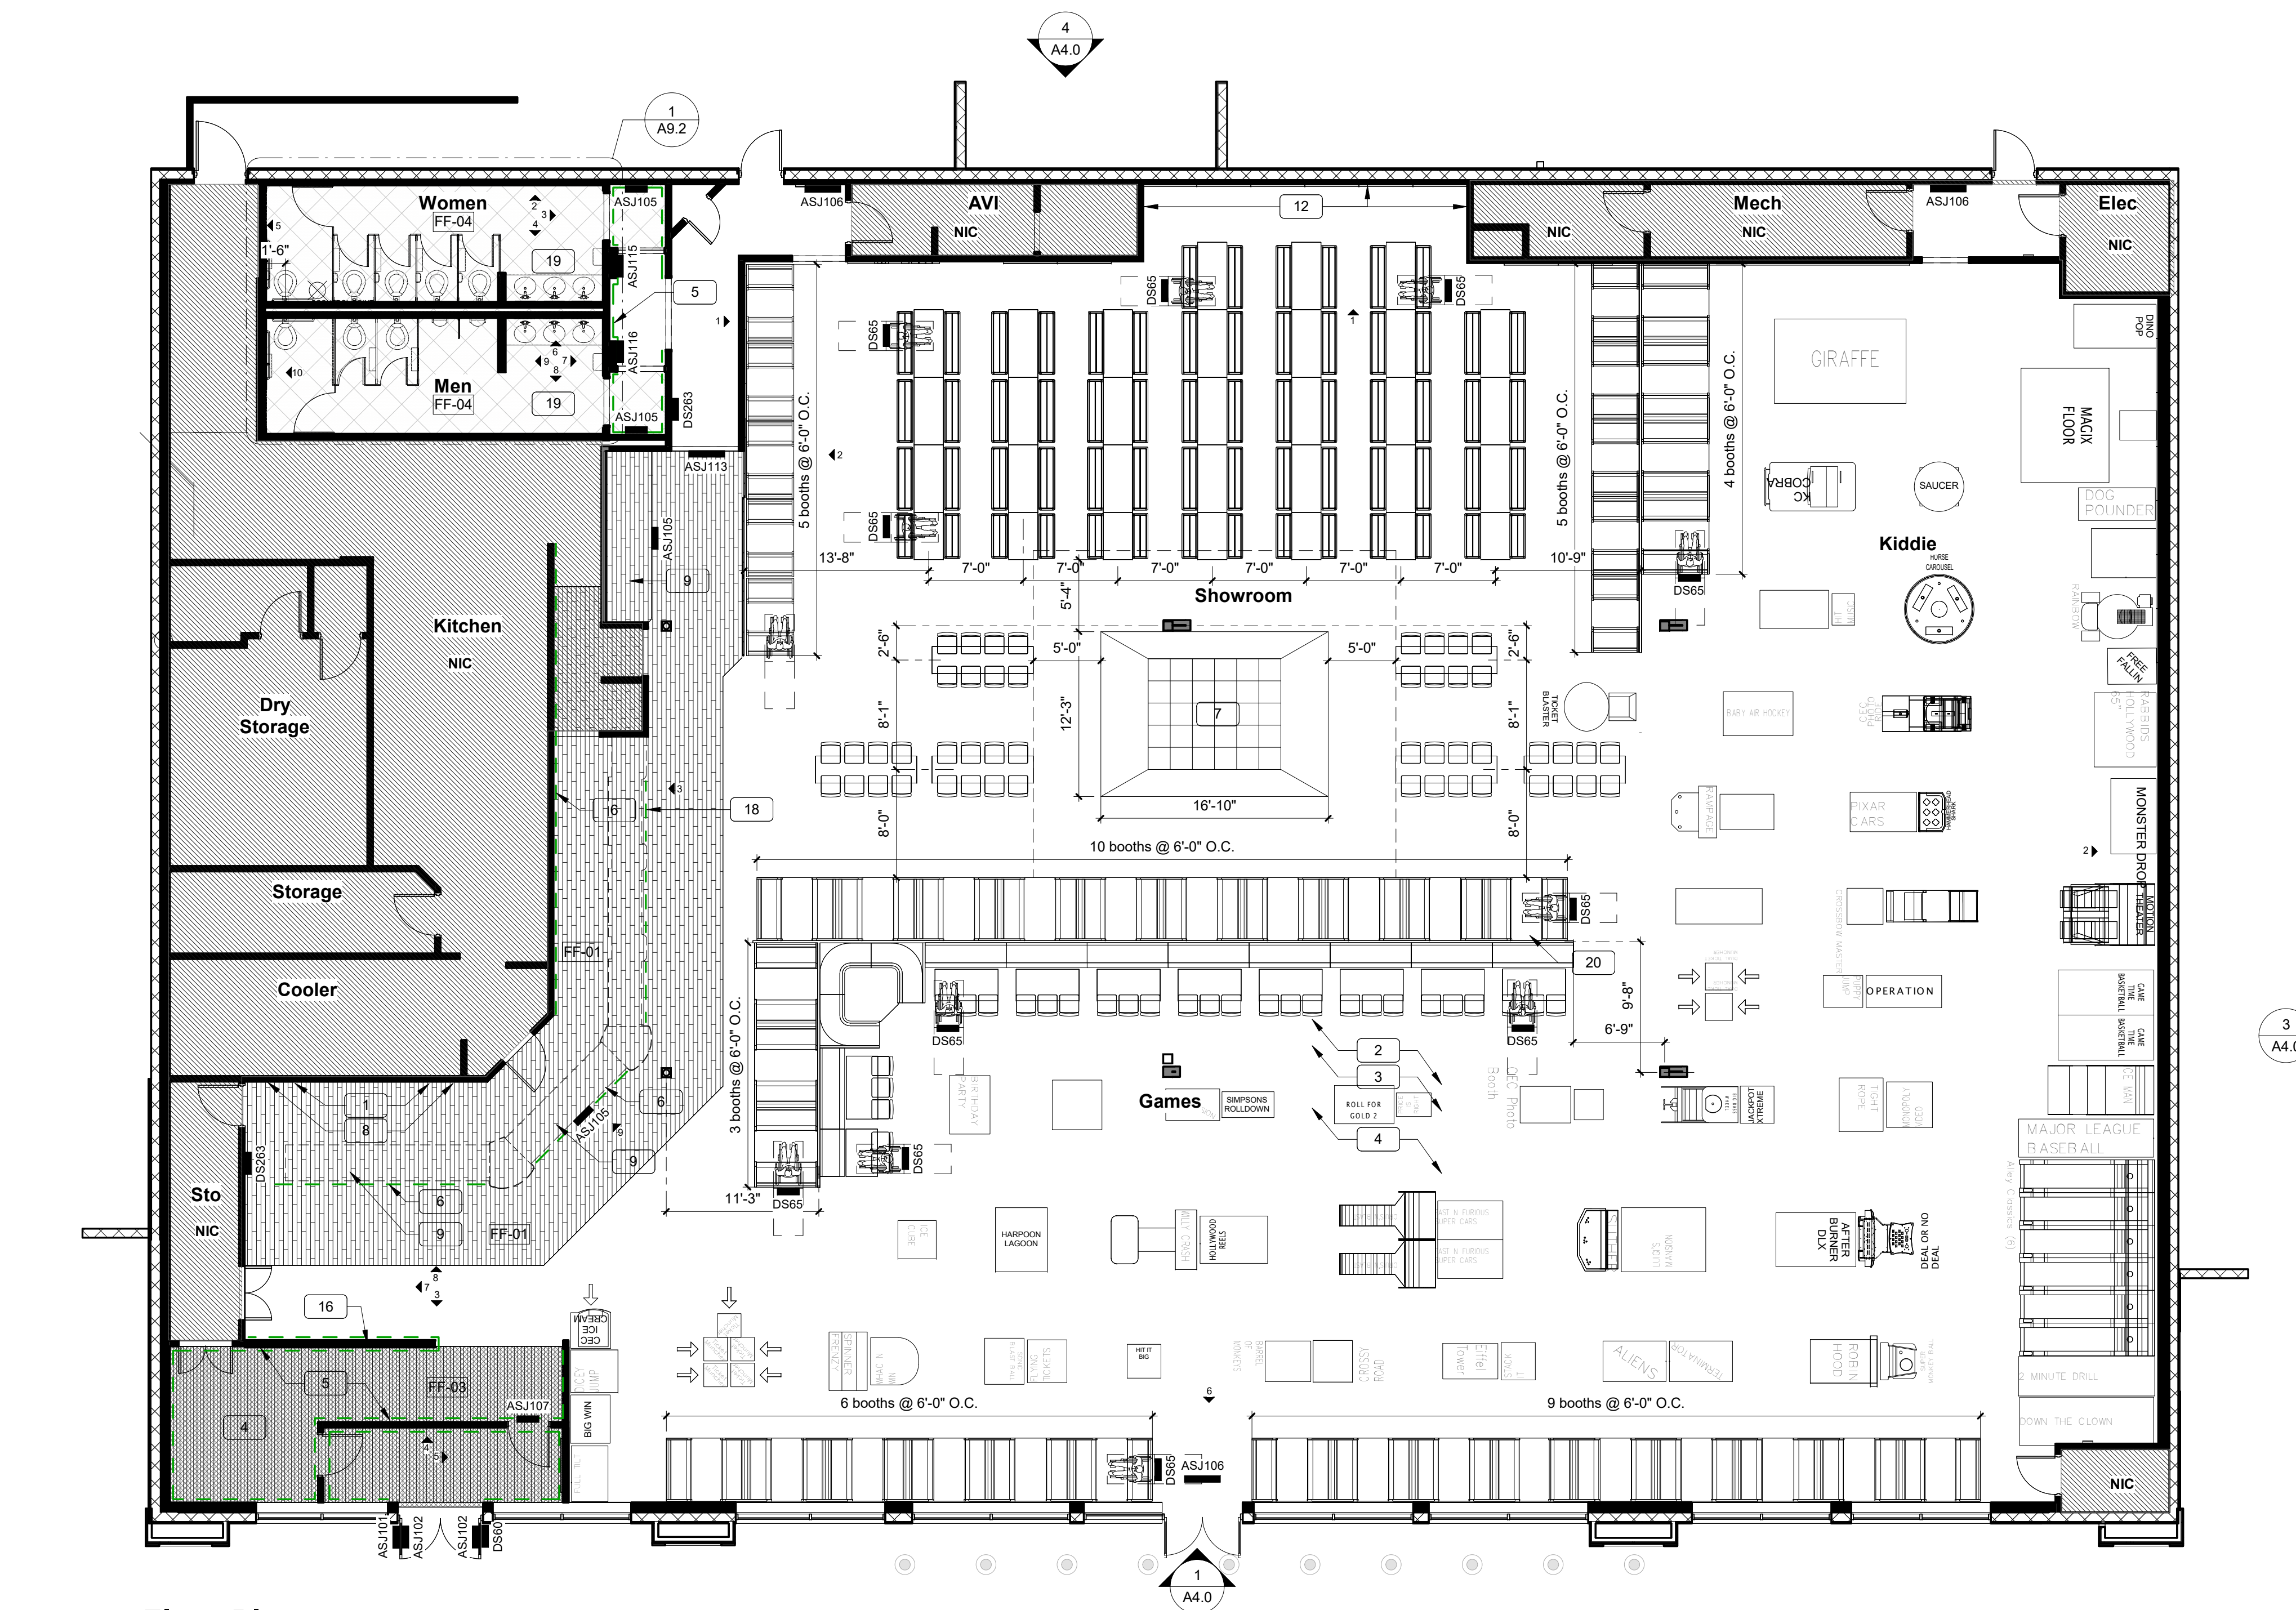

1 Floor Plan
1/8" = 1'-0"
TRUE NORTH



2 Site Plan
NTS

Provide a sign stating "EXIT" in raised, visual characters and braille adjacent to each door in an area of refuge, an exterior area for assisted rescue, an exit stairway or ramp, an exit passageway and the exit discharge.
2015 IBC 1013.4

Field Inspection consultation is available upon request. Call 303-739-7420 to request a consultation

Code violations that are found during inspection are required to be corrected. Permit issuance does not grant approval of a code violation.

Floor Plan General Notes

Key #	Floor Plan General Notes
A	Interior "Clear" dimensions are finish dimensions, "Hold" are to studs.
B	Security systems are to be provided and installed by others. General Contractor shall be responsible for coordination with owner's security systems contractor.
C	Wall surfaces must be cleaned and dust free prior to caulking.
D	Paint entire customer side interior walls, above wainscot to underside of ceilings include columns, existing headers & door jams

General Notes - Furniture

A	New booths throughout to be fabricated by owner's millwork manufacturer and installed by the GC.
B	New settee's to be fabricated by owner's millwork manufacturer and install by the GC. Settee's to be mechanically fastened. Refer to manufacturer's shop drawings.
C	Install new benches and tables as indicated in Showroom.
D	New booths and tables throughout are to be installed as directed by CEC and as specified by CEC on final furniture mark-up plan as indicated on construction issue drawings.
E	Existing Kid check stanchions to be replaced with adjustable queue rail.
F	Existing millwork to remain. Replace red plastic laminate as indicated. Prep for new mosaic tile FRP.
G	Booth divider panels to be mechanically fastened to booth seating. Refer to manufacturer's shop drawings.
H	GC to install new artwork, decor and coat hooks as indicated. GC to install new corner guards as needed matching existing. Final location to be determined by CEC prior to construction. Do not install any decor until mounting locations have been verified by CEC. PA.
J	Install fire extinguishers, alarms, PA controls, motion detector, emergency lighting, thermostats, etc. as required by local fire and/or building authorities. Installation of new art work and decor shall not be in conflict. Unspecified locations for non life safety items shall be verified with owner prior to installation. Unspecified locations for life safety items shall be verified with local fire and/or building authorities prior to installation. Install "Squawk Boxes" on all customer accessible pull stations.

Floor Plan keyed notes

- 1 Install new Digital Menu Board (DMB)
- 2 Install Under Carpet floor electrical outlets (+/- 50' pulg) throughout Kiddie and Games room
- 3 New furniture scope: Salvaged Tables bases; New Showroom Benches and tables; New booth and Settee seating; New high top seating
- 4 Install new Carpet, install high traffic carpet at entry vestibule to kid check, patch floor from stanchion removal
- 5 Replacement Marlite in vestibule, entry area and restroom wall to include pass thru wall
- 6 New Wood look tile at cash wrap
- 7 New Dance floor with Inslab elec. ((5) 20 AMP circuits) and (2) Data; (6) structure mount monitor pendants with Clg. data and duplex at each monitor
- 8 Install wall tile to the existing DMB
- 9 Front counter scope: Salad counter, replace red laminated with mosaic FRP; Cash counter, replace rel plan with mosaic FRP; Beverage, replace red plan with mosaic FRP; Merch, existing to remain
- 12 Patch/repair wall from stage demo, patch, install Marlite and paint
- 16 Refinish half wall Caps at entry
- 18 Provide power and installation for structure hung "You Won" sign
- 19 Restroom scope: New floor tile; New wall tile to existing height, New Plumbing fixtures; New "floating" corian vanities; New "spiced zapher" partitions; New Recessed Hand dryer; New Recessed baby changer New Basket 2x4 light fixtures; New vanity lights
- 20 (3) Costumer wall outlets & (10) booth outlets at settee

SIGNAGE SCHEDULE					VENDOR	EXISTS	NEW	REMARKS
ITEM #	QTY	DESCRIPTION						
ASJ-101	1	Hours of Operation Decal. Hours SUN-THURS 11AM-9PM FRIDAY 11AM-10PM SAT-SUN 10AM-10PM Change times if needed			Ajax		x	V.I.F.
ASJ-102	1	Enter / Exit decal kit, two each - total four pieces.			Ajax		x	V.I.F.
ASJ-103		Good Behavior Guidelines Display			Ajax		x	V.I.F.
ASJ-104	1	Maximum Occupancy Sign			Ajax		x	Top @ 9" Below CLG
ASJ-105	4	Caution Wet Floor Sign			Ajax		x	V.I.F.
ASJ-106	1	Emergency Exit Decal			Ajax		x	Bottom @ 5'-0" A.F.F.
ASJ-107	3	Emergency Exit Sign			Ajax		x	Bottom @ 5'-0" A.F.F.
ASJ-108		Wash Hands Sign			Ajax		x	V.I.F.
ASJ-109		No Deliveries Sign			Ajax		x	V.I.F.
ASJ-110		Do Not Open Unless Manager Is Present Sign			Ajax		x	V.I.F.
ASJ-111	1	Pasqually's Kitchen Sign			Ajax		x	V.I.F.
ASJ-112	2	Restroom Sign - single sided with no arrow			Ajax		x	Bottom @ 8" Above Opening
ASJ-113		Restroom Sign - single sided with no arrow (lr?)			Ajax		x	V.I.F.
ASJ-114		Restroom Sign - double sided			Ajax		x	V.I.F.
ASJ-115	1	Tactile Braille Circular Girls Restroom Sign			Ajax		x	Center @ 5'-0" A.F.F.
ASJ-116	1	Tactile Braille Triangular Boys Restroom Sign			Ajax		x	V.I.F.
ASJ-117		Tactile Braille Rectangular Girls Restroom Sign			Ajax		x	V.I.F.
ASJ-118		Tactile Braille Rectangular Boys Restroom Sign			Ajax		x	V.I.F.
ASJ-119		Tactile Braille Rectangular Family Restroom Sign			Ajax		x	V.I.F.
ASJ-120		Show Me The Standard Display			Ajax		x	V.I.F.
ASJ-121		Scheduling Center			Ajax		x	V.I.F.
DS60-09	1	3" x 3" Decor Decal (ADA) (Blue)			Ajax		x	V.I.F.
DS65-09	11	3" x 3" Seating Signs (ADA) (Blue)			Ajax		x	V.I.F.
D-PHSO248		Cotton Candy Hangar			Prog			V.I.F.
FHBHBD01	2	Balloon Hangar			Prog	x		V.I.F.
D-D263	2	Marketing Light Boxes (V)			SPT	x		V.I.F.

NOTE: All signage, new or used is installed by contractor. Please locate per elevations. Secure using glue (silicone) and anchors along with cleats provided. If in doubt, hold for direction at walk through inspection. When direction is centered on light wash it is expected that light location match plans.



City of Aurora Building Division
Reviewed for Code Compliance
Approved as Noted: **Erick B.**
Date: **Jun 21, 2019**
2015 INTERNATIONAL CODES & 2017 NEC
RSN: 1369378
Permit #: 19-1625136

CONSTRUCTION • ARCHITECTURE

PKWY

PKWY Architects, LLC
1000 Civic Circle Lewisville, TX 75067
parkwayconstruction.com (972) 221-1979

Project Manager: Contact: Jeremy Blaisdell (469) 322-3732

Architect: Contact: W.D. Pounds (469) 322-3714




710

14005 E Exposition Ave.
Aurora, CO 80012

Owner:
CEC ENTERTAINMENT, INC.
Irving, TX 77063
ph: 972.258.5521
Contact: Walter Boyd
wboyd@cecertainment.com

Architect:
PKWY Architects, LLC
1000 Civic Circle
Lewisville, TX 75287
Ph: 213.122.1222
Contact: Greg Klimko

MEP Engineer:
Dialectic Engineering
310 W. 20th Street
200 Kansas City, MO 64108
ph: 816.997.9627
Contact: Joe Hillebrenner, P.E.

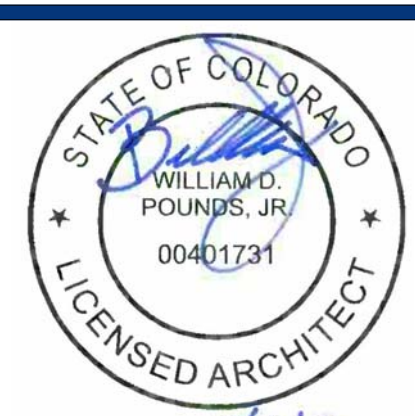


Architect: William D. Pounds

No.	Description	Date
1	City Comments	5/22/19
A	Permit Set	5/13/19

DRAWN BY: RM/VG
CHECKED BY: DD
PROJ. NO: 08-19413
Copyright Parkway C&A, LP 2019 ©

Floor Plan

A1.0

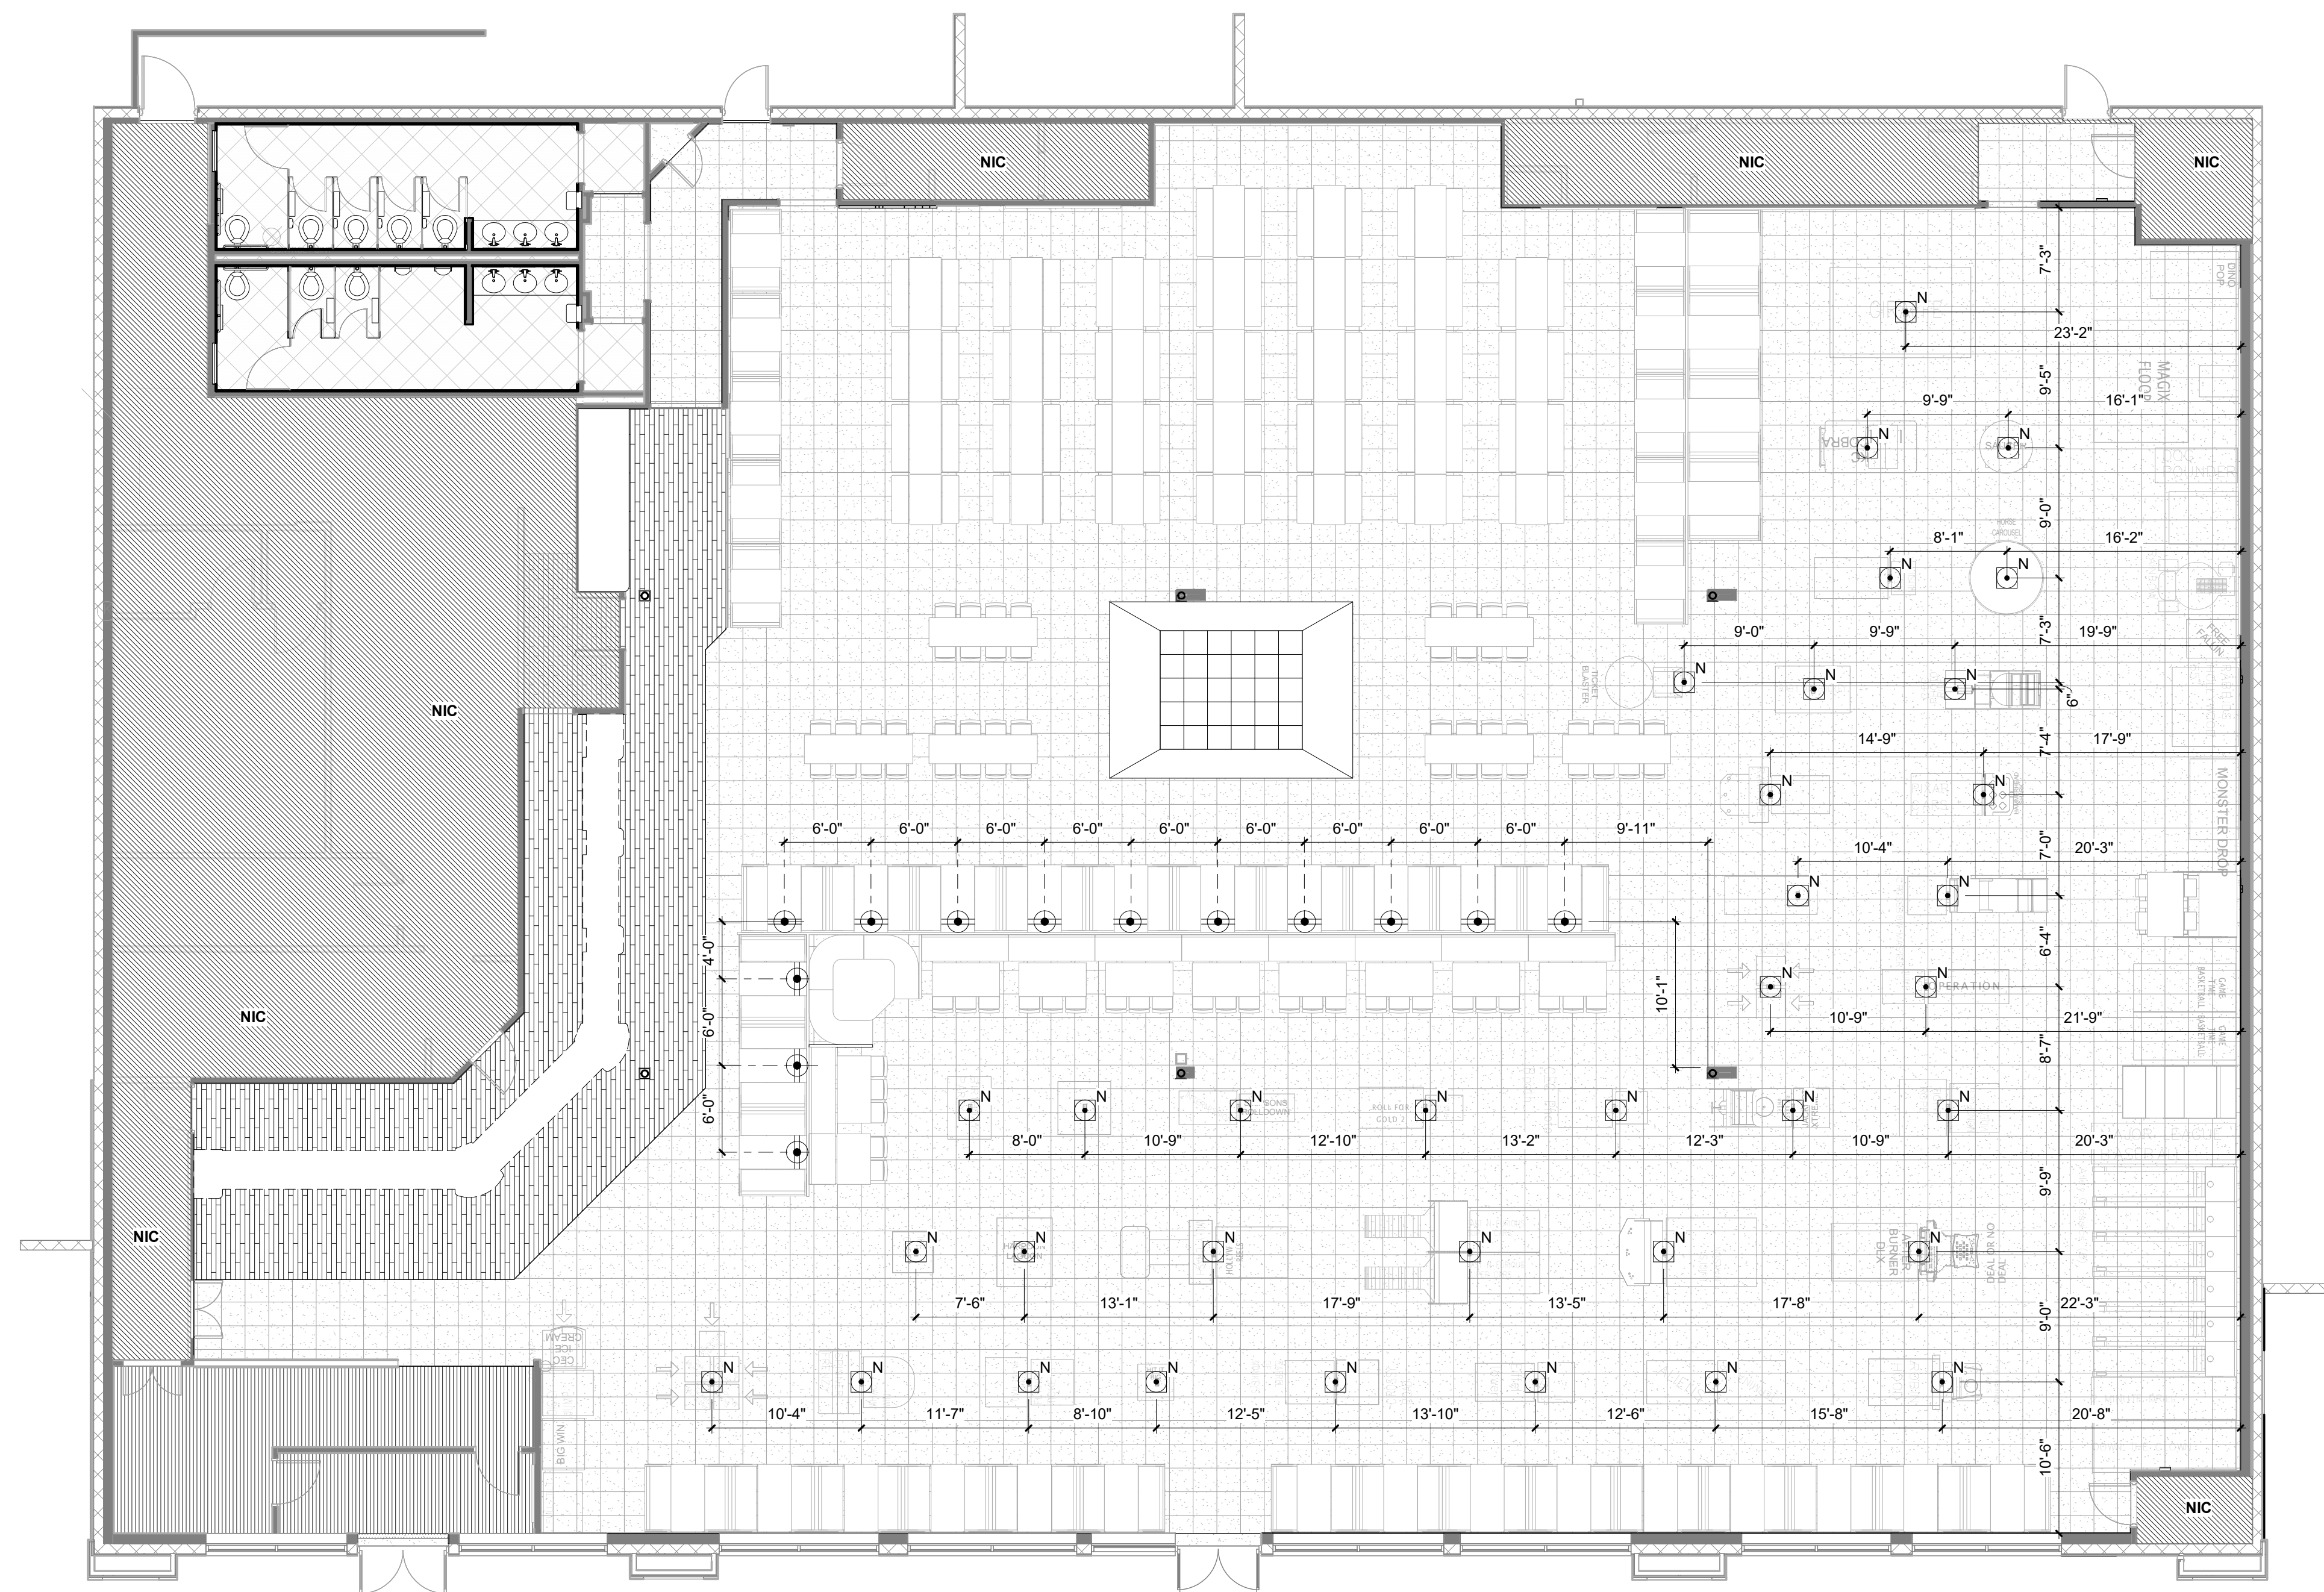

General Dimension Outlets

1	All Repairs and Patch work after installation shall match adjacent surfaces and have no visible seams.
2	New Electrical items are shown in bold graphics on plan(s).
3	Install new floor power, phone and air outlets as determined by games. After games install is complete, replace any exposed / broken floor outlets covers. GC to verify that all floor outlet have brass covers.
4	Refer E2.0 for Circuiting and Details.
5	

Legend - Dimension Outlets Plan

	Surface mounted flatwire duplex receptacle
	Surface mounted flatwire quad receptacle-dedicate circuit for each duplex
	Surface mounted flatwire data drop with Cat 5e cable
	3 Conductor flatwire branch circuit
	5 Conductor flatwire branch circuit (1 spare conductor)
	Cat 5e flatwire data/telephone drop
	Fully recessed wall mounted flatwire transition box
	20 AMP Power supply
	Wall mounted airline supply located in recessed box w/1/2" ball valve
	Wall mounted airline supply w/1/2" ball valve
	
	Floor mounted airline / power supply in recessed floor box
	Wall mounted power supply unit for equipment
	Floor mounted duplex power outlet
	Wall mount duplex power outlet @ 18" AFF unless noted otherwise
	Wall mount duplex power outlet & USB "child proof" @ 36" AFF unless noted otherwise
	Wall mount quadplex power outlet @ 18" AFF unless noted otherwise
	Phone Jack, Floor or Wall @ 18" AFF
	Junction Box mounted where indicated
N	New Item
E	Existing Item

CONSTRUCTION • ARCHITECTURE



PKWY Architects, LLC
1000 Civic Circle Lewisville, TX 75067
arkwayconstruction.com (972) 221-1979

Project Manager:
Contact: Jeremy Blado
(469)322-3732

Architect:
Contact: W.D. Pounds
(469)322-3714



710

14005 E Exposition Ave.
Aurora, CO 80012

Owner:


CEC ENTERTAINMENT, INC.
Irving, TX 77063
ph: 972.258.5521
Contact: Walter Boyd
wboyd@cecentertainment.com

Architect:

PKWY Architects, LLC
1000 Civic Circle
Lewisville, TX 75287
Ph: 213.122.122
Contact: Greg Klimko

MEP Engineer:

Dialectic Engineering
310 W. 20th street
200 Kansas City, MO 64108
ph: 816.997.9627
Contact: Joe Hillebrenner, P.E.

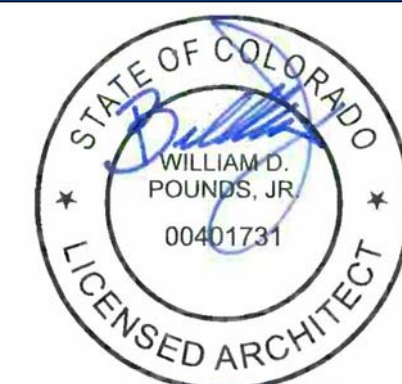

5/13/19
Architect: William D. Pounds

A	Permit Set	5/13/19
No.	Description	Date

DRAWN BY: RM/VG

CHECKED BY: DD

PROJ. NO: 08-19413

Copyright Parkway C&A, LP 2019 ©

Dimension Outlet Plans

A1.2


Code violations that are found during inspection are required to be corrected. Permit issuance does not grant approval of a code violation.

Field Inspection consultation is available upon request. Call 303-739-7420 to request a consultation






City of Aurora Building Division
Reviewed for Code Compliance
Approved as Noted: **Erick B.**
Date: **Jun 21, 2019**
2015 INTERNATIONAL CODES & 2017 NEC

RSN: 1369378
Permit #: 19-1625136


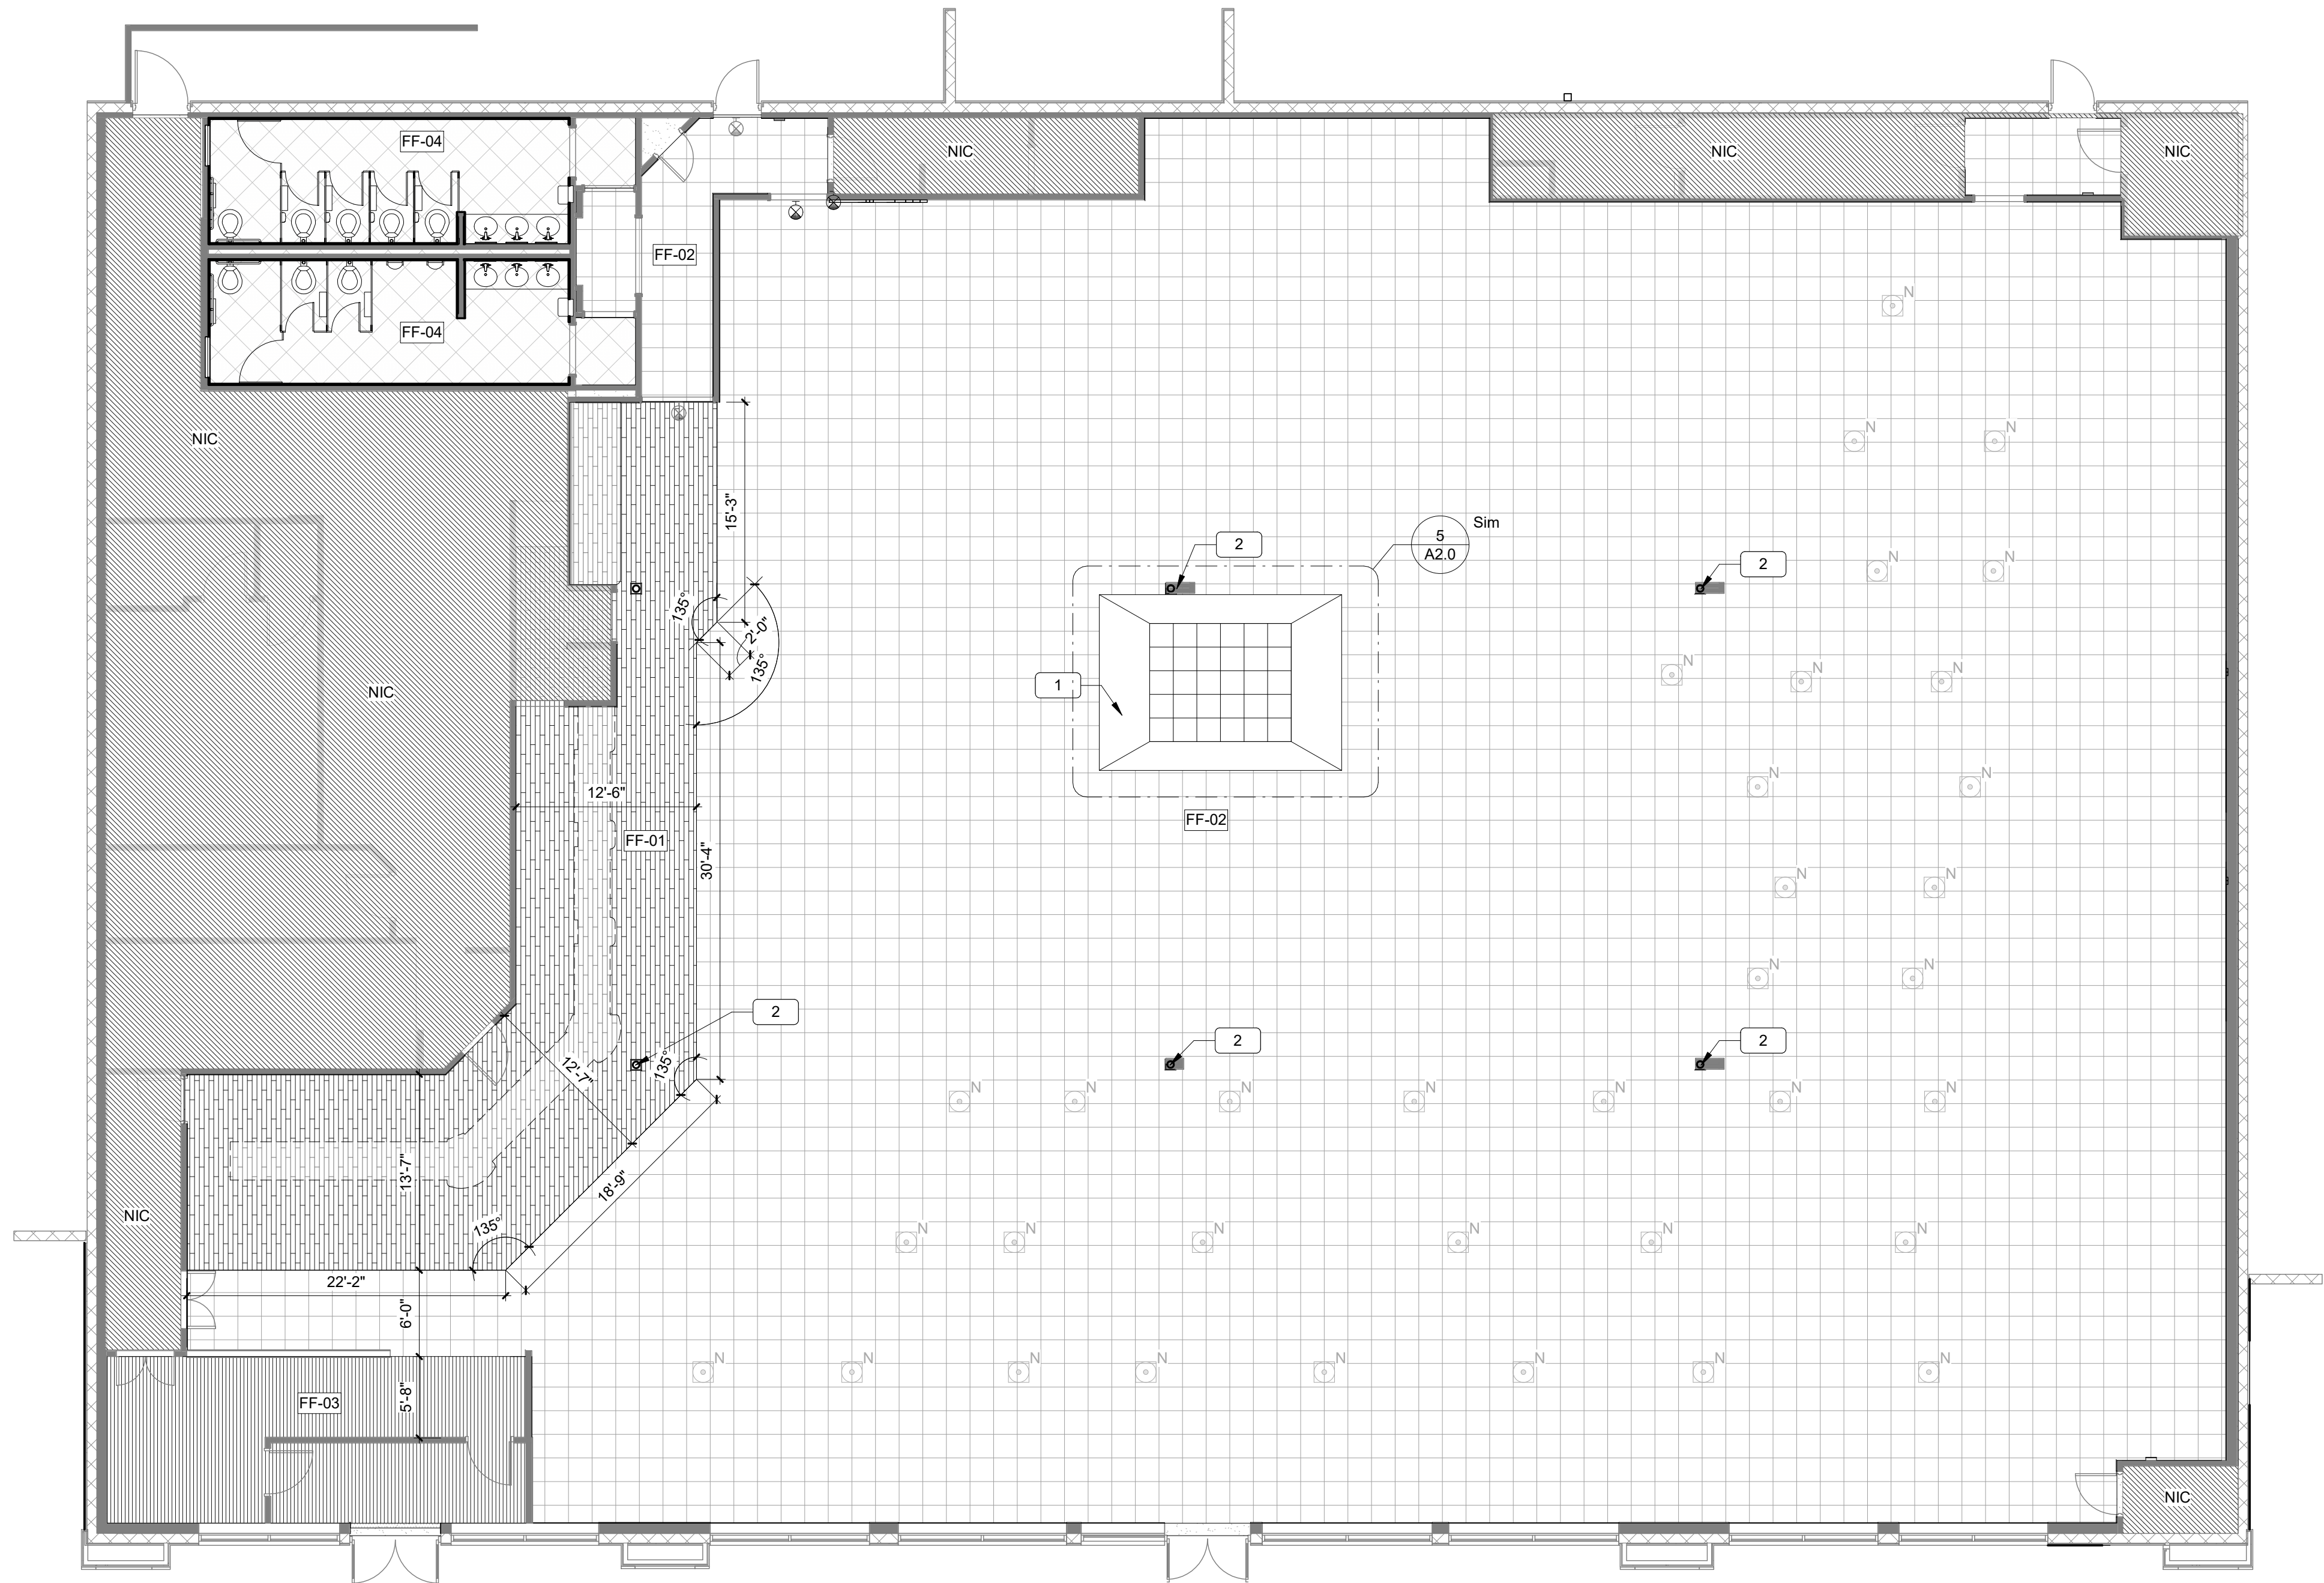


1 Floor Finish Plan

1/8" = 1'-0"

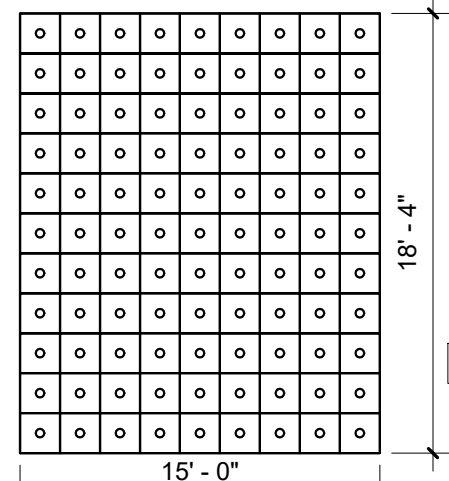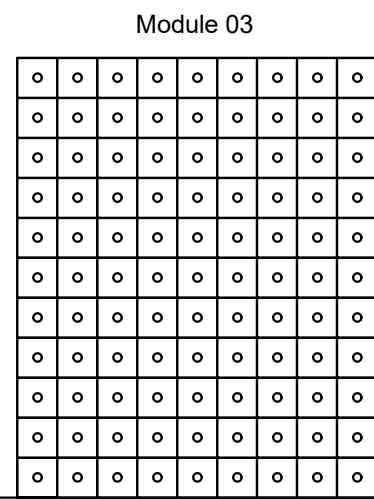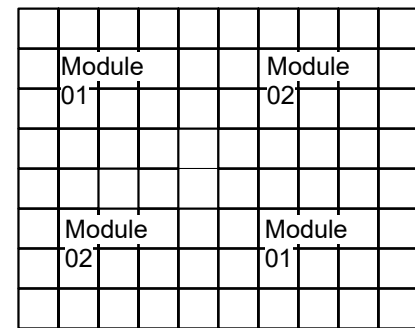

Product Icebreaker:
50CM x50 CM
105773 Jet Mist

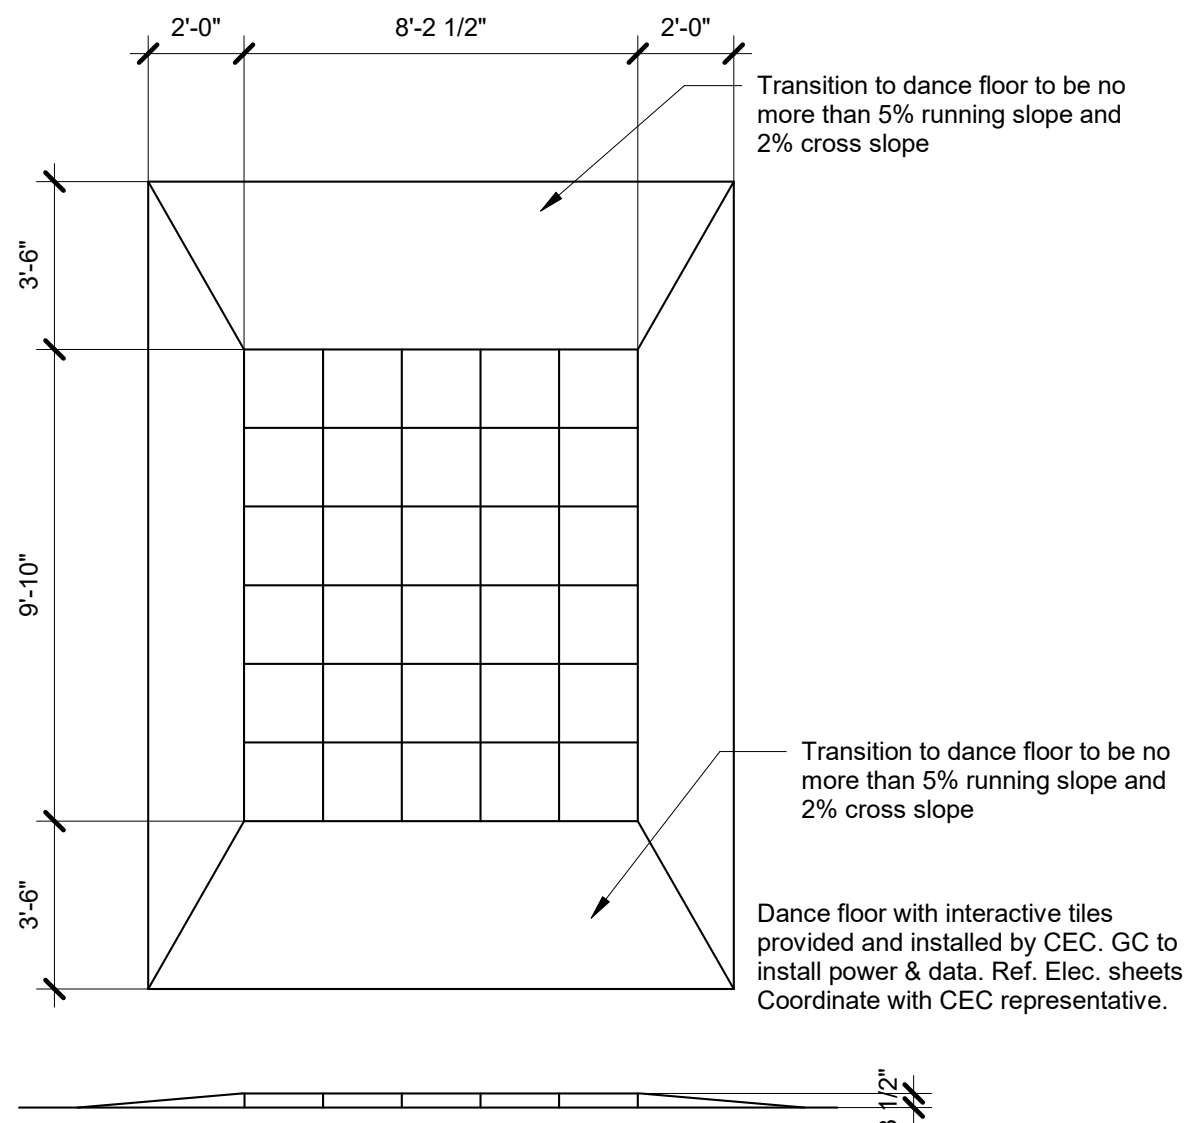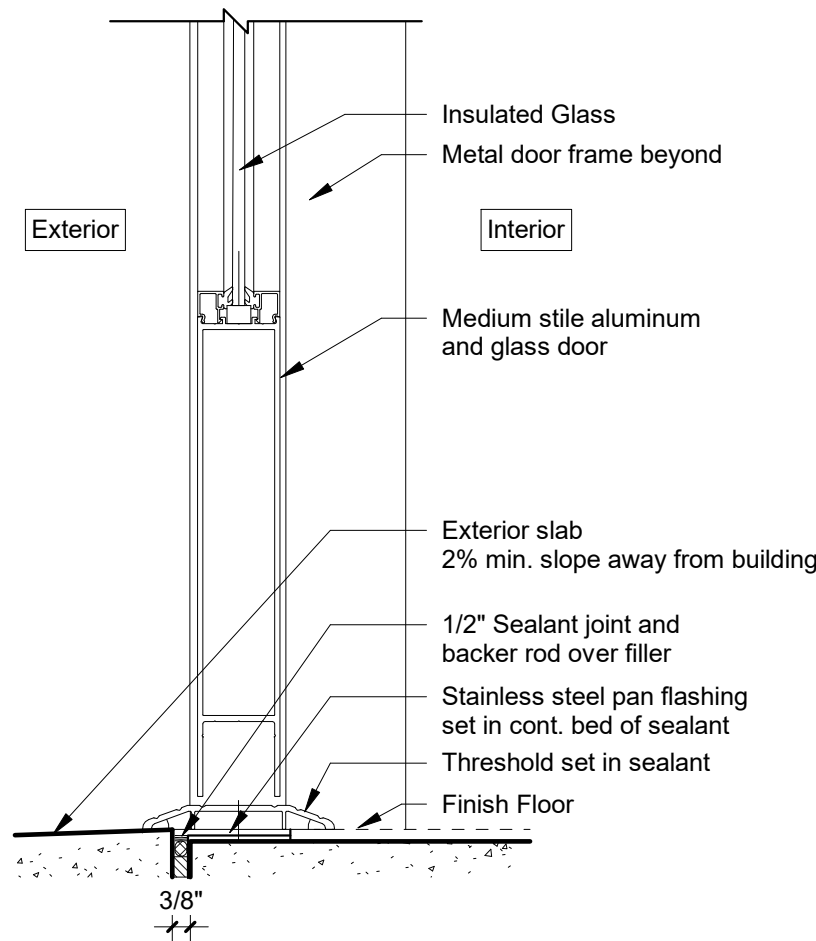

General Notes - Interior Finish

- A Ensure surfaces to receive finishes are clean, true and free of irregularities. Do not proceed with work until unsatisfactory conditions have been corrected.
- B No finish substitutions may be made without prior written authorization by Architect.
- C All finishes shall be applied in strict accordance with manufacturer's specifications.
- D Provide temporary protection for all installed finishes as work progresses.
- E Submit samples of finishes for approval prior to installation.
- F All paint shall be applied in accordance with the manufacturer's specifications for that particular surface.
- G Examine walls to ensure proper preparation before application of paint. Beginning work implies acceptance of condition.
- H Comet Signs. to provide resized acrylic wall art. Install by GC. Coordinate final installation with CEC.

Floor Finish - Legend

- J GC to install plastic wall guards at public areas.
- K Comet Signs to field verify dimensions of wall walls receiving signs prior to final design and installation.
- L Refer to A8.0 Interior Finish Schedule.
- M Save table bases Typ.
- N Install surface mounted blocking to match wall color.

FF-01 Product: Interlaminic Forestland Cypress size 6"x24"
Grout: Mapei # 7 - "chocolate"
Grout line: use a 1/16"
Cove: Dilex-HK Bronze by Schuler Systems
Pattern: 1/3 Offset running bond

FF-02 Carpet Tile. Company Interface
Product Syncopation: 50 cm. x 50 cm.
6491 Hemlock 10%
6487 Blue Grass 10%
Product Icebreaker: 50 cm. x 50 cm.
105773 Jet Mist 60%
105771 Granite 20%

FF-03 Product: High Traffic Entrance Carpet Tile.
Style: SR999, 104945 Onix Carpet Tile

FF-04 Product: Pinot (Series)
Color: Gold Meunier
Size 20"x20" (install Diagonal)
Grout: Mapei #42 - Mocha use
Grout line: 1/16"

Boundary of New Carpet

Note: All finishes to be installed by GC unless noted otherwise

1 Dance Floor panels
2 Existing Column


Floor Finish keyed notes

- 1 Dance Floor panels
- 2 Existing Column

Field Inspection consultation is available upon request. Call 303-739-7420 to request a consultation

Code violations that are found during inspection are required to be corrected. Permit issuance does not grant approval of a code violation.

Floor Transition Types

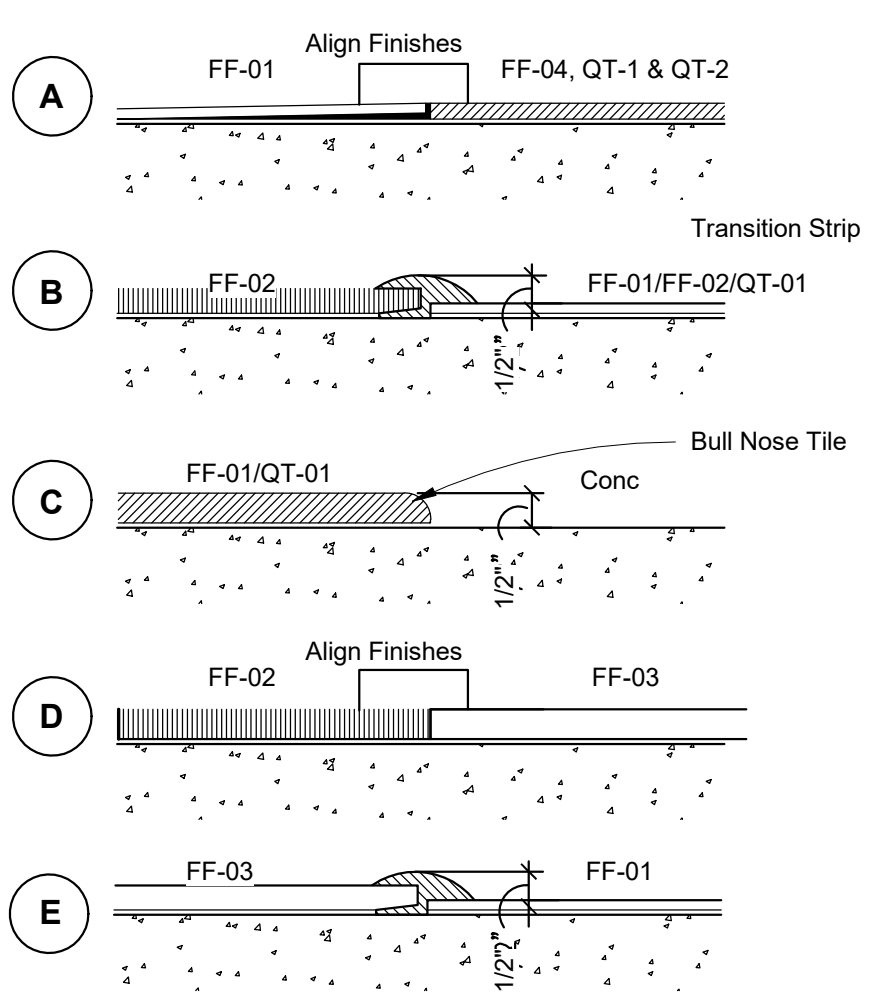

City of Aurora Building Division
Reviewed for Code Compliance
Approved as Noted: **Erick B.**
Date: **Jun 21, 2019**
2015 INTERNATIONAL CODES & 2017 NEC

RSN: 1369378
Permit #: 19-1625136




710

14005 E Exposition Ave.
Aurora, CO 80012

Owner:
CEC ENTERTAINMENT, INC.
Irving, TX 77063
ph: 972.258.5521
Contact: Walter Boyd
wboyd@cecentertainment.com

Architect:
PKWY Architects, LLC
1000 Civic Circle
Lewisville, TX 75067
Ph: 213.122.122
Contact: Greg Klimko

MEP Engineer:
Dialectic Engineering
310 W. 20 th street
200 Kansas City, MO 64108
ph: 816.997.9627
Contact: Joe Hillsbrenner, P.E.

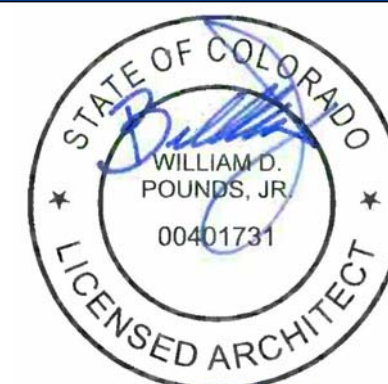


Architect: William D. Pounds

A	Permit Set	5/13/19
No.	Description	Date

DRAWN BY: RM/VG
CHECKED BY: DD
PROJ. NO: 08-19413
Copyright Parkway C&A, LP 2019 ©

Floor Finish Plan

A2.0

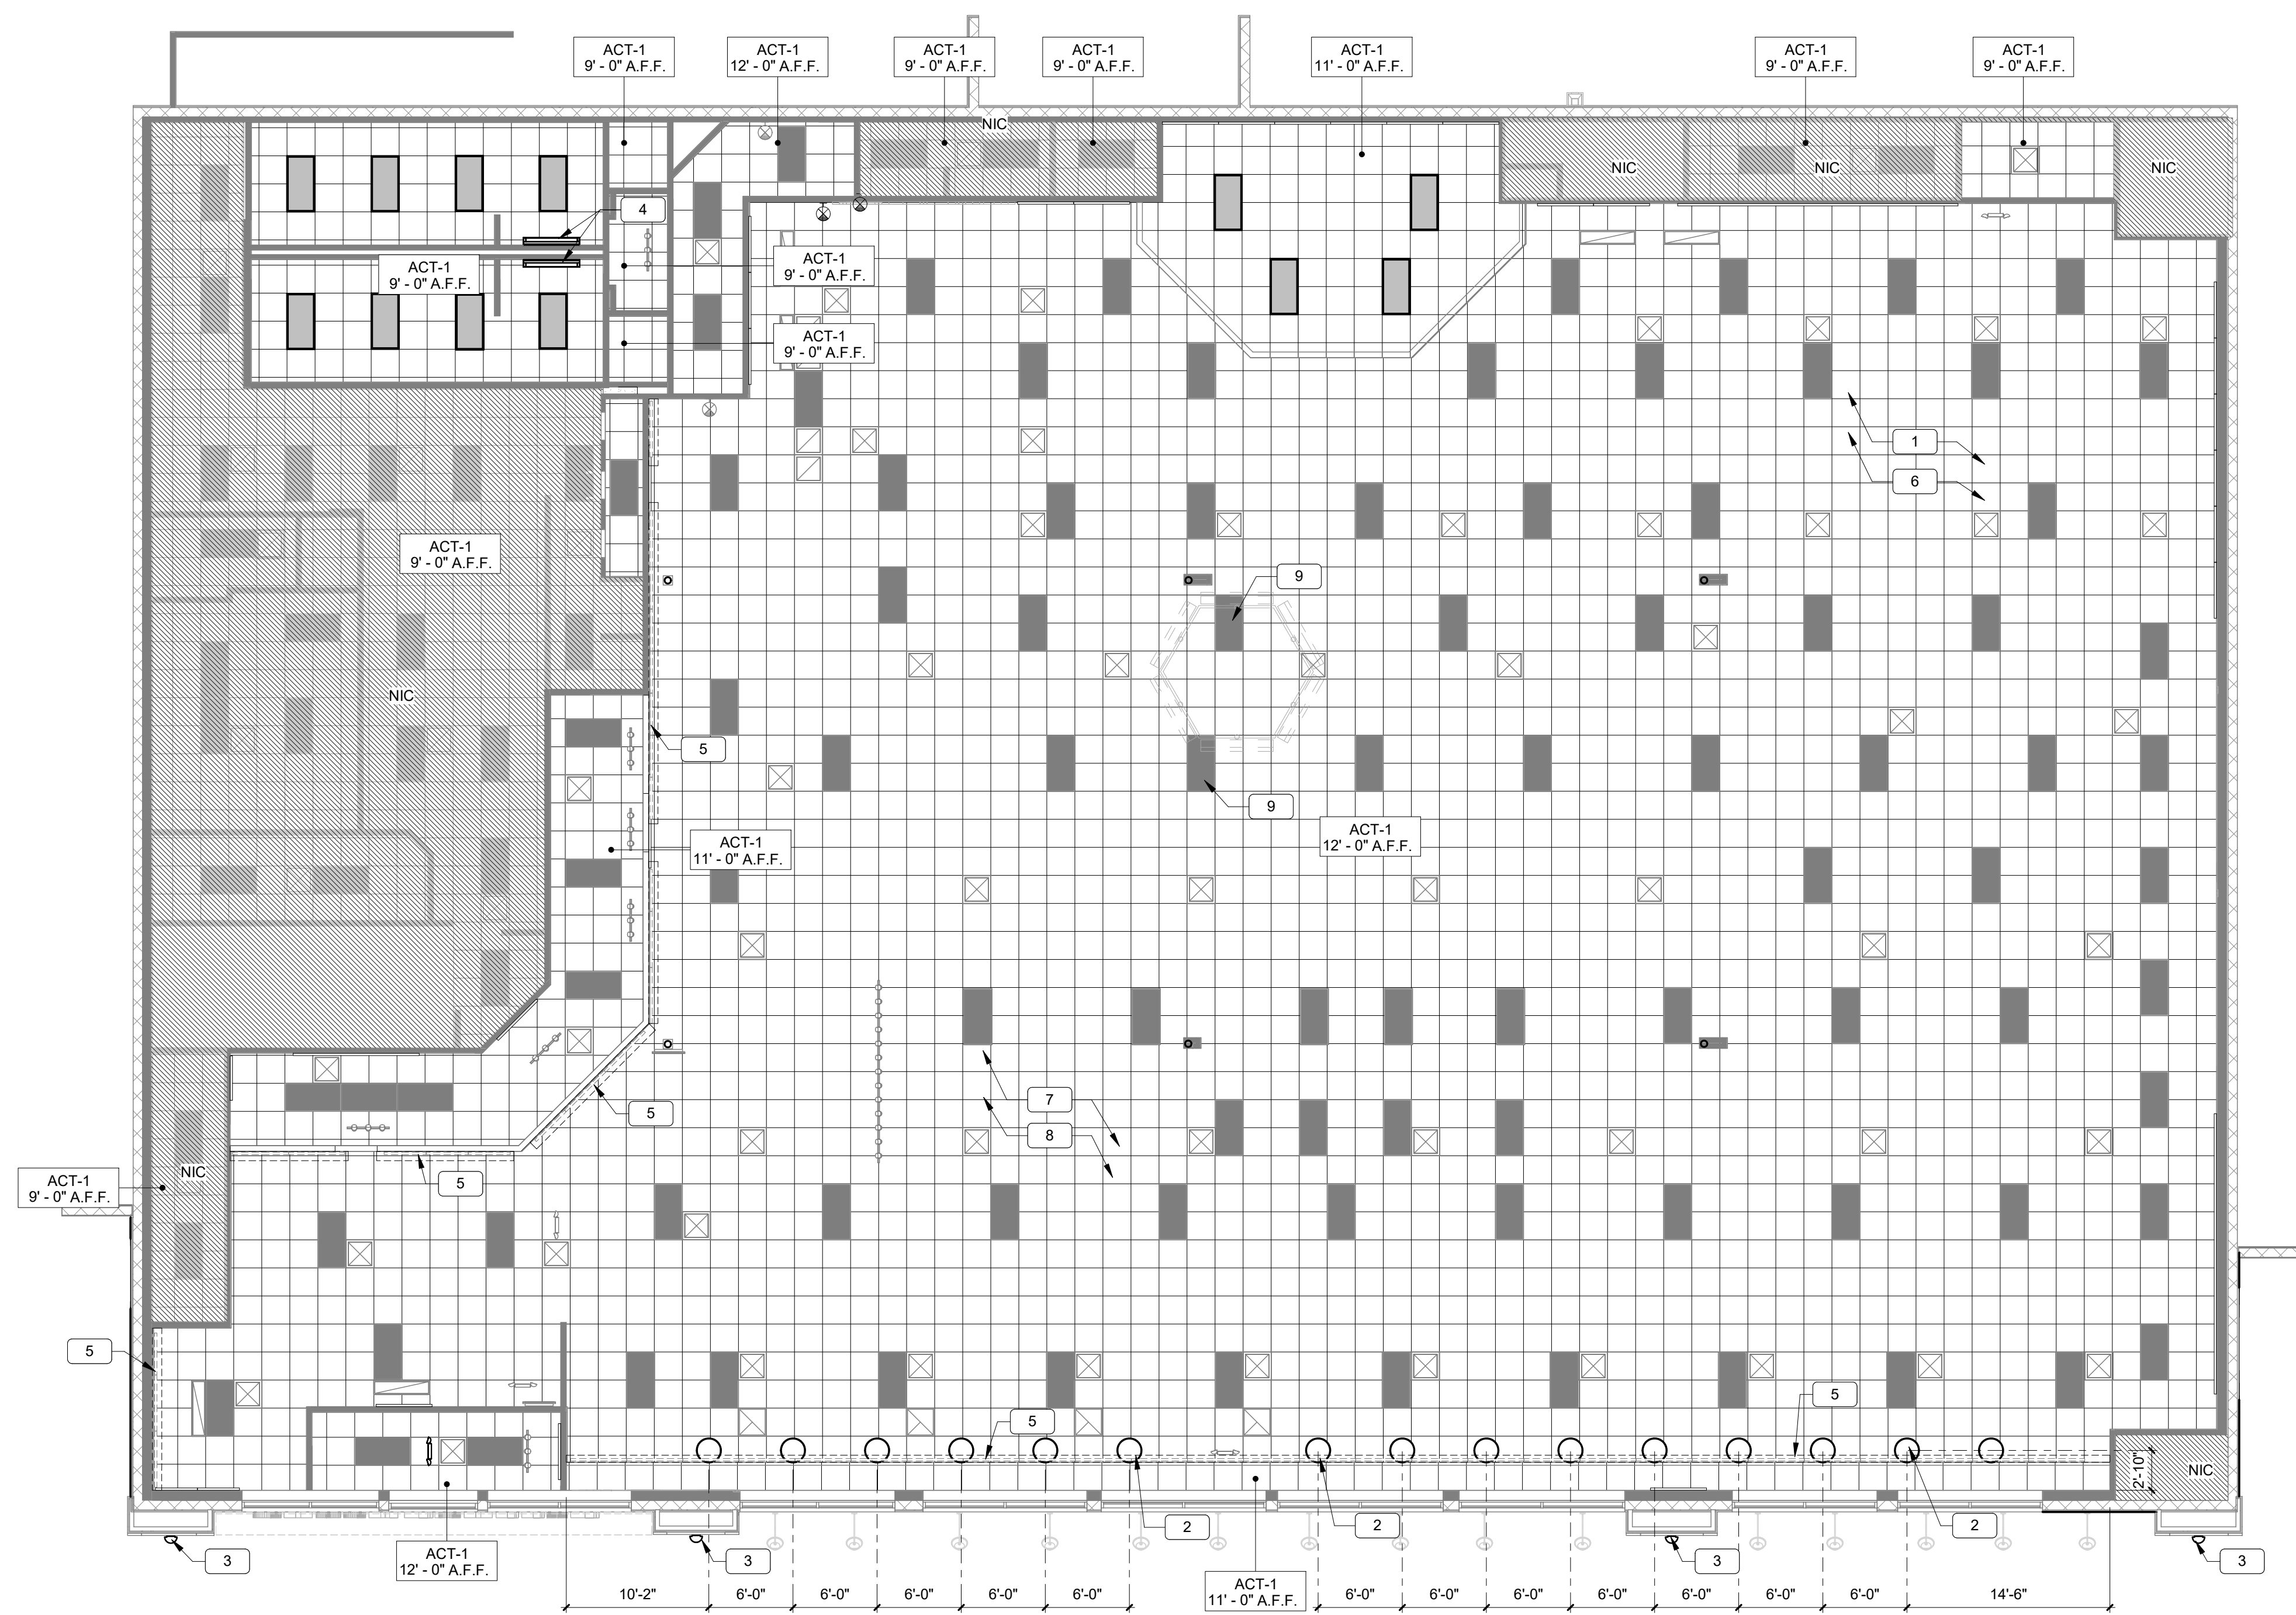

General Notes - Ceiling Plans

- | | |
|---|--|
| A | All dimensions are to face of stud unless noted otherwise. |
| B | Layout ceiling tile from center of room, both directions unless noted otherwise. |
| C | Sprinkler heads in suspended T-bar ceilings shall be centered in panels. |
| D | Ensure sprinkler head locations are clear of other ceiling fixtures and elements per plans |
| E | Coordinate all ductwork to avoid interference with ceiling support systems. |
| F | Light fixtures and HVAC diffusers shown on this drawing are for location and coordination purposes. |
| G | No fixtures, grilles, speakers, sprinkler heads, etc. shall touch the ceiling T's or shadow line; Center in panel. |
| H | Paint all grilles and recessed speakers to match ceiling grid. |
| K | All speakers wire to be run to control room rack. Ref. AVI sheet for connections. |
| K | Exit Signage to be installed per OSSC 1011. |
| L | Ceiling grid installation shall be per section 9.6 of ASCE 7-02 and CISCA guidelines for Seismic zones 3-4. |
| M | Refer to Detail for Typical light bracing requirements. |
| N | GC to field verify all existing light and mechanical fixtures. |
| O | GC is responsible for coordination and verification of power for signage/awning prior to installation. |
| P | All non-rated partition to terminate 6" above finish ceiling. See wall types, drawings for additional information. |
| Q | Coordinate all mechanical, electrical, and fire protection systems that are supported by interface w/ceiling systems. |
| R | All insulation wiring and other construction items shall be non-combustible and rated as required by code for work in plenum spaces where indicated. |

Legend - Reflected Ceiling Plan

- Legend:**

 - Gypsum ceiling
 - Acoustical lay-in ceiling
 - Exposed Structure, No Ceiling
 - Ceiling Finish Code
 - Ceiling Height (A.F.F.)
 - 24" x 48" Troffer
 - Can Light
 - Wall Washer
 - Suspended Incandescent Light
 - Pendant
 - Interior Wall Sconce
 - Exterior Wall Sconce
 - 48" Industrial Fluorescent Strip
 - Wall mount Television
 - Exit Sign
 - Supply Diffuser (Ref. Mechanical)
 - Return Diffuser (Ref. Mechanical)
 - Exhaust Diffuser (Ref. Mechanical)
 - Access Panel


RCP keyed notes

- 1 Replace ceiling tile, area indicate salvage undamage tile for use as replacement throughout
- 2 New pendant, centered above each table mount 6'-0" AFF to bottom of fixture, typ.
- 3 Replace existing exterior sconce with new fixture.
- 4 New Vanity light mount 7'-0" AFF to centerline.
- 5 Cove lights to remain, replace damaged light tubes as needed.
- 6 Install (10) 2x4 lights from show
- 7 Relocate of (10) Track lights
- 8 Installation, blocking, and decor, replace Ajax legal signage interior and exit
- 9 Relocate 2x4' Troffer Ligh

Provide a sign stating "EXIT" in raised, visual characters and braille adjacent to each door in an area of refuge, an exterior area for assisted rescue, an exit stairway or ramp, an exit passageway and the exit discharge.

2015 IBC 1013.4

 1 Reflected Ceiling Plan
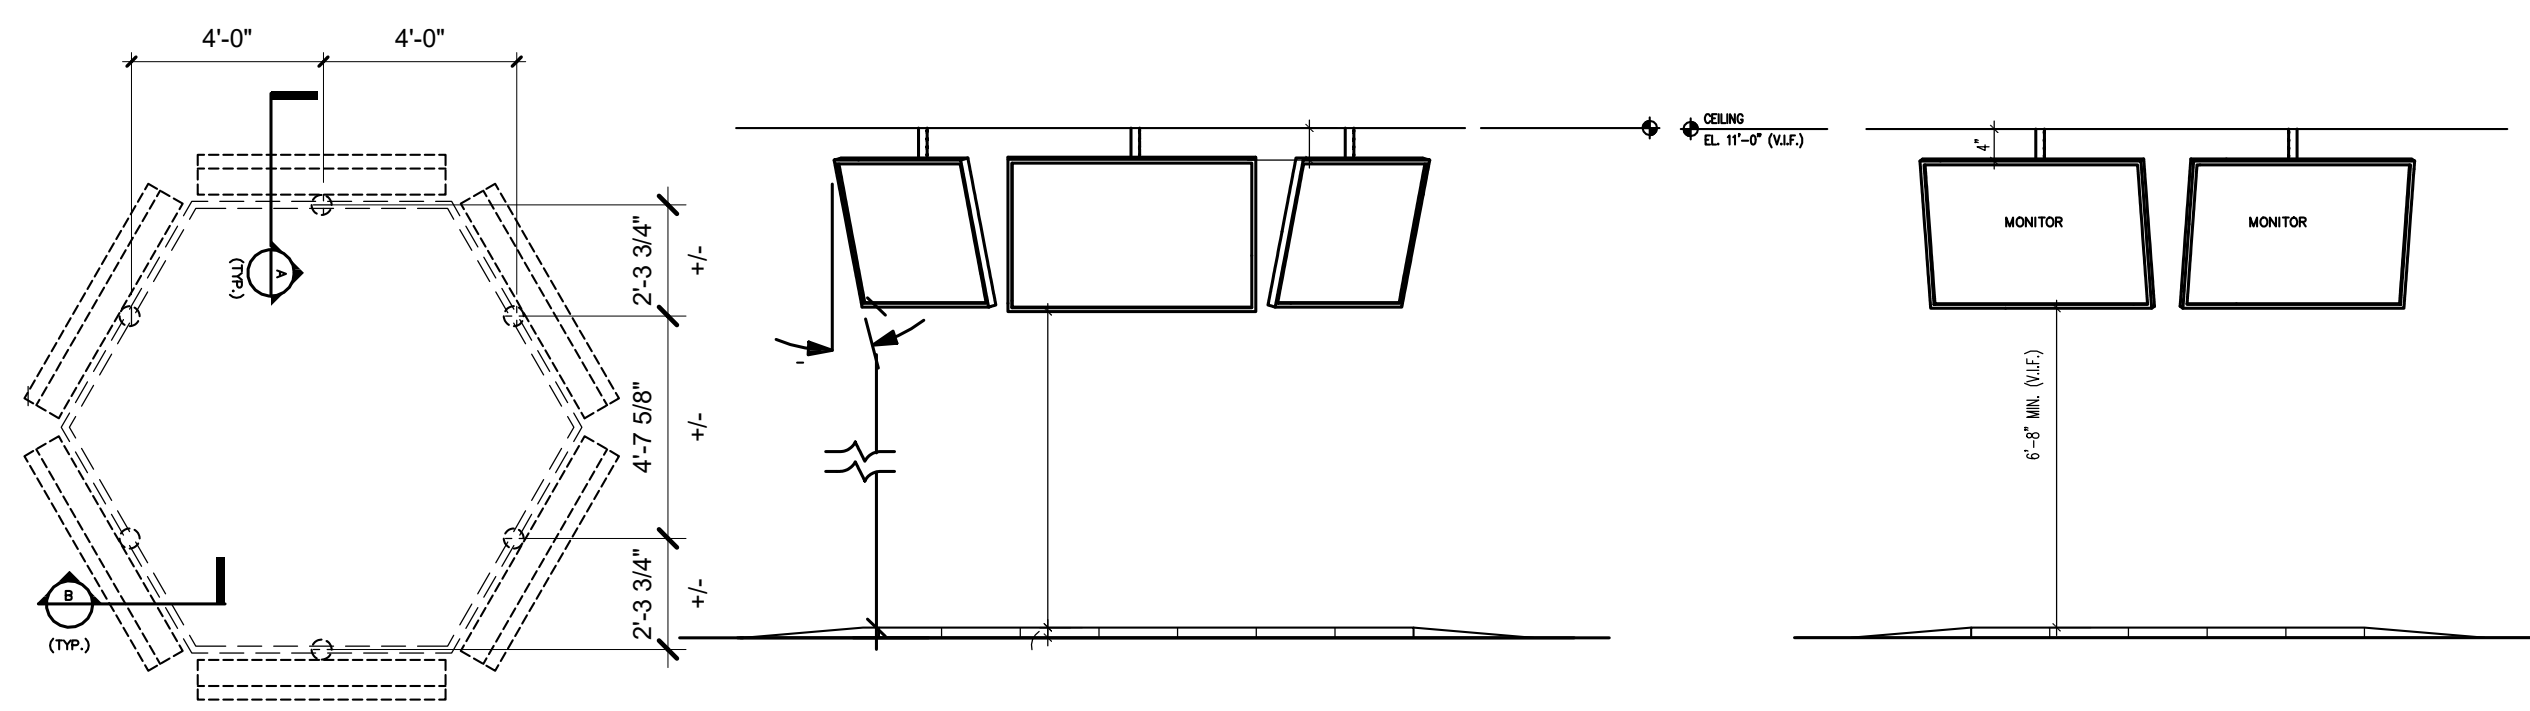
$$1/8" = 1'-0"$$


2 Monitor frame Detail

$$\frac{1}{4}'' = 1'-0''$$

3 Monitor frame side elevation

NTS


4 Monitor frame front elevation

NTS

5 Monitor Frame section A

$$1/4" = 1'-0"$$

6 Monitor Frame section B
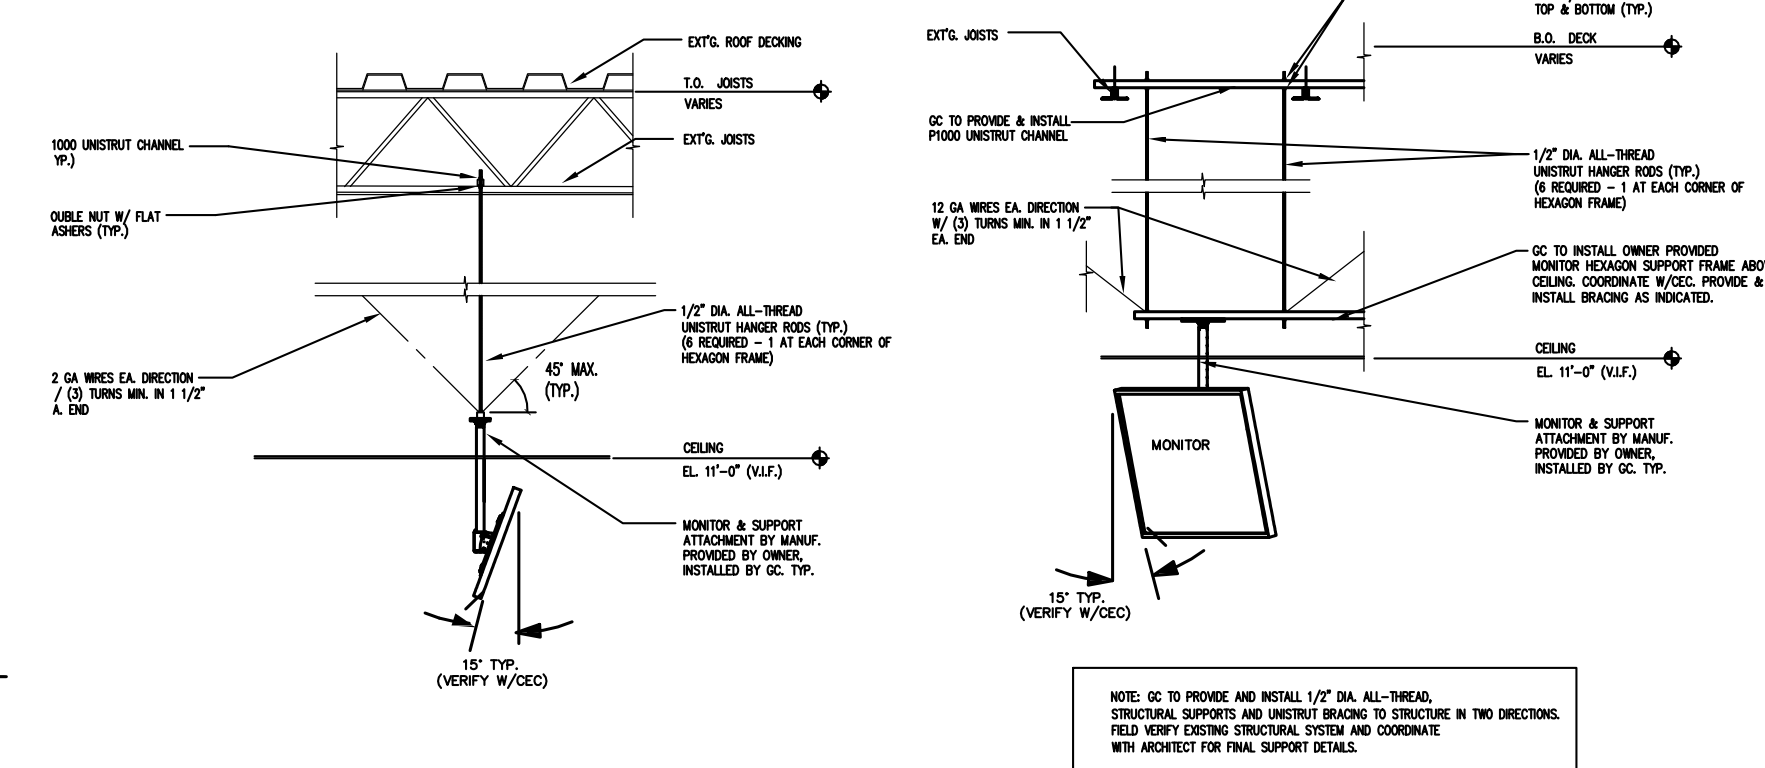
$$\frac{1}{4}'' = 1'-0$$


Code violations that are found during inspection are required to be corrected. Permit issuance does not grant approval of a code violation.

Field Inspection consultation is available upon request. Call 303-739-7420 to request a consultation



PKWY Architects, LLC
1000 Civic Circle Lewisville, TX 75067
arkwayconstruction.com (972) 221-1979

Project Manager:
Contact: Jeremy Blaido
(469)322-3732

Architect:
Contact: W.D. Pounds
(469)322-3714



710

14005 E Exposition Ave.
Aurora, CO 80012

Owner:
CEC ENTERTAINMENT, INC.
Irving, TX 77063
ph: 972.258.5521
Contact: Walter Boyd
wboyd@cecentertainment.com

Architect:
PKWY Architects, LLC
1000 Civic Circle
Lewisville, TX 75287
Ph: 213.122.122
Contact: Greg Klimko

MEP Engineer:
Dialectic Engineering
310 W. 20 th street
200 Kansas City, MO 64108
ph: 816.997.9627
Contact: Joe Hillebrenner, P.E.



5/13/19
Architect: William D. Pounds

A	Permit Set	5/13/19
No.	Description	Date

DRAWN BY: RM/VG
CHECKED BY: DD
PROJ. NO: 08-19413
Copyright Parkway C&A, LP 2019 ©


Reflected Ceiling Plan

A3.0




City of Aurora Building Division
Reviewed for Code Compliance
Approved as Noted: **Erick B.**
Date: **Jun 21, 2019**
2015 INTERNATIONAL CODES & 2017 NEC


RSN: 1369378
Permit #: 19-1625136

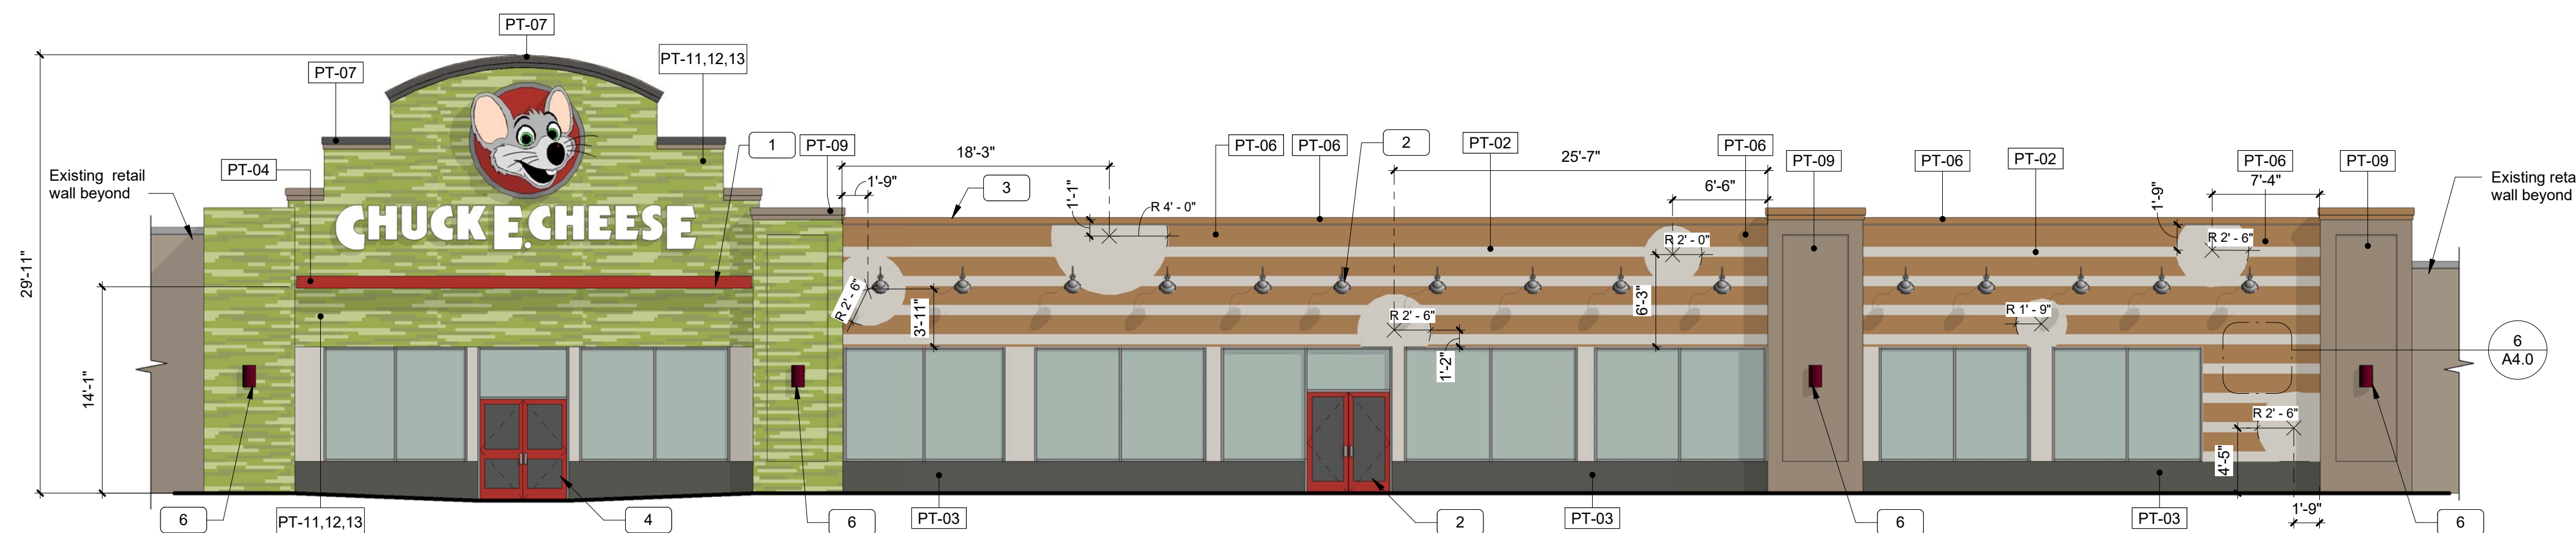


1 Exterior South Elevation
1/8" = 1'-0"

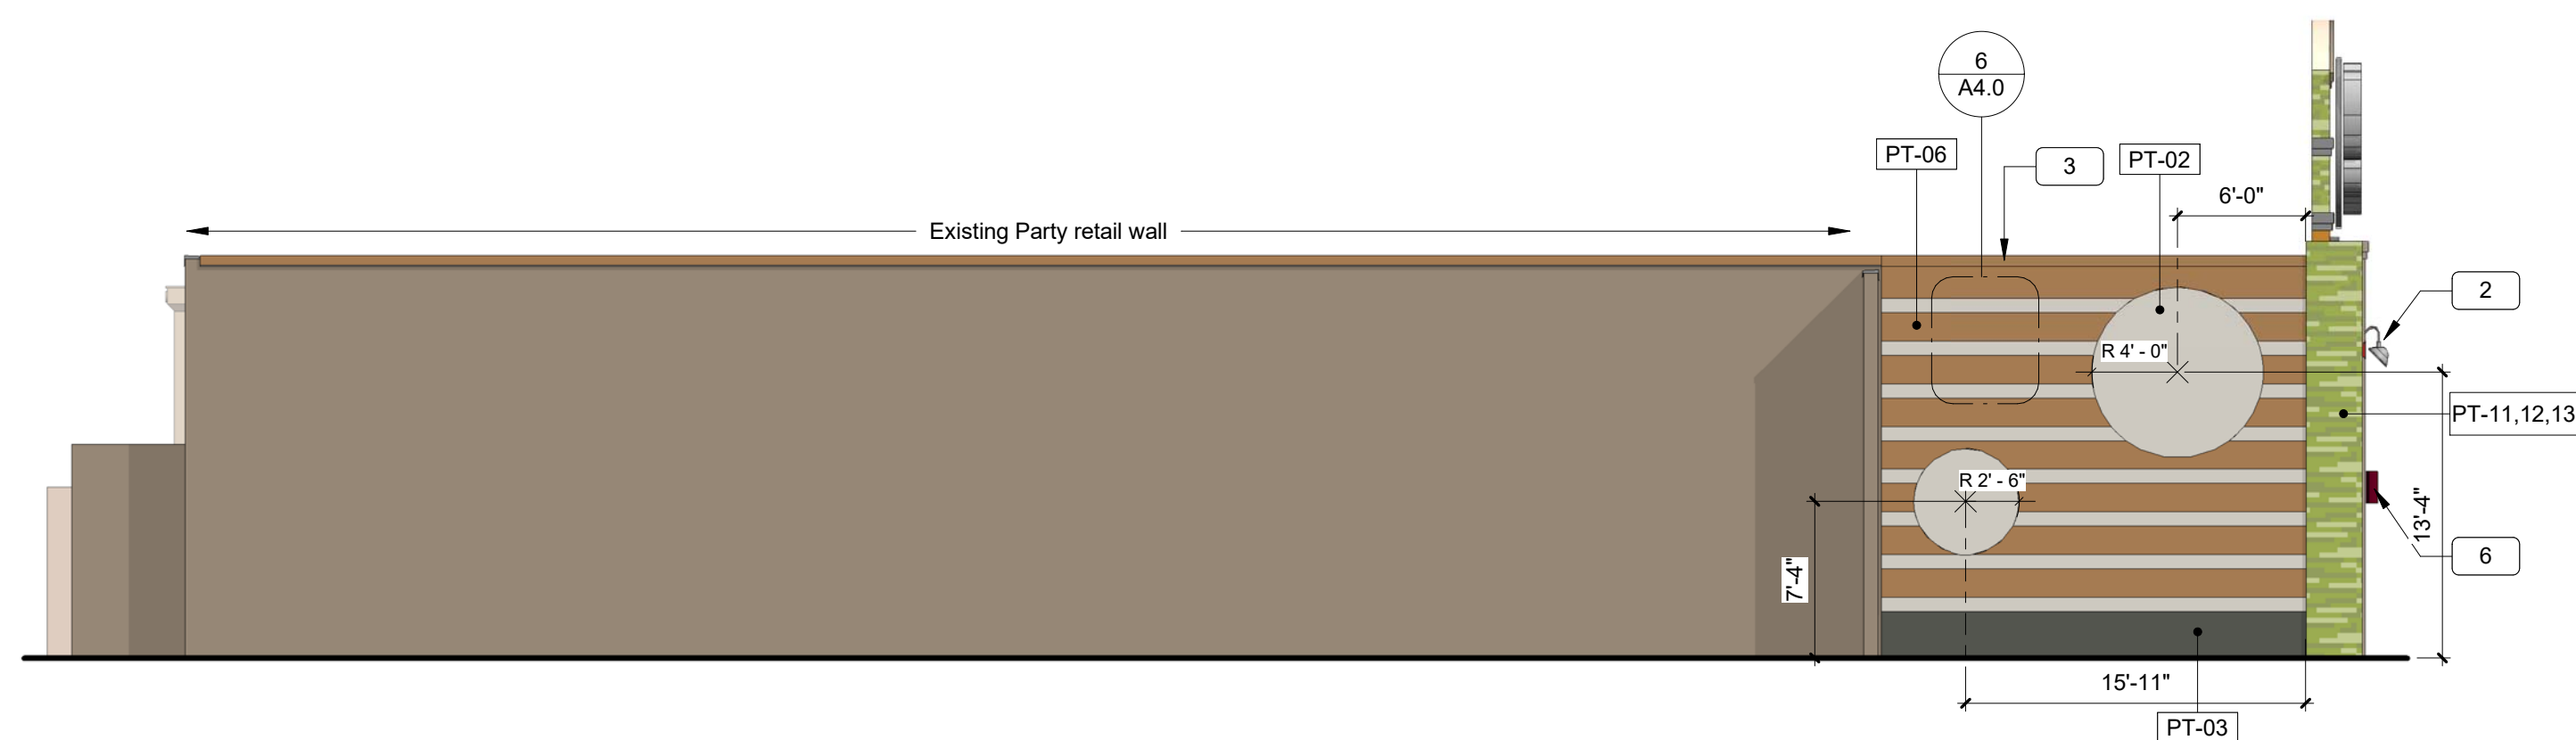

2 A201 West
1/8" = 1'-0"

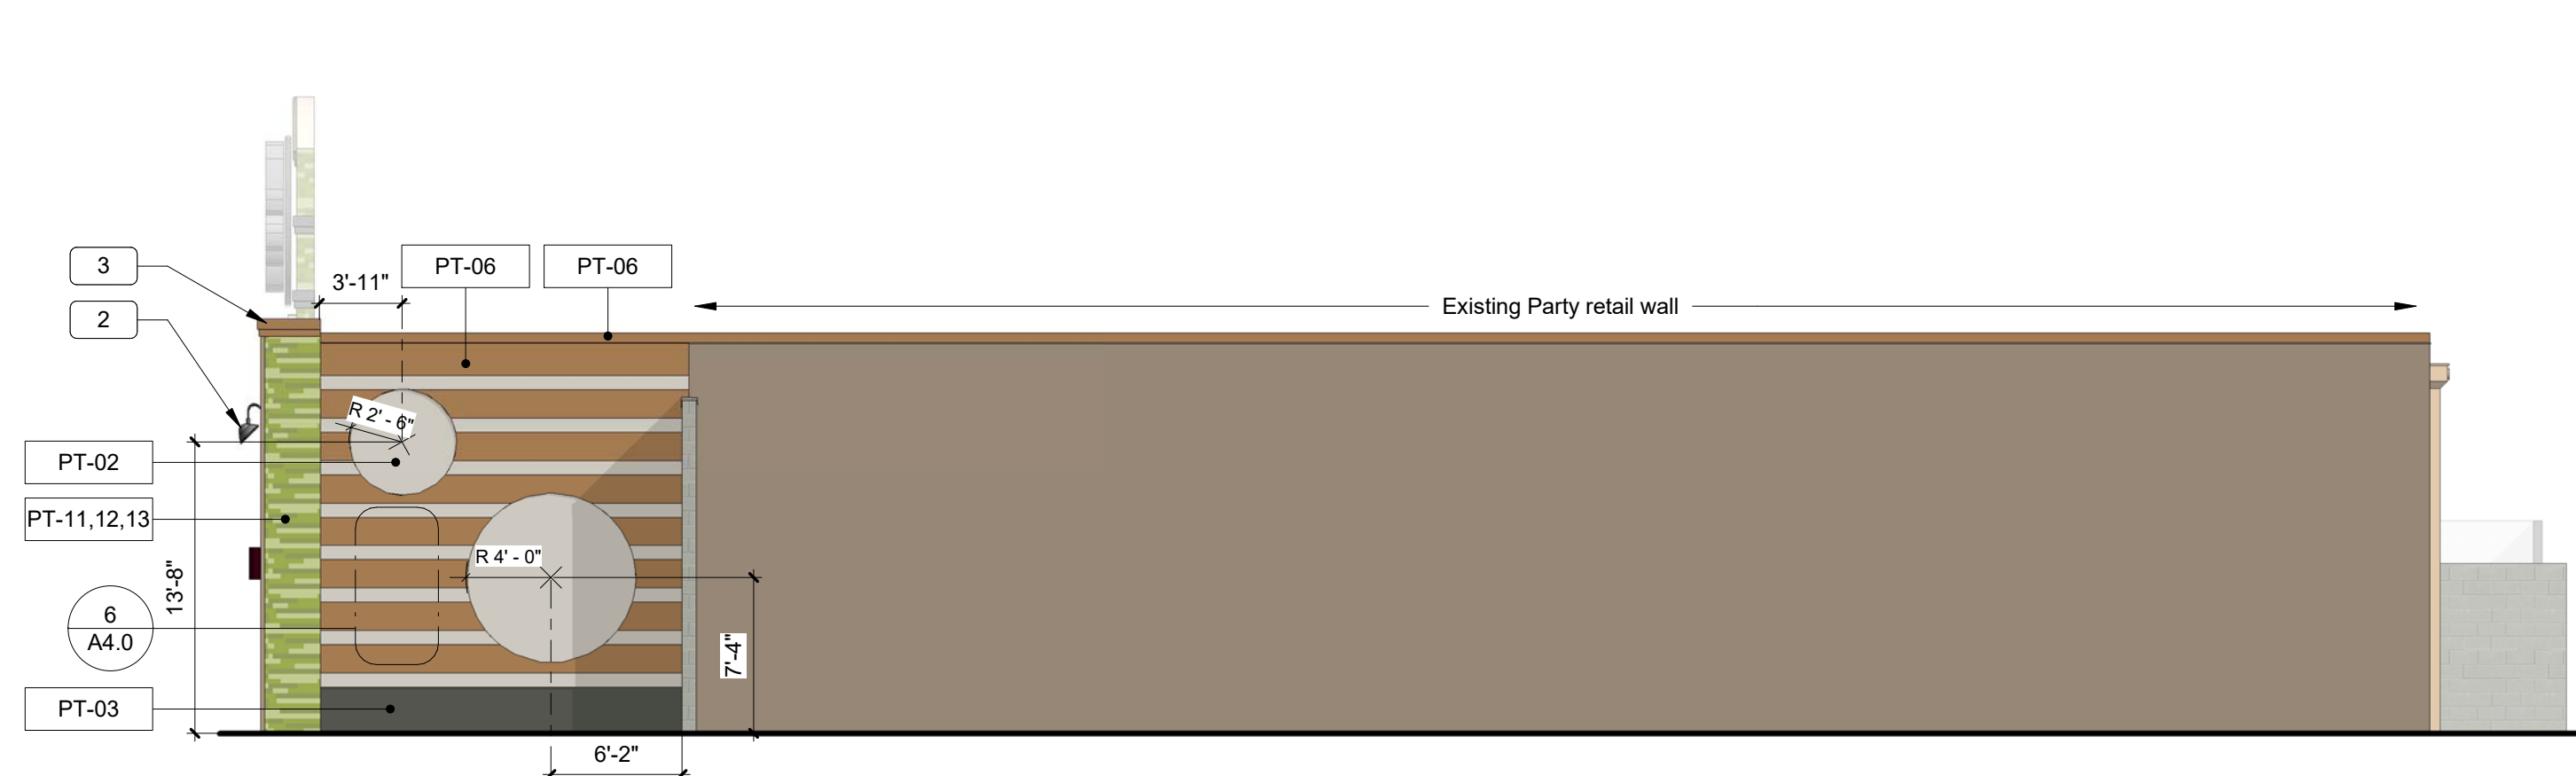

3 West Elevations

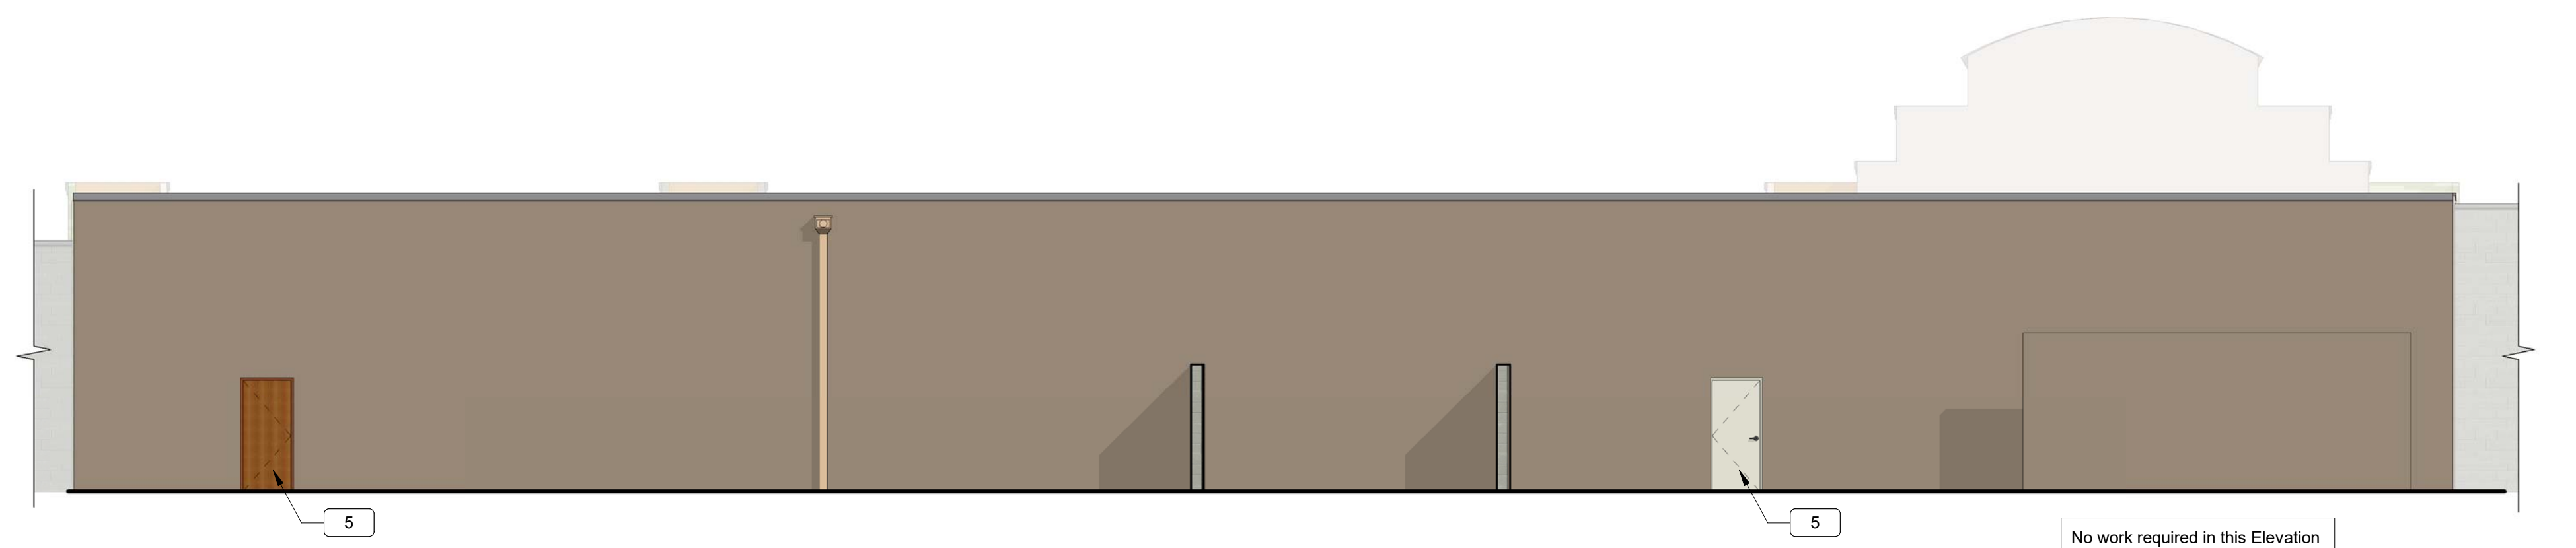

4 South
1/8" = 1'-0"

Elevation General Notes


A	Sign company shall obtain all required signage permits prior to installation of new work and repairs.
B	Painted fixtures; all downspouts, scuppers, electrical panels, grilles, conduits and piping, visible to public, shall be painted to match existing or adjacent material finish and banding, U.N.O. Unpainted items; do not point over security cameras, security/fire alarm bells and associate pumps and fittings and associated piping. Do not point over electrical and plumbing labels.
D	Vegetation: All plants, Tree, vegetation, garden beds and associated pathways to be protected from a physical or paint damage prior to painting. Plants to be trimmed and maintained per instructions from CEC Entertainment INC.
E	Fill holes and skins coats where ever signs, awnings and lights are to be demolished as well as areas where there are no signs.

Elevations keyed notes


1	Provide power, blocking for New "Accent eyebrow" refer detail
2	Wall Washer lights to remain
3	Patch from LED demo and paint parapet cap, typ
4	Doors to remain
5	Paint door match existing color
6	Install new wall lights

Paint Colors


Key Name	Manufacturer	Color	Color #	Finish
PT-01	Benjamin Moore	Alabaster	OC129	Eggshell
PT-02	Benjamin Moore	Balboa Mist	1549	Satin
PT-02A	Benjamin Moore	Cumulus Cloud	1550	Suede
PT-02B	Benjamin Moore	Lapomine Gray	1551	Suede
PT-02C	Benjamin Moore	River Reflections	1552	Suede
PT-03	Benjamin Moore	Ashwood Moss	1484	Satin
PT-04	Benjamin Moore	Million Dollar Red	2003-10	Eggshell
PT-05	Benjamin Moore	Sabre Grey	1482	Satin
PT-06	Benjamin Moore	Etruscan	AF-355	Satin
PT-07	Benjamin Moore	Iron Mountain	2134-30	Satin
PT-08	Sherwin Williams	Extra White	SW7006	Satin
PT-09	Benjamin Moore	Cabot Trail	998	Satin
PT-10	Sherwin Williams	Latte	SW6108	Satin
PT-11	Benjamin Moore	Sycamore Tree	539	Satin
PT-12	Benjamin Moore	Shades of Spring	537	Satin
PT-13	Benjamin Moore	Huntington Green	406	Satin
PT-14	Sherwin Williams	Outrageous Green	SW6922	Satin
PT-15	Benjamin Moore	Palm Coast Teal	733	Satin
PT-16	Benjamin Moore	Scandinavian Blue	2068-30	Satin
PT-17	Sherwin Williams	Real Reef	SW6368	Satin
PT-18	Benjamin Moore	Golden Nugget	2019-20	Satin
PT-19	Benjamin Moore	Deep Ocean	2058-30	Satin
PT-20	Benjamin Moore	Danville Tan	HC-91	Satin
PT-21	Sherwin Williams	Sand	SW2059	Satin
PT-E	Benjamin Moore	Match Existing		
ST-03	Sherwin Williams	Match Existing		

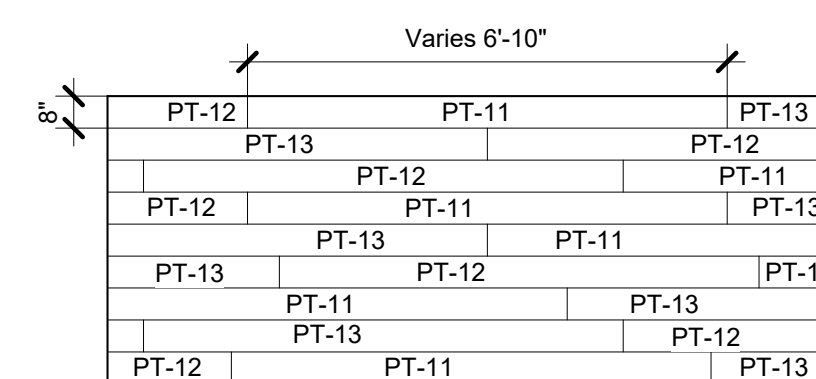

5 Green Stripe Detail

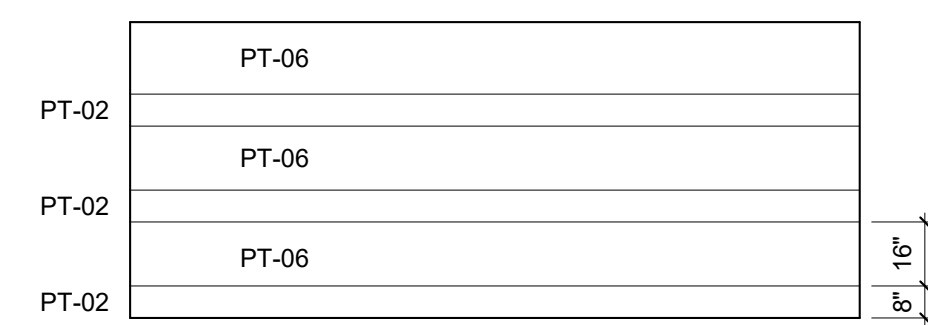

6 Tan Stripe Detail
1/4" = 1'-0"

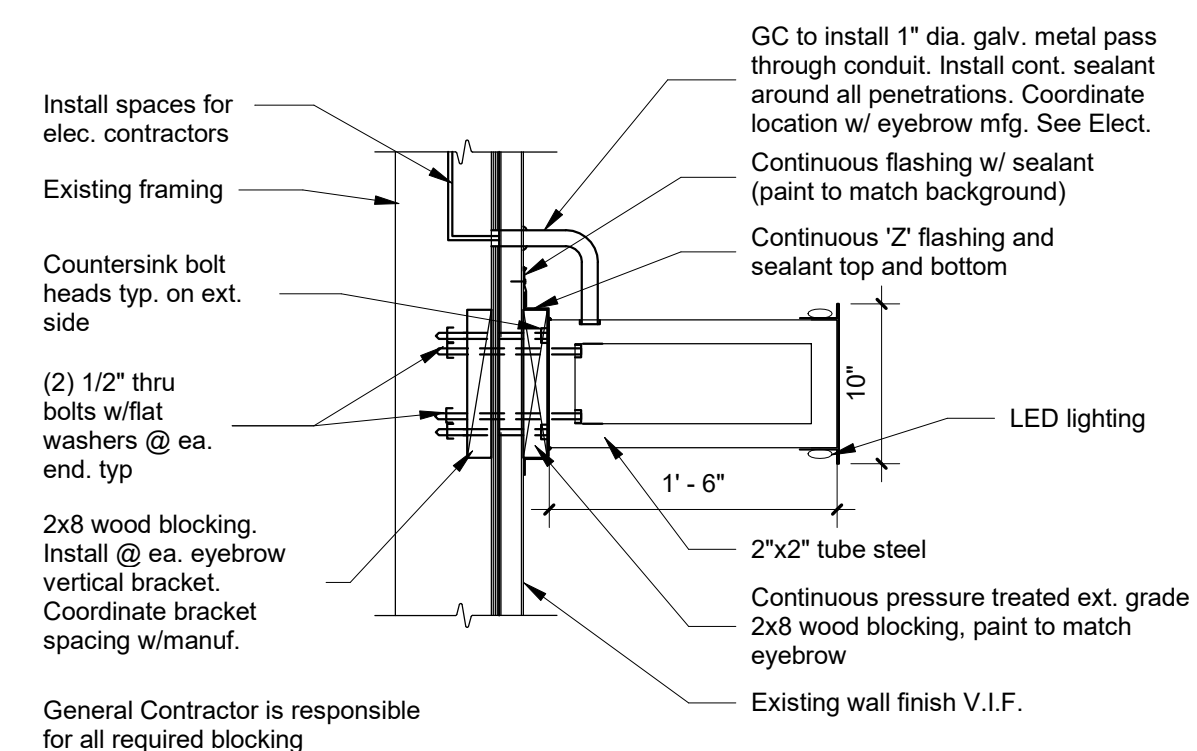

7 Eyebrow Section type
1" = 1'-0"

RSN: 1369378
Permit #: 19-1625136




710

14005 E Exposition Ave.
Aurora, CO 80012

Owner:
CEC ENTERTAINMENT, INC.
Irving, TX 77063
ph: 972.258.5521
Contact: Walter Boyd
wboyd@cecentertainment.com

Architect:
PKWY Architects, LLC
1000 Civic Circle
Lewisville, TX 75287
Ph: 213.122.122
Contact: Greg Klimko

MEP Engineer:
Dialectic Engineering
310 W. 20 th street
200 Kansas City, MO 64108
ph: 816.997.9627
Contact: Joe Hillebrenner, P.E.

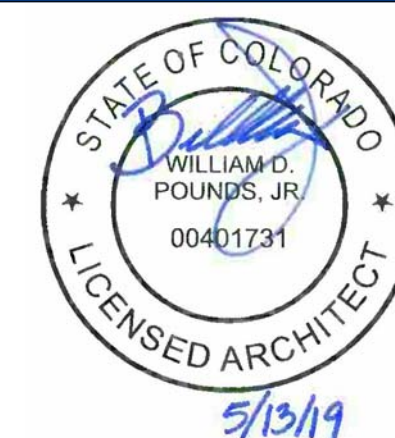


Architect: William D. Pounds

A	Permit Set	5/13/19
No.	Description	Date


DRAWN BY: RM/VG
CHECKED BY: DD
PROJ. NO: 08-19413
Copyright Parkway C&A, LP 2019 ©

Exterior Elevations


A4.0

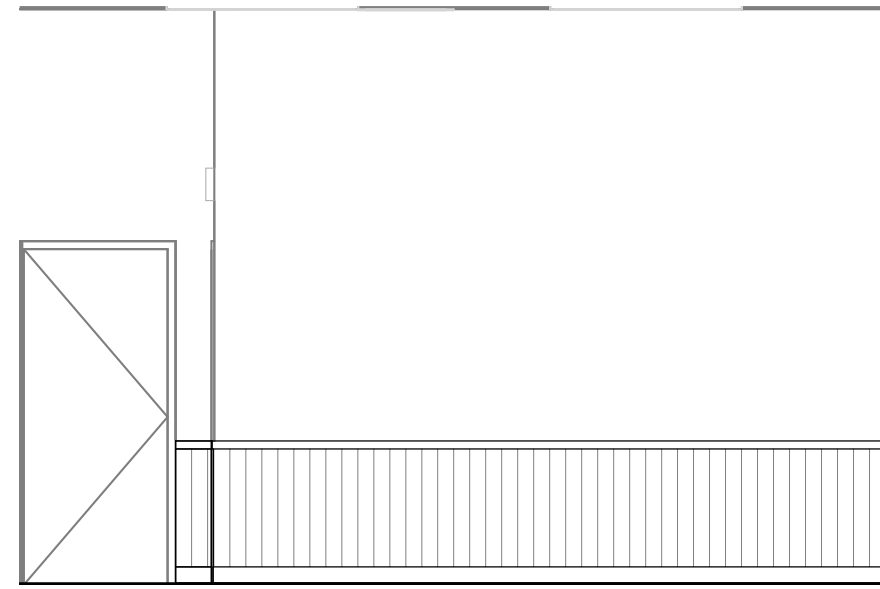

1 Interior Elevation

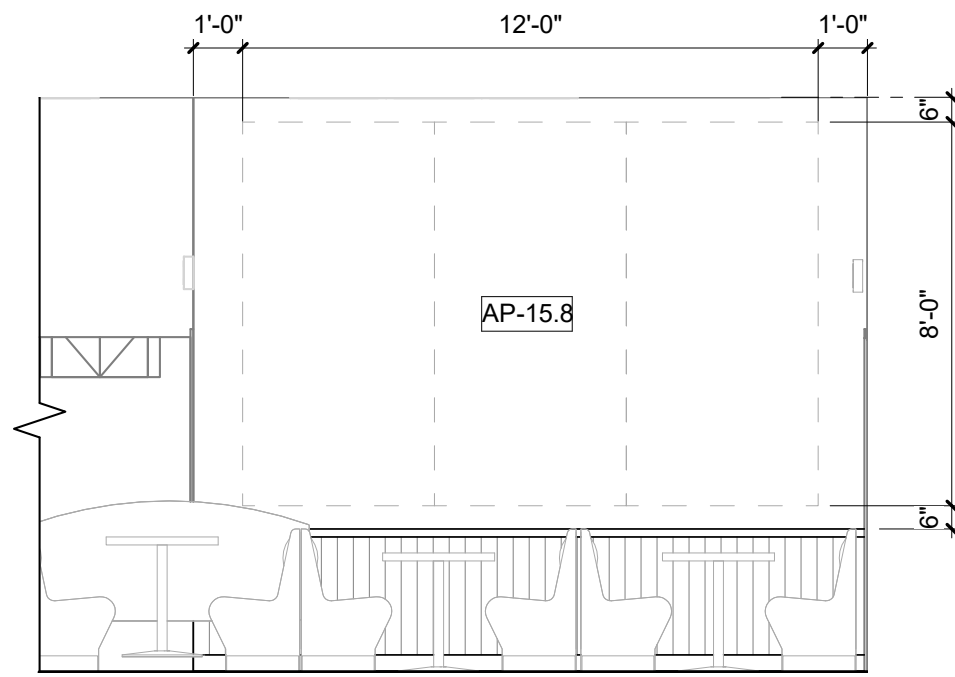

2 Interior Elevation
1/4" = 1'-0"

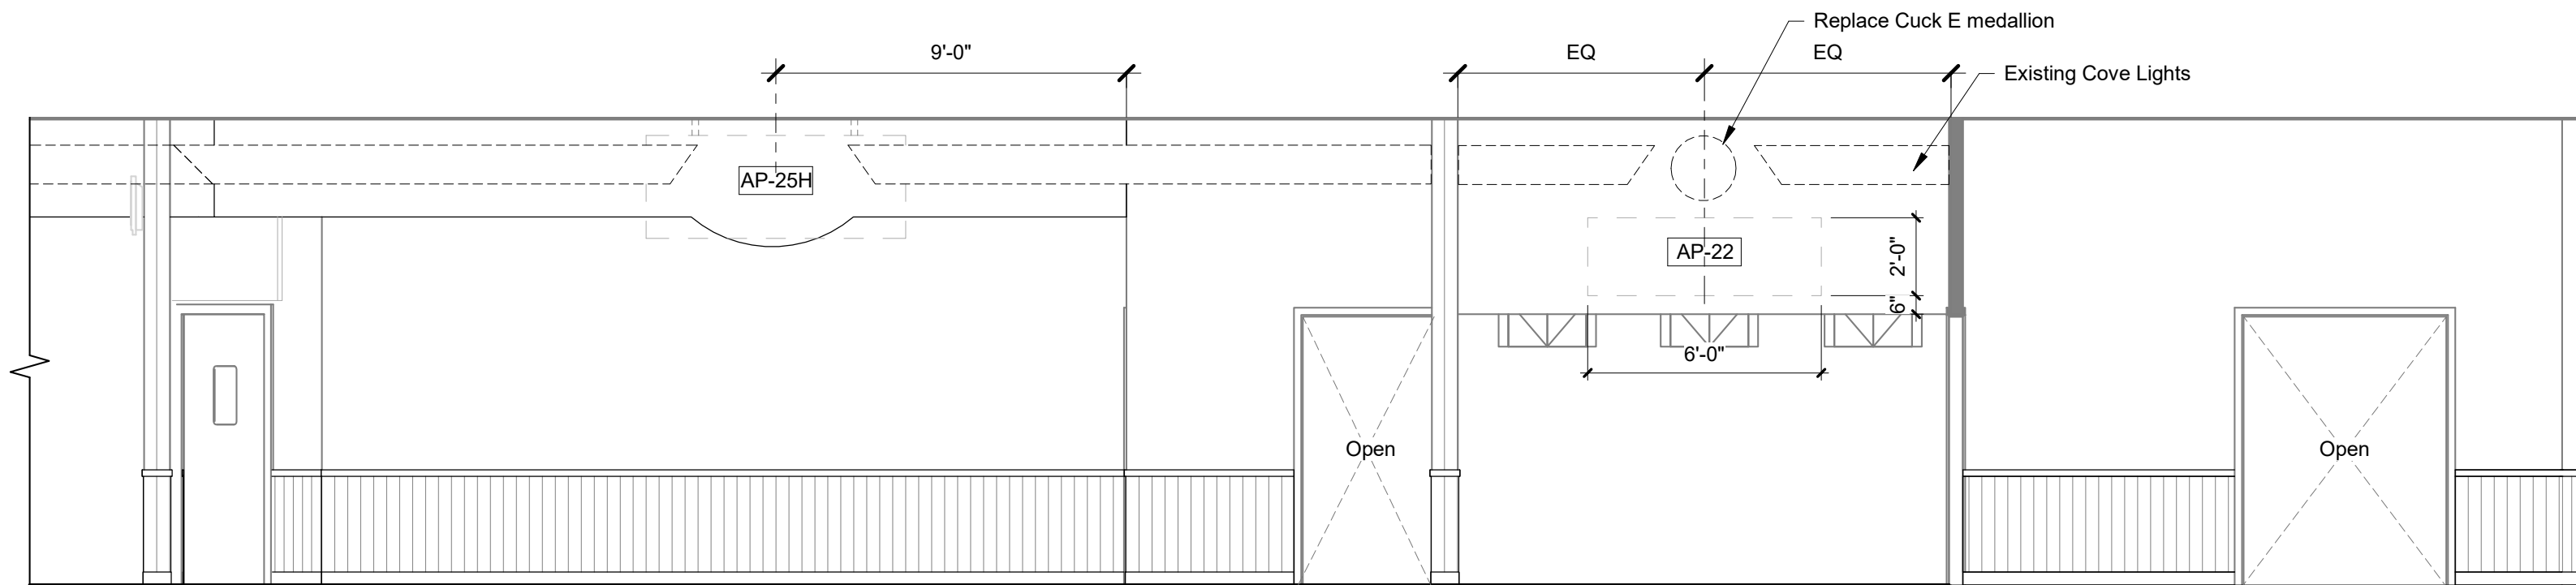

3 Interior Elevation

General Notes - Interior Finish	
A	Ensure surfaces to receive finishes are clean, true and free of irregularities. Do not proceed with work until unsatisfactory conditions have been corrected.
B	No finish substitutions may be made without prior written authorization by Architect.
C	All finishes shall be applied in strict accordance with manufacturer's specifications.
D	Provide temporary protection for all installed finishes as work progresses.
E	Submit samples of finishes for approval prior to installation.
F	All paint shall be applied in accordance with the manufacturer's specifications for that particular surface.
G	Examine walls to ensure proper preparation before application of paint. Beginning work implies acceptance of condition.
H	Comet Signs, to provide resized acrylic wall art. Install by GC. Coordinate final installation with CEC.
J	GC to install plastic corner guards at public areas.
K	Comet Signs to field verify wall dimensions on all walls receiving acrylic prior to final design and installation.
L	Refer to A8.0 Interior Finish Schedule.
M	Save table bases Typ.
N	Install surface mounted blocking opaque acrylics. Paint blocking to match wall color.

CONSTRUCTION • ARCHITECTURE

PKZ

PKWY Architects, LLC
1000 Civic Circle Lewisville, TX 75067
parkwayconstruction.com (972) 221-1979

Architect:

Contact: W.D. Pounds
(469)322-3714



710

14005 E Exposition Ave.
Aurora, CO 80012

Owner:

CEC ENTERTAINMENT, INC.
Irving, TX 77063
ph: 972.258.5521
Contact: Walter Boyd
wboyd@cecentertainment.com

Architect:

PKWY Architects, LLC
1000 Civic Circle
Lewisville, TX 75287
Ph: 213.122.122
Contact: Greg Klimko

MEP Engineer:



NOT FOR REGULATORY APPROVAL
PERMITTING OR CONSTRUCTION.

Architect: William D. Pounds

A	Permit Set	5/13/19
No.	Description	Date

DRAWN BY: RM/VG

CHECKED BY: DD

PROJ. NO: 08-19413

Copyright Parkway C&A, LP 2019 ©

Interior Elevations

A5.1




City of Aurora Building Division
Reviewed for Code Compliance
Approved as Noted: **Erick B.**
Date: **Jun 21, 2019**
2015 INTERNATIONAL CODES & 2017 NEC

RSN: 1369378
Permit #: 19-1625136


Code violations that are found during inspection are required to be corrected. Permit issuance does not grant approval of a code violation.

Field Inspection consultation is available upon request. Call 303-739-7420 to request a consultation

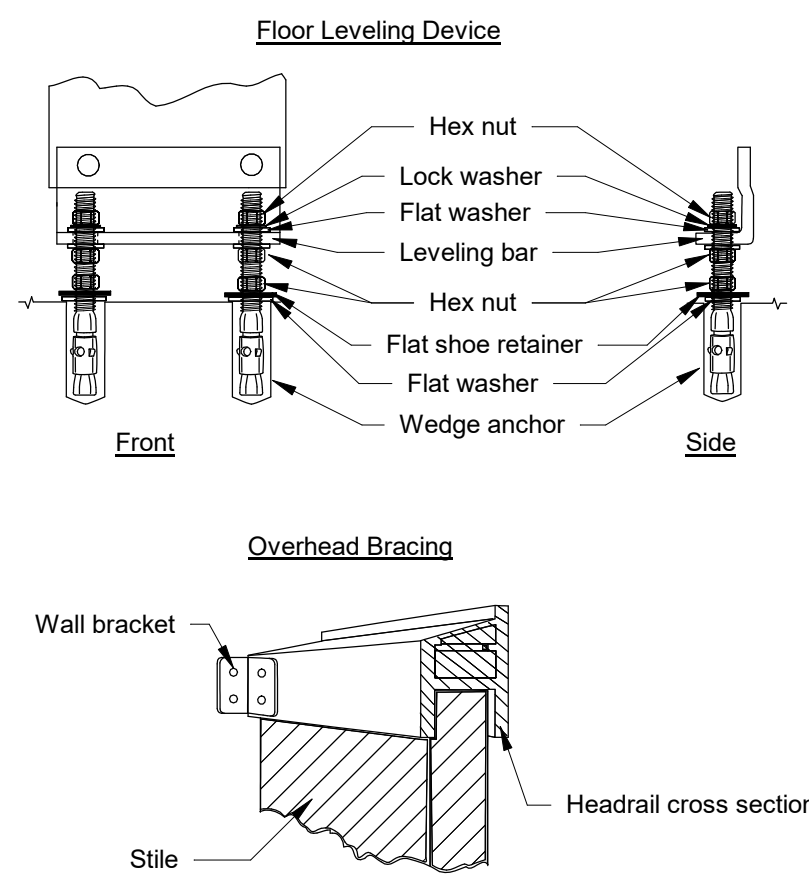


Blocking Notes:

- Blocking conditions shown do not account for all conditions that may exist on the project. The contractor is to account for all blocking indicated in entire contract document package or specifically req'd by the manufactures of specified products & materials
- The contractor shall walk the site to finalize all locations of blocking in walls/ceiling prior to installation of gypsum wallboard.
- Coordinate the exact required linear footage and locations of blocking with each specific fixture. Accessory, equipment, casework, and millwork. The contractor is to coordinate with millwork on all items to be supplied and/or installed by CEC.
- Where exact location of item requiring blocking will not be determined until after installation of the gypsum wallboard, extend blocking a min. of 12" beyond each side the estimated location of the designated item as indicated in the plans or as specified by manufacturer.
- All blocking is to be continuous along the full length of the item requiring blocking unless noted otherwise or indicated by manufacturer.
- Where specific code related or manufacturer load requirements are required, the contractor is to confirm the installation of the required blocking meets or exceeds the requirements of the code.

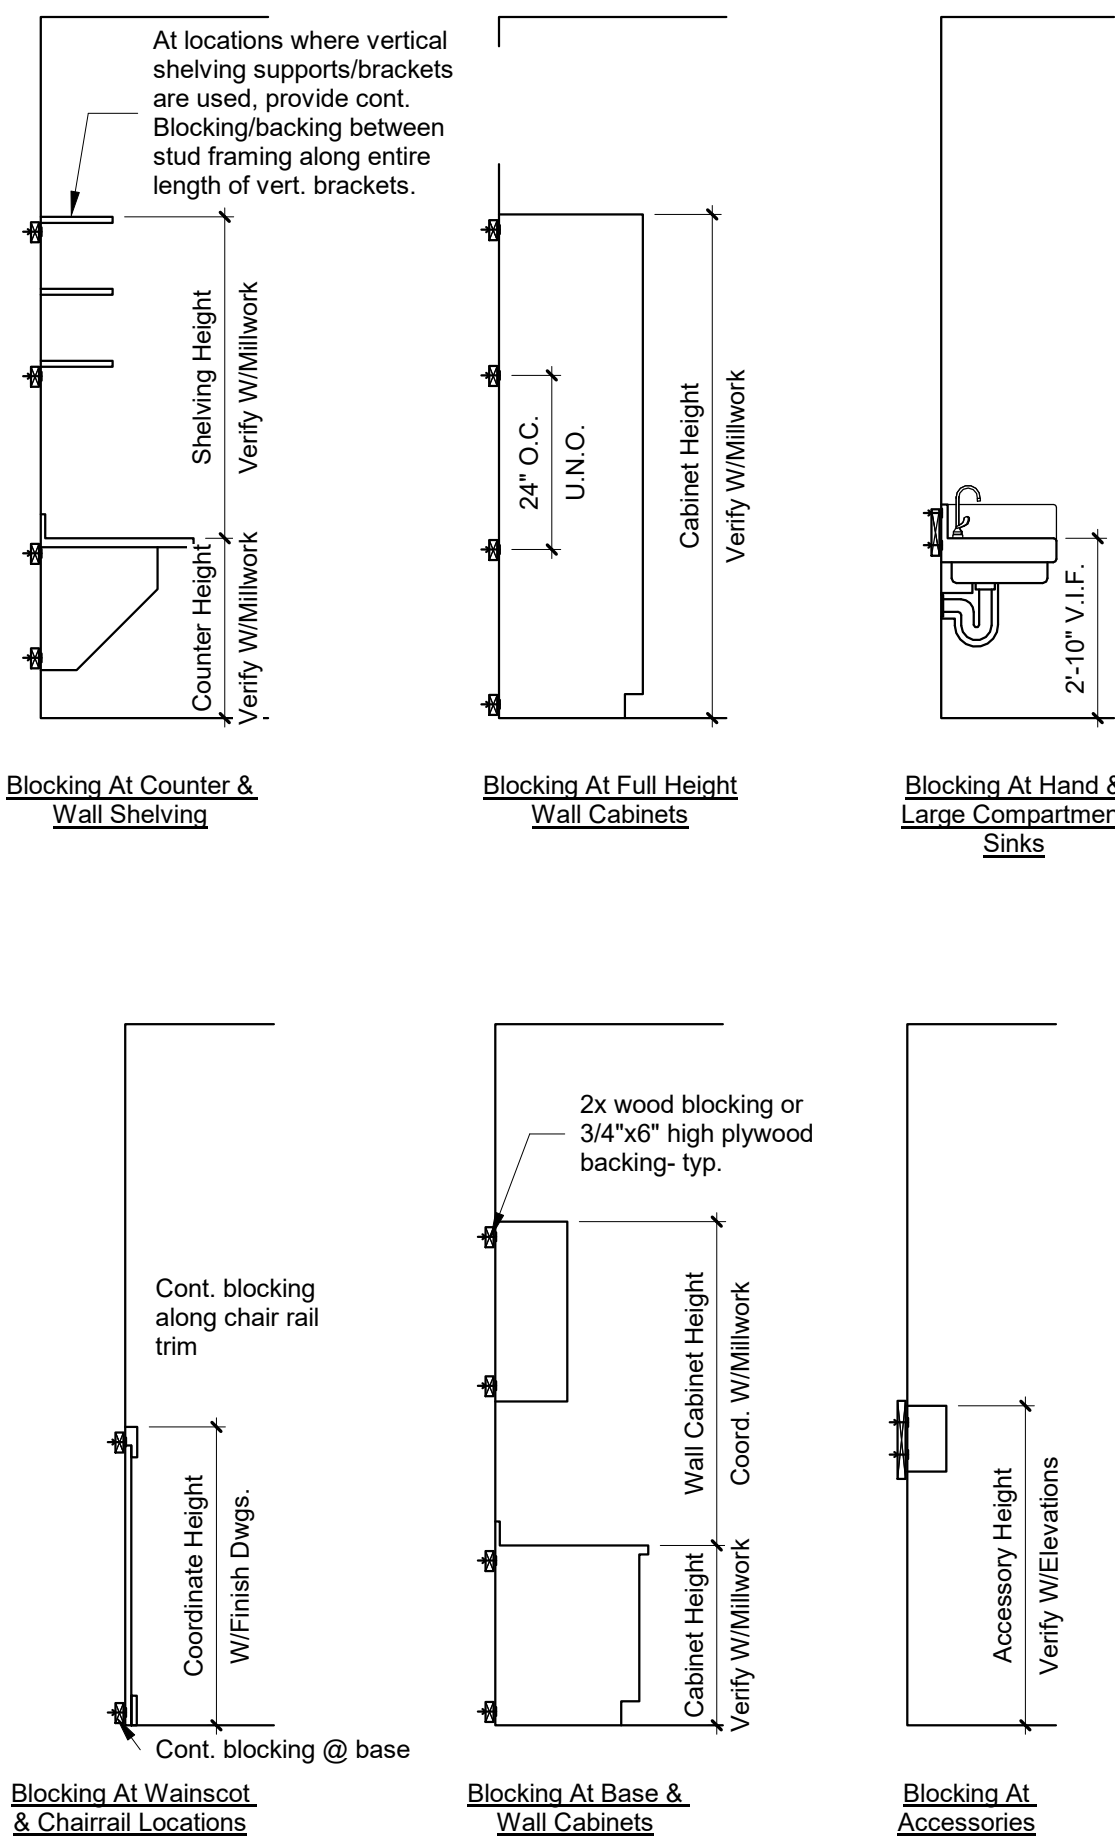


NOTE:
EXISTING WALL CONSTRUCTION
ASSUMED TO BE 5/8" GREEN BOARD
WITH 1/4" TILE APPLIED TO STUD
FRAMING.

NOTE:
ALL TUBING TO BE 2X2 S.Q. 16GA. COLD
ROLL STEEL. CAP ALL EXPOSED ENDS
OF TUBE. ALL CORNERS TO BE
MITERED, FULLY WELDED AND GROUND
SMOOTH. POWDER COAT - COLOR TO
MATCH PAINT ALMOND.

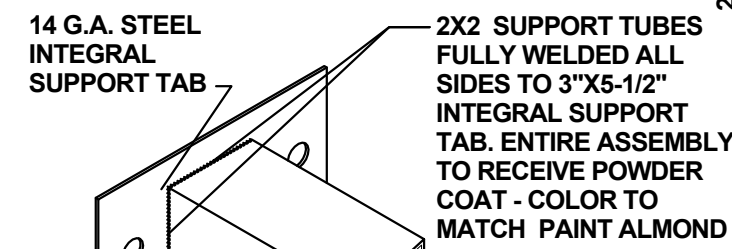


INTEGRAL SUPPORT TAB ISO

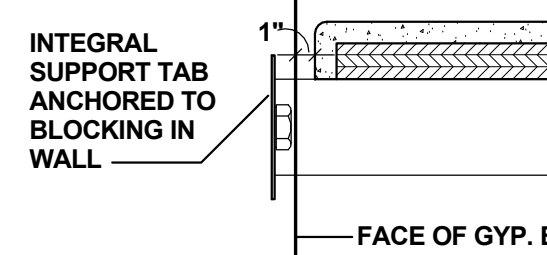


INTEGRAL SUPPORT TAB

SINK FAUCET & HARDWARE SPEC:
WILSONART BV123 COLOR: (CREAM 1572-SL) INTEGRAL
MOUNT LAV. WITH AMERICAN STANDARD MONTERREY NO.
5502.170 FAUCET WITH CONVENTIONAL SPOUT, GRID DRAIN,
WITH 4 IN. WRIST BLADE HANDLES, 002 17 GA. CHROME
FINISH, MCGUIRE SUPPLIES AND STOPS, 1 1/4 IN. P-TRAP,
HANDICAP ACCESSIBLE.

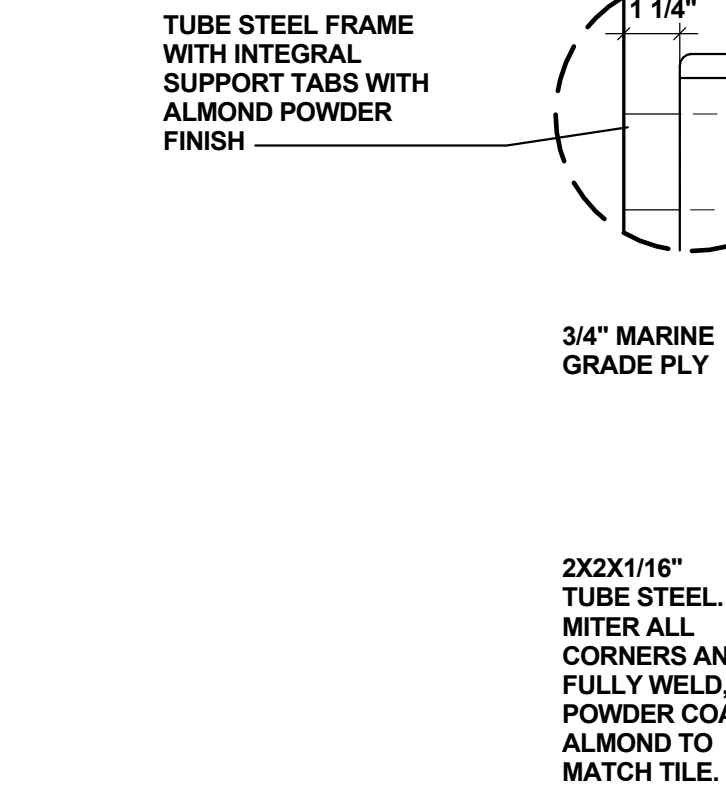

3 Sink Detail

1" = 1'-0"

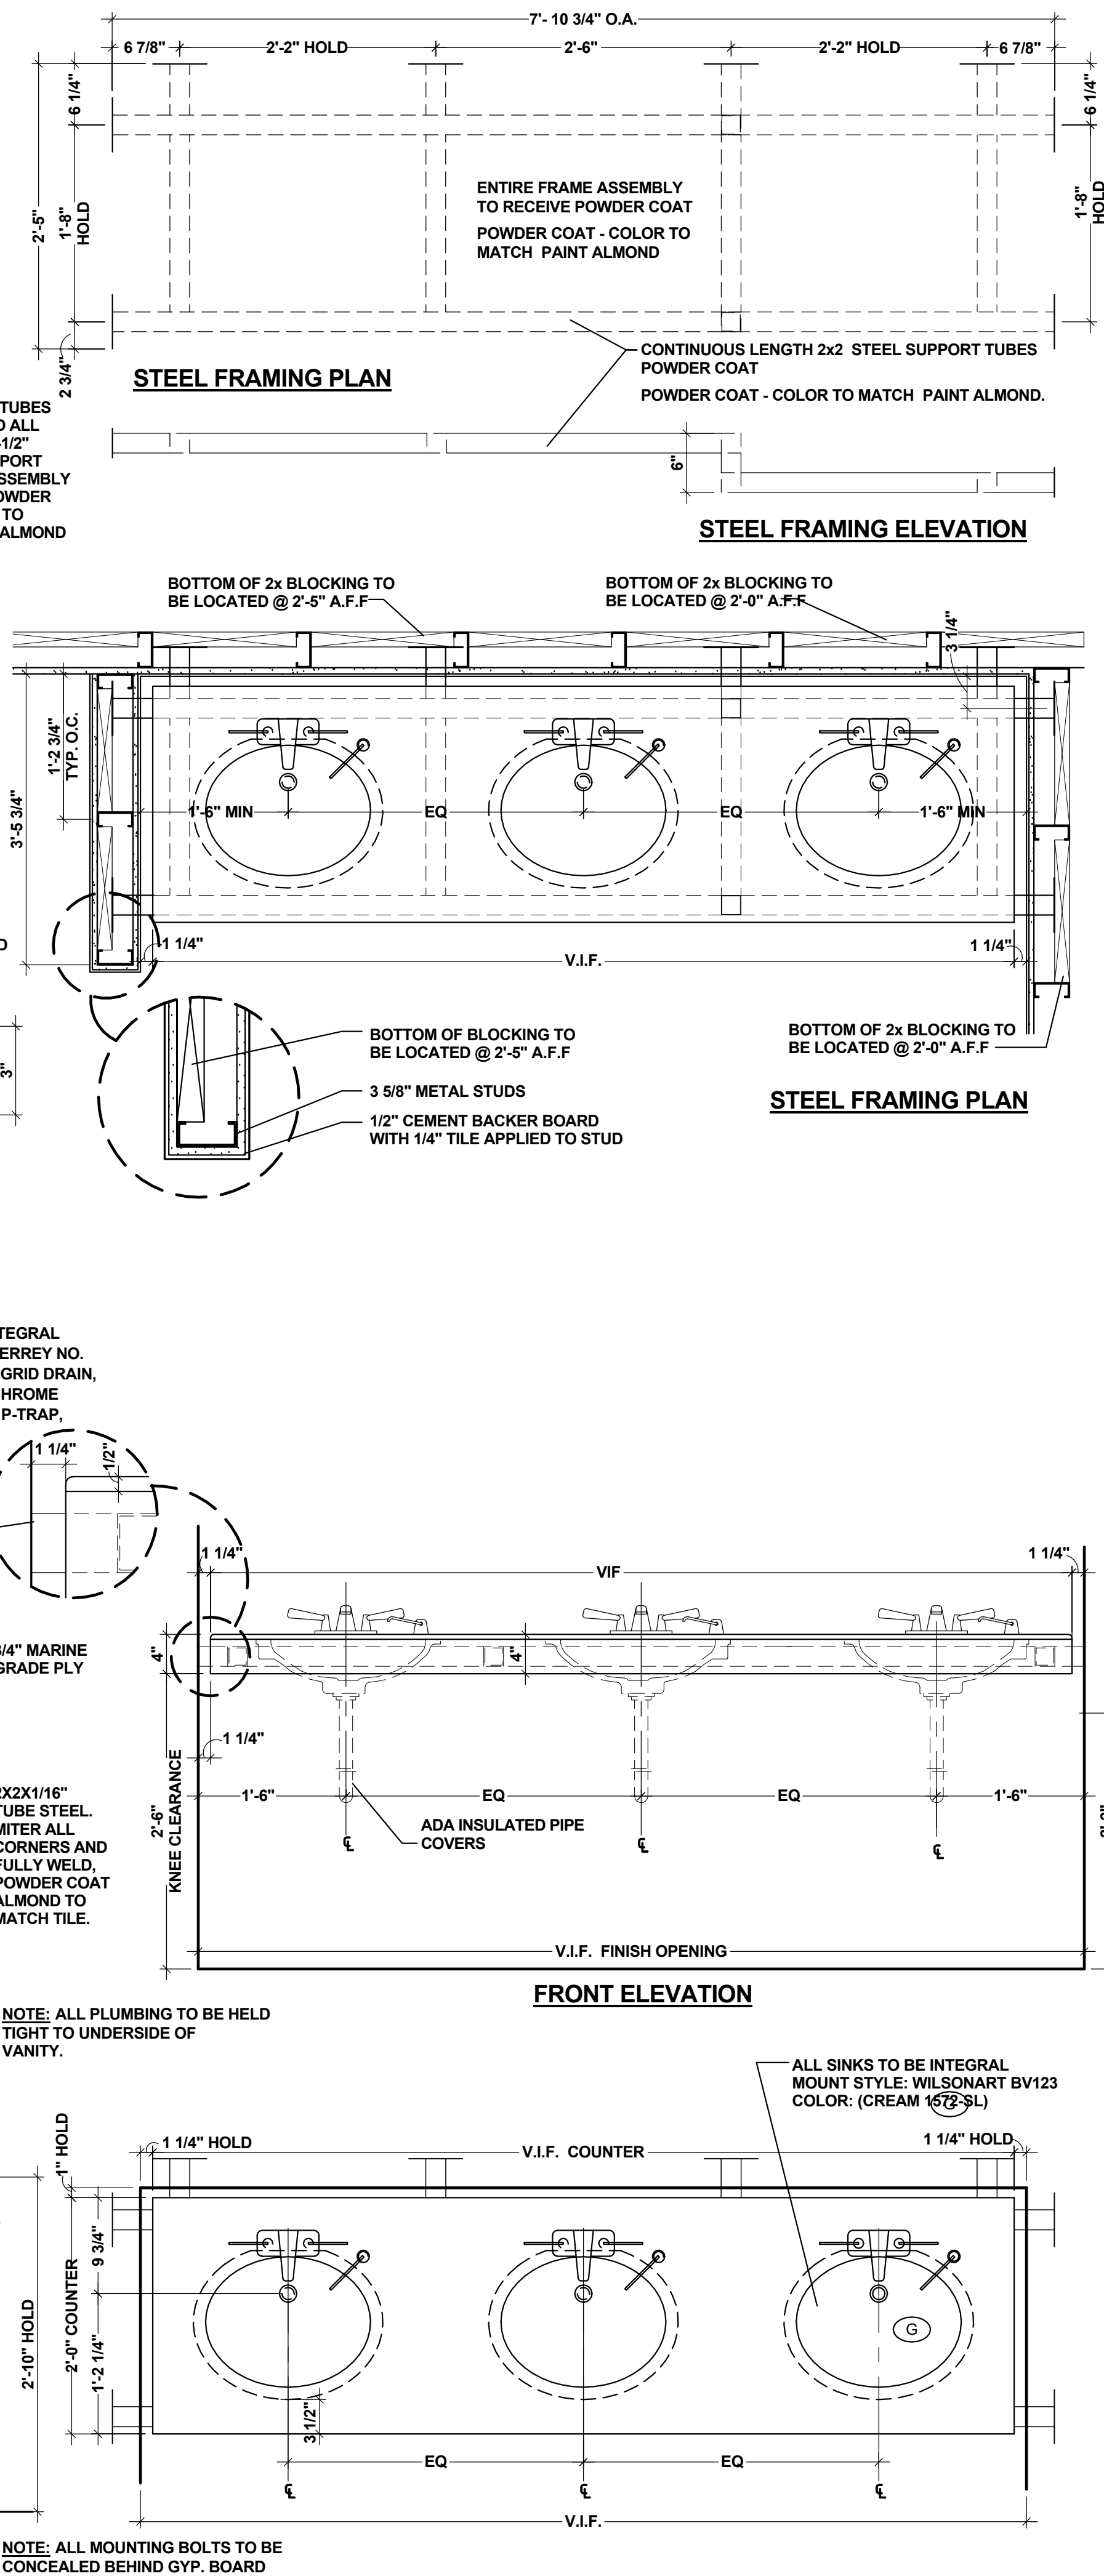


Toilet Room Accessibility Requirements

- Note:
- Toilet rooms shall conform to all accessibility requirements of the Americans with Disabilities Act (ANSI 117.1) which includes but is not limited to the following:
 - Contractor shall install one napkin disposal box in each stall of the women's restroom.
 - Dimensions are from/to O.F.O. finish U.I.O.
 - Knee clearance at lavatory: apron 29" min. height, 8" min. depth.
 - Lavatory hot water and drainpipes to be insulated wherever exposed with form fitting wraps.
 - Provide all blocking as required.
 - Silicone seal all fixtures to wall and/or floor as required.
 - All accessories shall be thru-bolt at toilet partition locations.
 - Install 5'-0" tall toilet partitions at 1'-0" A.F.F. See enlarged detail for centers.
 - Install box wall sconce light 7'-0" A.F.F. See sheet A3.0 for location.
 - Water closet seat height: 17" to 19" A.F.F.
- B. Grab bars at side of water closet: 42" long, T.O. bar mounted 33" to 36" A.F.F.
C. Toilet paper dispenser: centered, from front of toilet, 19" min. A.F.F.
E. Grab bar diameter: 1 1/4" to 1 1/2" O.D.
K. Grab bar behind water closet: 36" long, T.O. bar mounted 33" to 36" A.F.F.

INTERNATIONAL SYMBOL OF ACCESSIBILITY:

To be installed on exterior of the toilet room door. (Re: elevation detail below)
Identification signs are raised San Serif or Simple Serif and also have grade 2 braille pictorial symbols and include verbal description, room identification signs shall be installed on the wall adjacent to the latch side of the room door at a height of 60" A.F.F. provide clear floor space at sign.

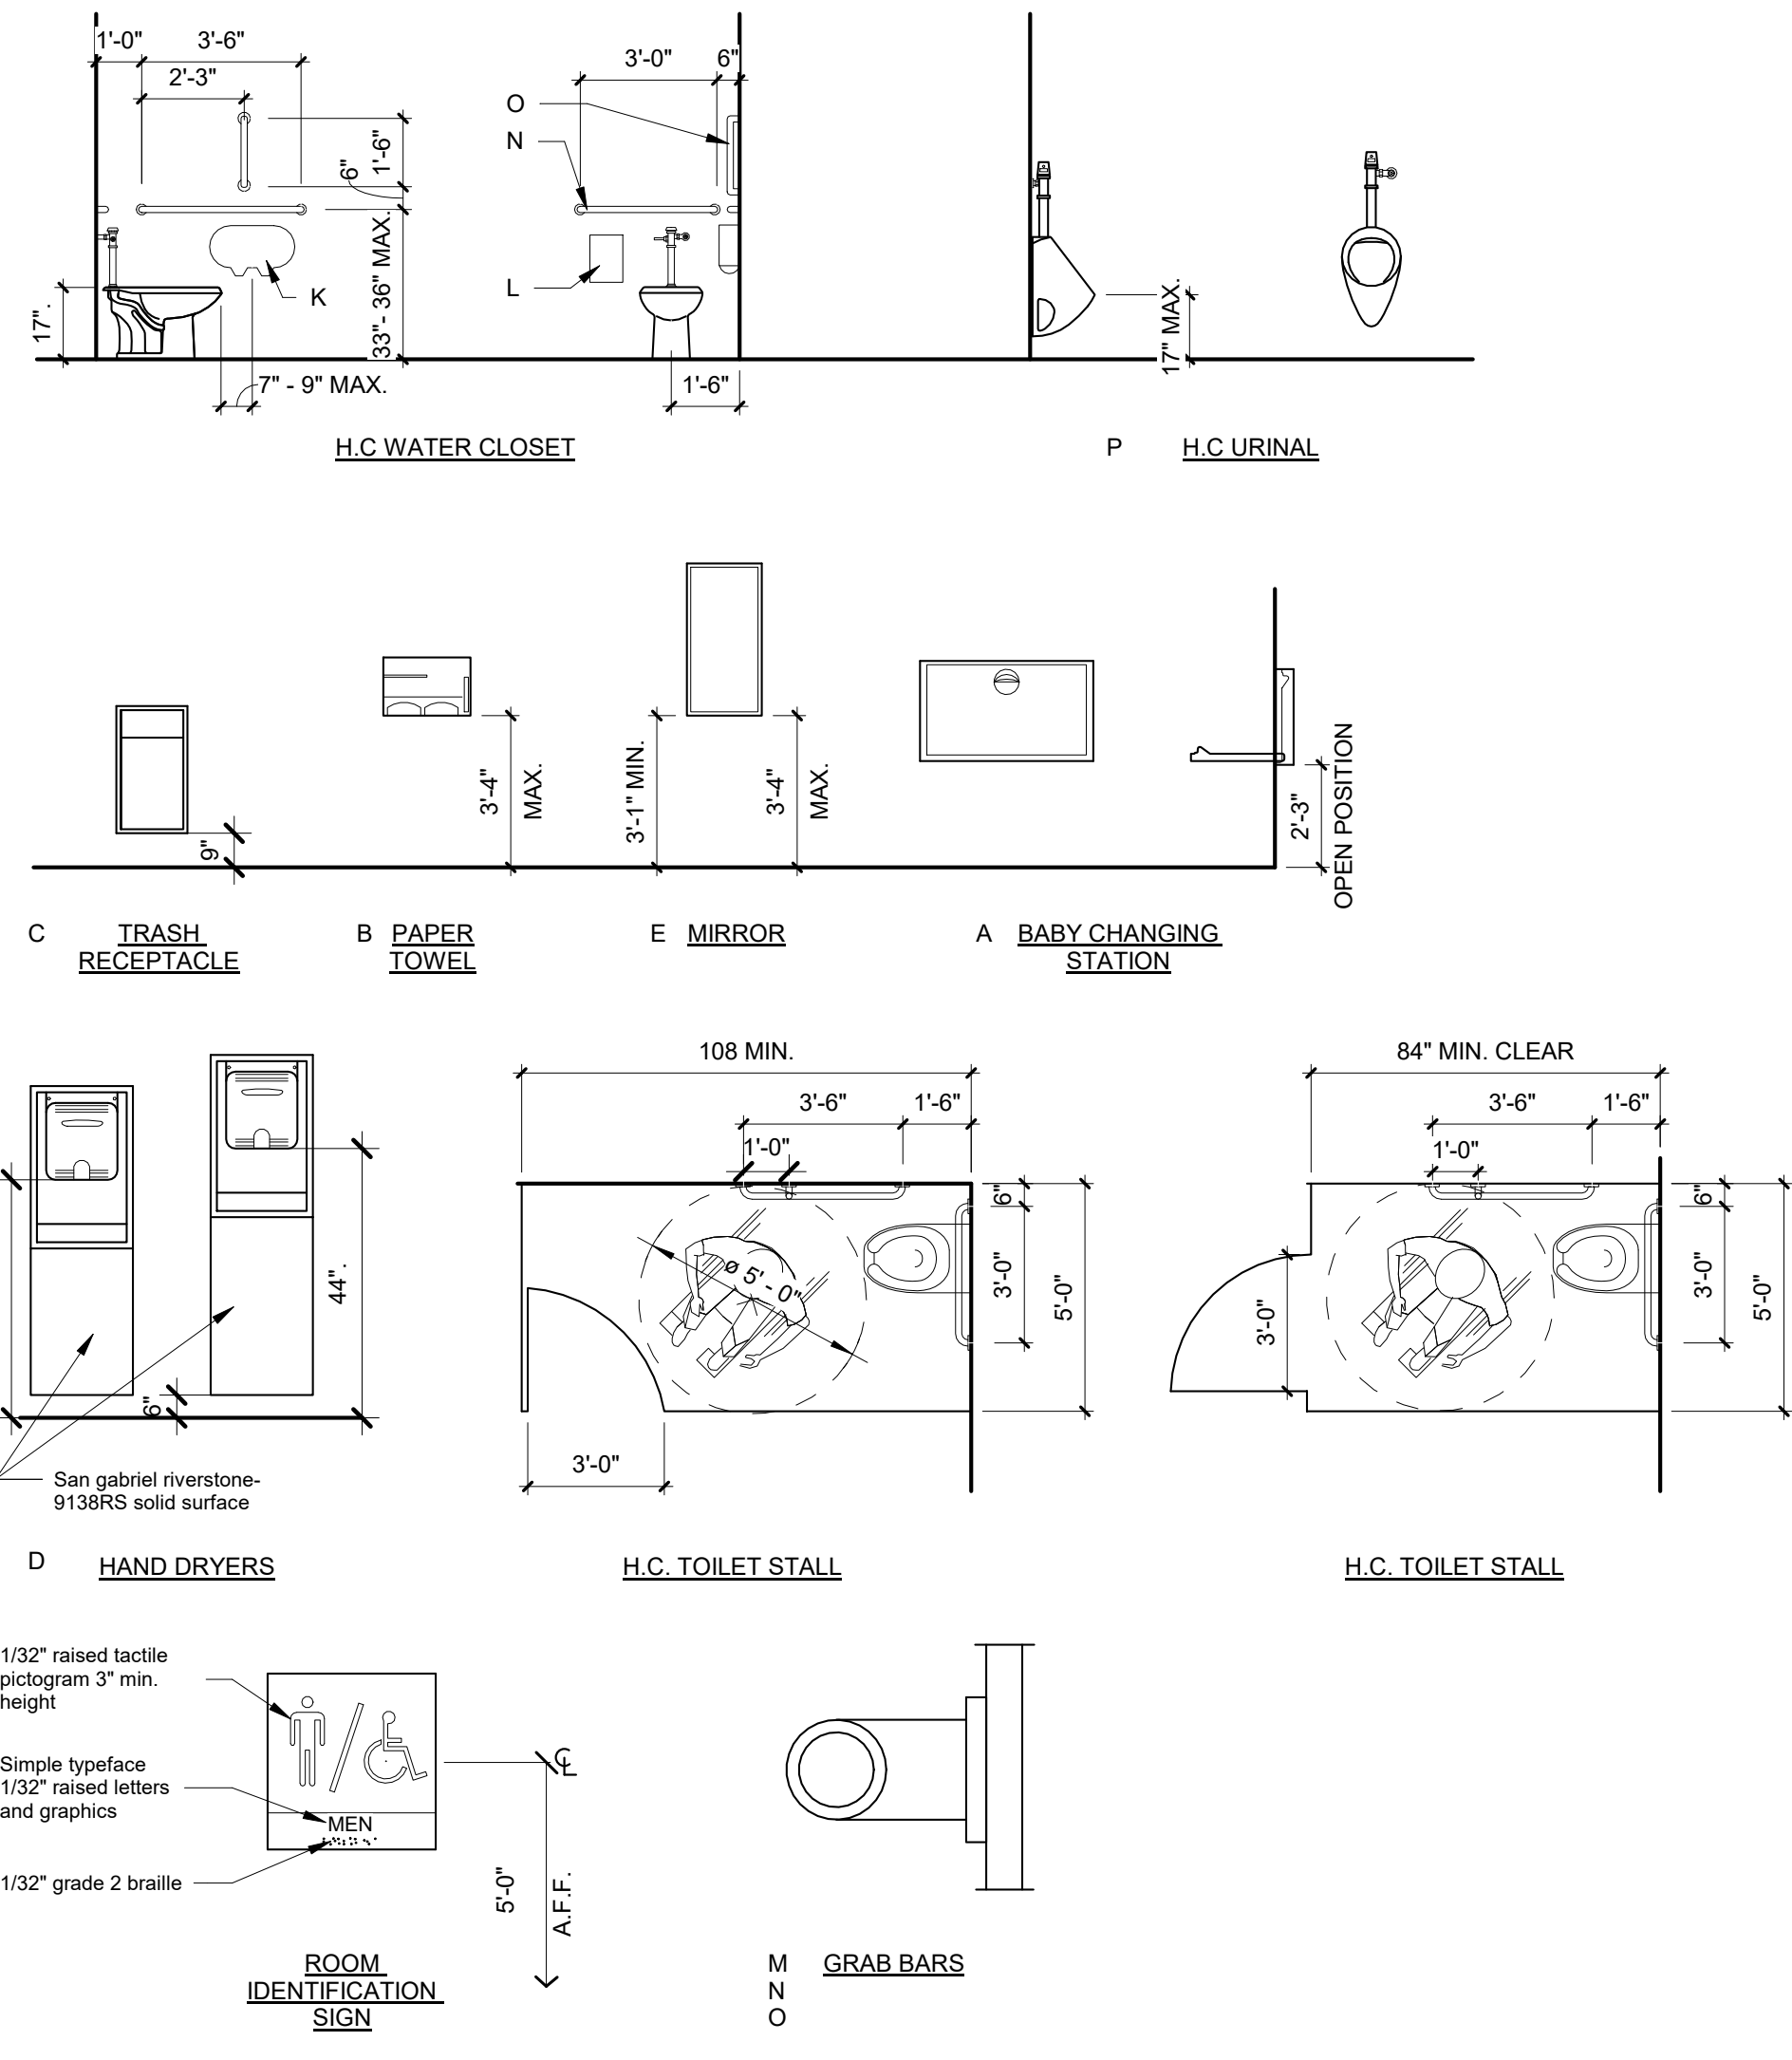

This plan was reviewed for adopted codes and **NOT** for compliance with **ADA** or **FHA** accessibility requirements. Contact 800-949-4232 (**ADA**) and 303-894-7822 x 325 (**FHA**) for federal accessibility requirements that apply to your project.

Field Inspection consultation is available upon request. Call 303-739-7420 to request a consultation

Code violations that are found during inspection are required to be corrected. Permit issuance does not grant approval of a code violation.



City of Aurora Building Division
Reviewed for Code Compliance
Approved as Noted: **Erick B.**
Date: **Jun 21, 2019**
2015 INTERNATIONAL CODES & 2017 NEC

RSN: 1369378
Permit #: 19-1625136

CONSTRUCTION • ARCHITECTURE

PKWY

PKWY Architects, LLC
1000 Civic Circle Lewisville, TX 75067
parkwayconstruction.com (972) 221-1979

Project Manager: Architect: Contact: W.D. Pounds (469)322-3732 (469)322-3714



710

14005 E Exposition Ave.
Aurora, CO 80012

Owner:
CEC ENTERTAINMENT, INC.
Irving, TX 77063
ph: 972.258.5521
Contact: Walter Boyd
wboyd@cecertainment.com

Architect:
PKWY Architects, LLC
1000 Civic Circle
Lewisville, TX 75287
Ph: 213.122.122
Contact: Greg Klimko

MEP Engineer:
Dialectic Engineering
310 W. 20 th street
200 kansas City, MO 64108
ph: 816.997.9627
Contact: Joe Hillebrenner, P.E.




Architect: William D. Pounds

A	Permit Set	5/13/19
No.	Description	Date

DRAWN BY: RM/VG
CHECKED BY: DD
PROJ. NO: 08-19413
Copyright Parkway C&A, LP 2019 ©


Interior Details

A7.3

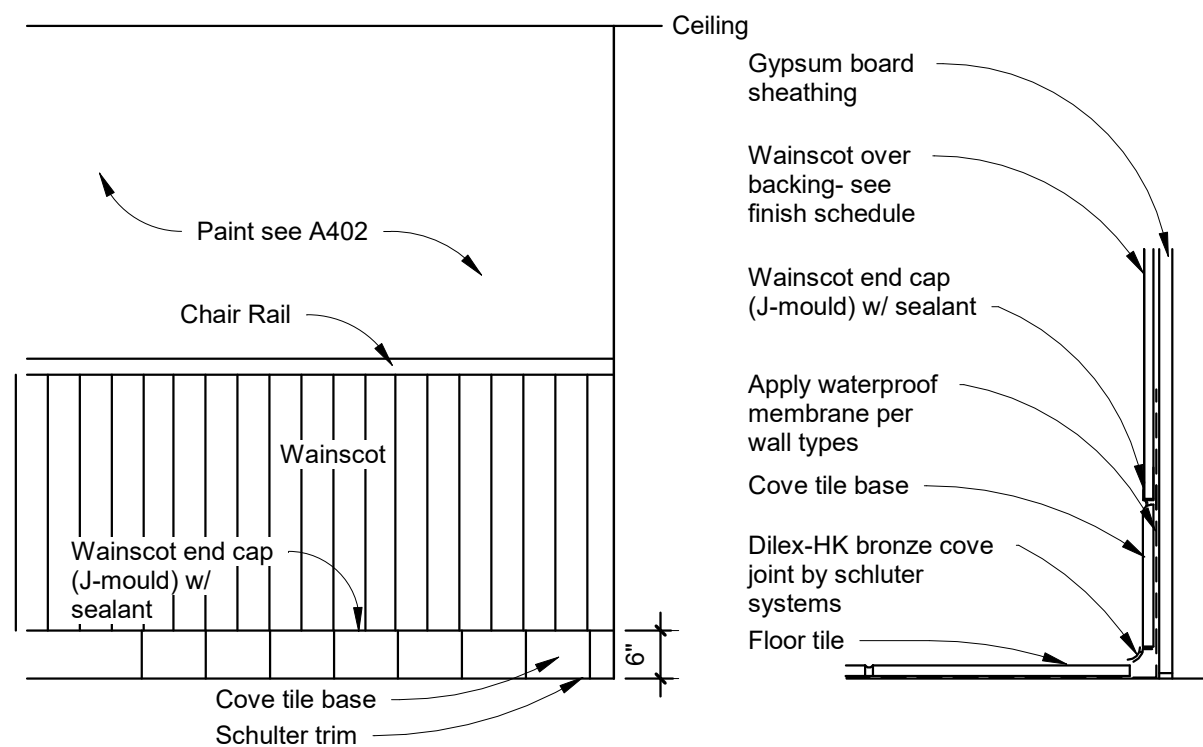


1 Wainscot Cove Detail

1/2" = 1'-0"

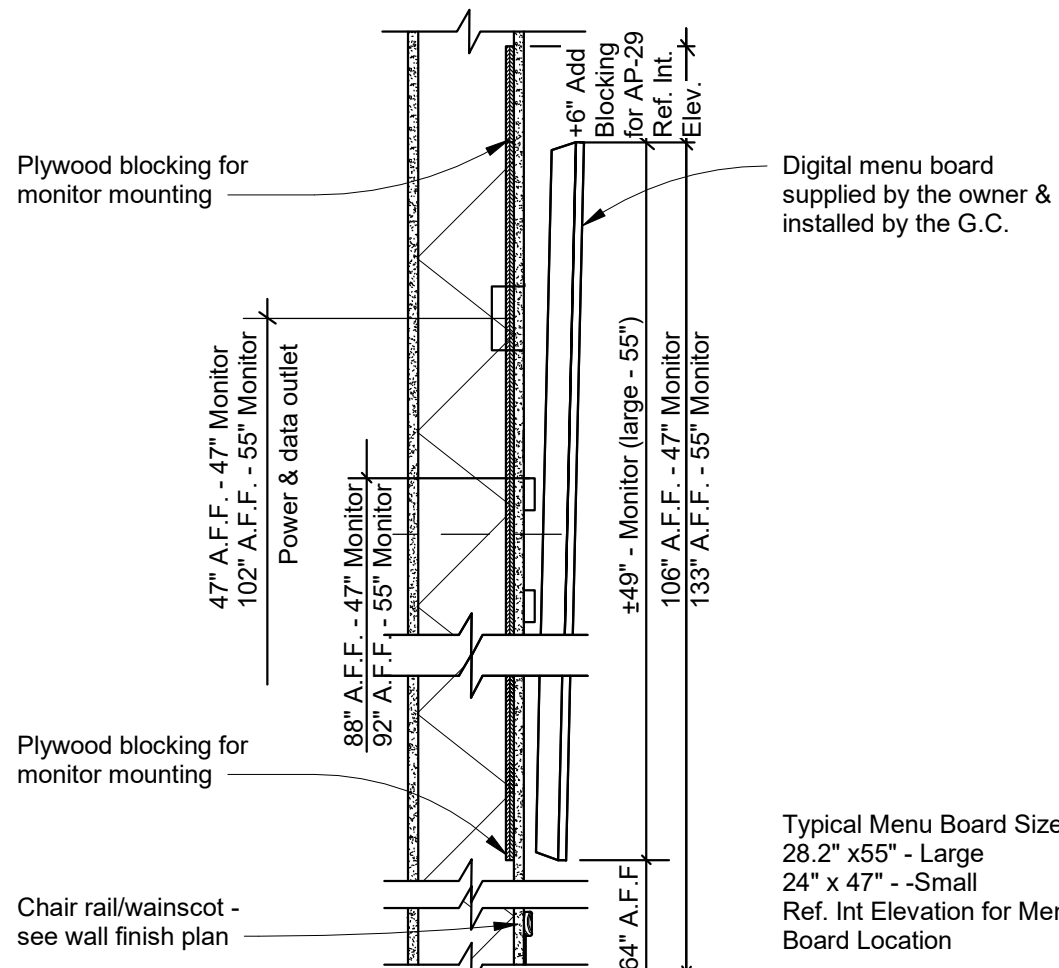


2 Menu Board Section (Surface MTD.)

1" = 1'-0"

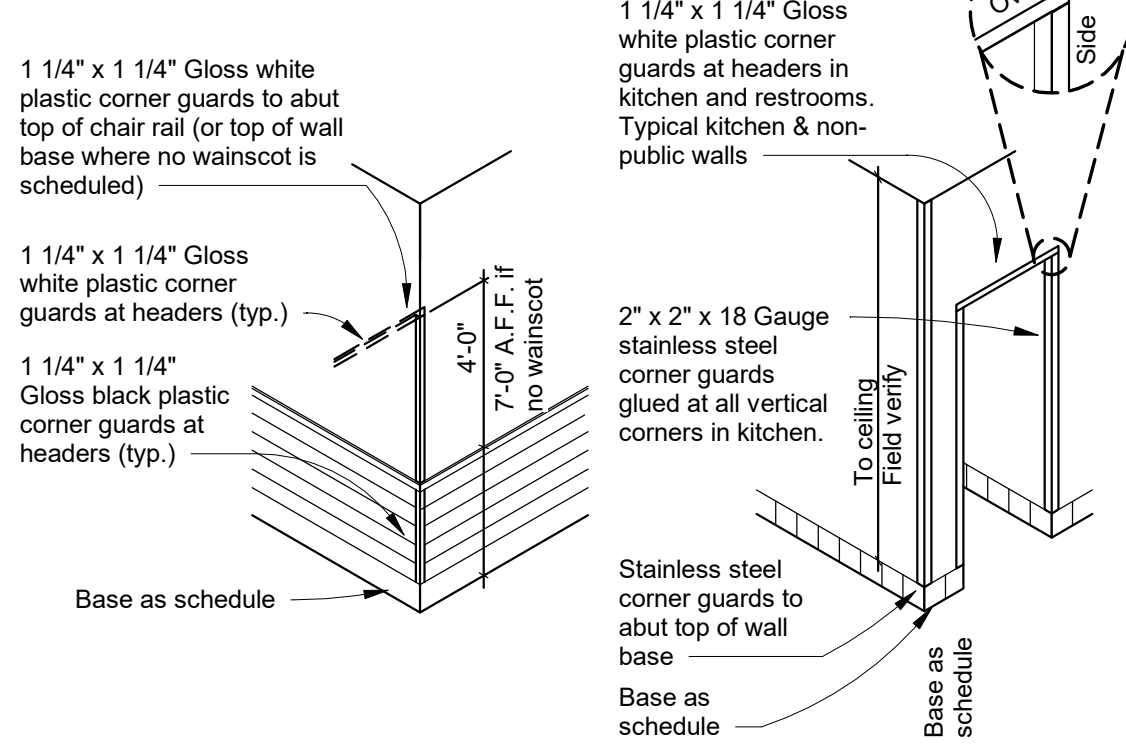

3 Corner Guard Detail

1" = 1'-0"

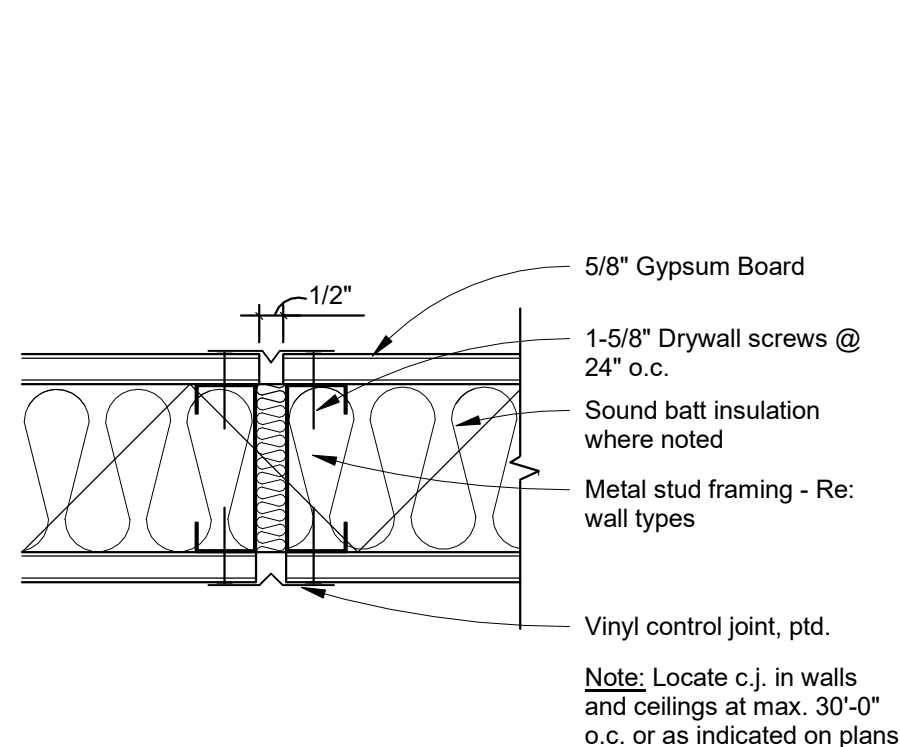


4 Typical Gyp. Bd. C.J.

1" = 1'-0"

Ceiling Bracing Notes (Where Required Per Seismic Zone)


1. Four no. 12 gauge wires must be secured to the main runner within 2 inches of the cross runner intersection and splayed 90 degrees from each other at an angle not exceeding 45 degrees from the plane of the ceiling. A strut fastened to the main runner shall be extended to and fastened to the structural members supporting the roof and floor above. The strut shall be adequate to resist the vertical component induced by the bracing wires. These horizontal restraint points shall be placed 12 feet on center in both directions with the first point within 6 feet from each wall. Attachment of the restraint wire to the structure above shall be adequate for the load imposed.

2. Lateral force bracing members shall be spaced a minimum of 6 inches from all horizontal piping or duct work that is not provided with bracing restraints for horizontal forces. Bracing wires shall be attached to the grid and to the structure in such a manner that they fan support a design load of not less than 200 pounds or the actual load, whichever is greater, with a safety factor of 2.

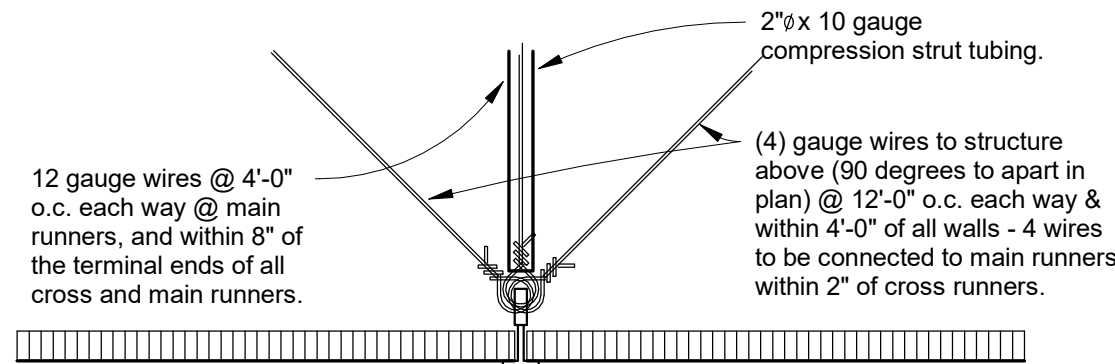


5 Ceiling Lateral Tie Detail

1" = 1'-0"

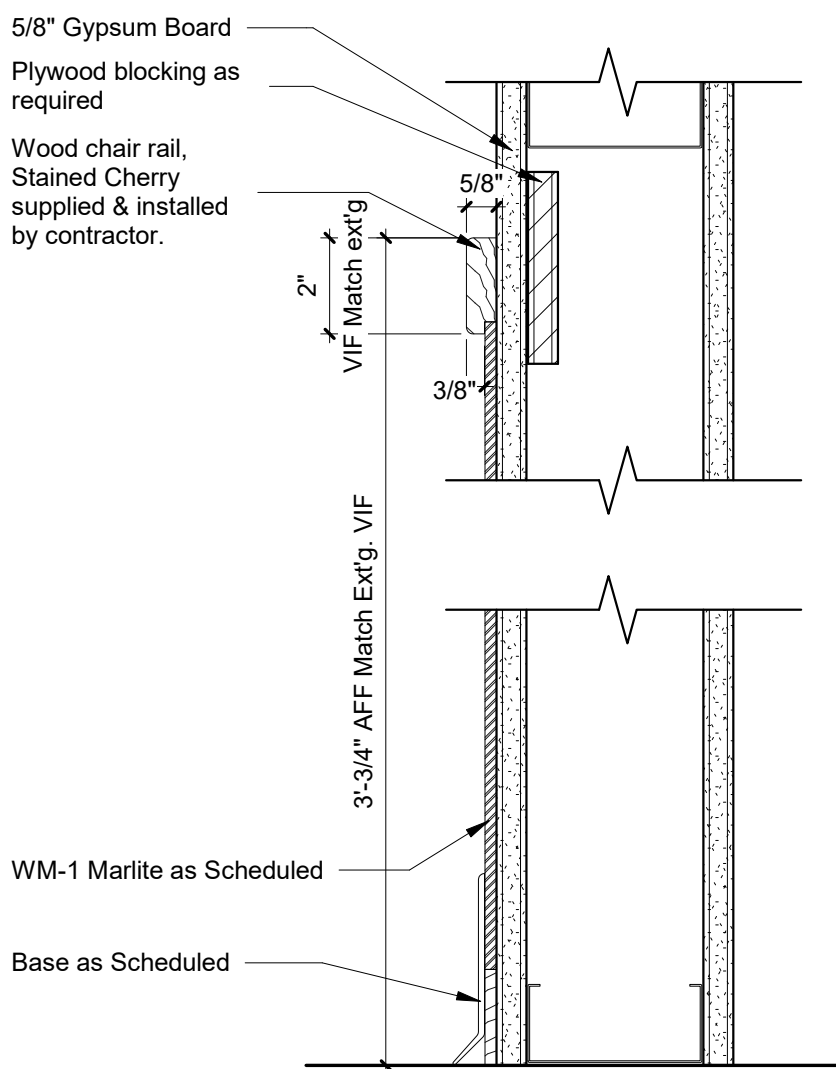


6 TYP Chair Rail Detail1

3" = 1'-0"

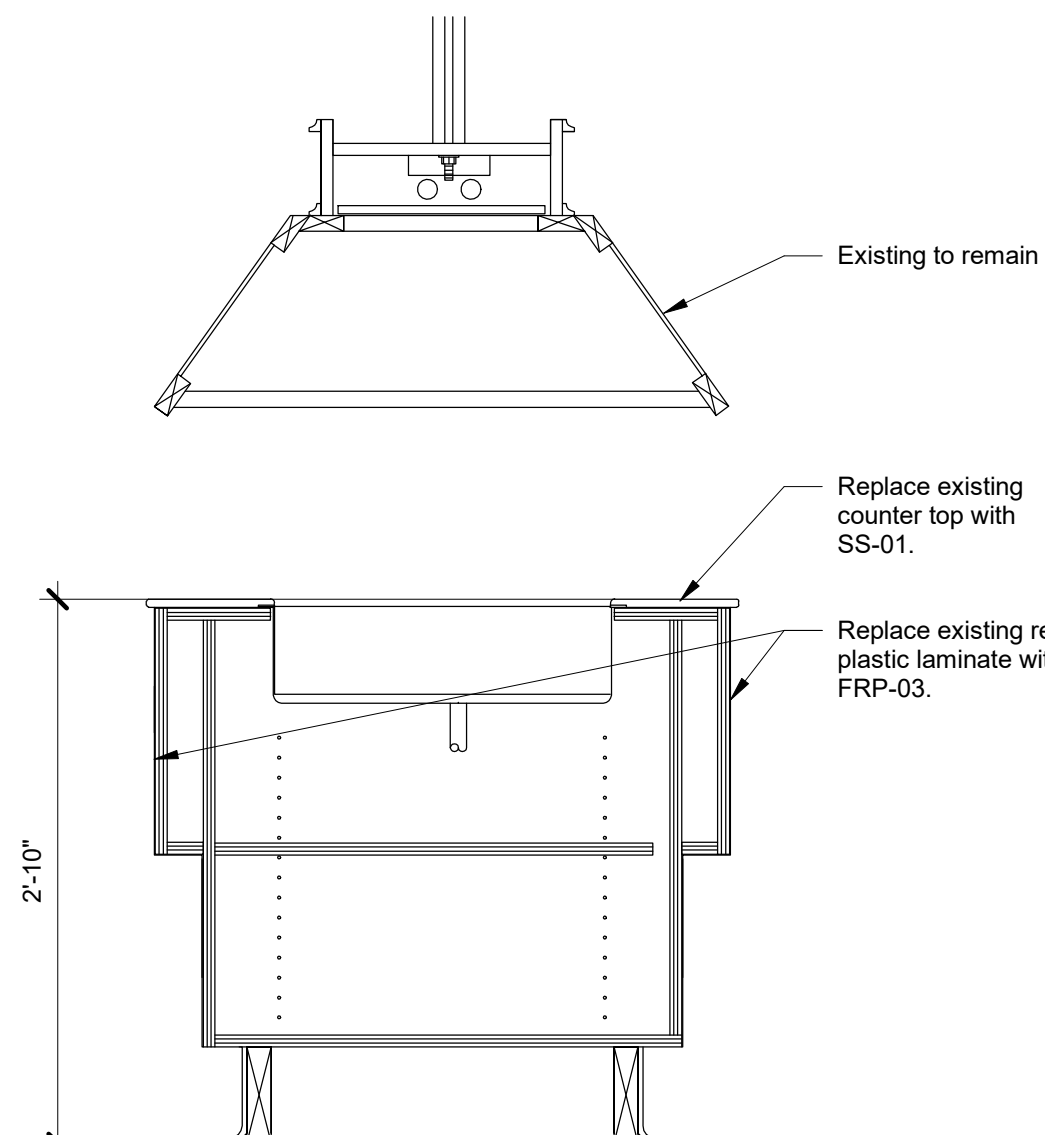


7 Existing Salad Bar Section

1" = 1'-0"

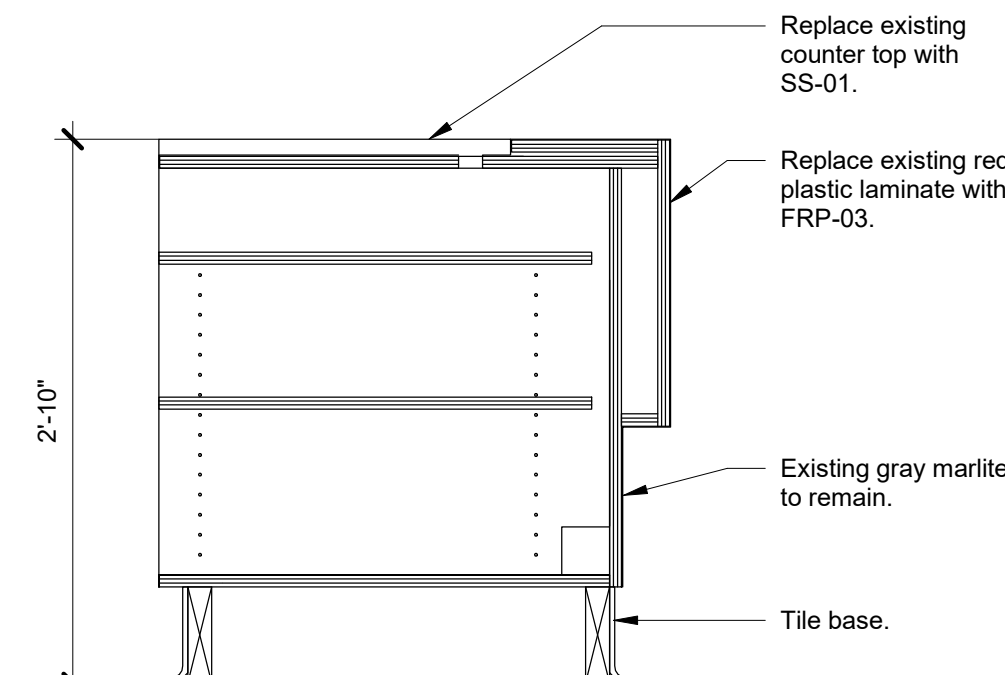


8 Existing Order counter Section Dtl

1" = 1'-0"

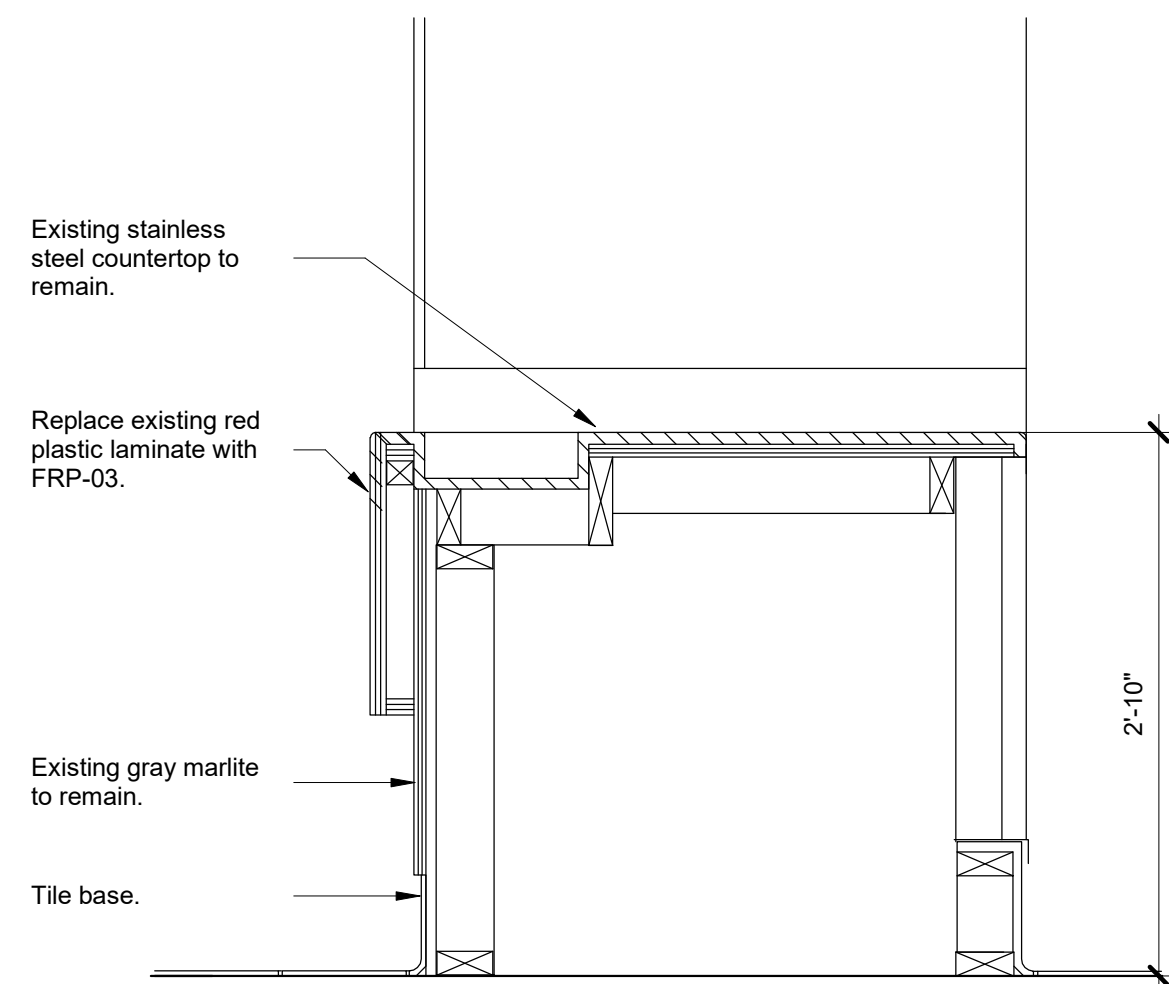

9 Existing Beverage Detail

1" = 1'-0"

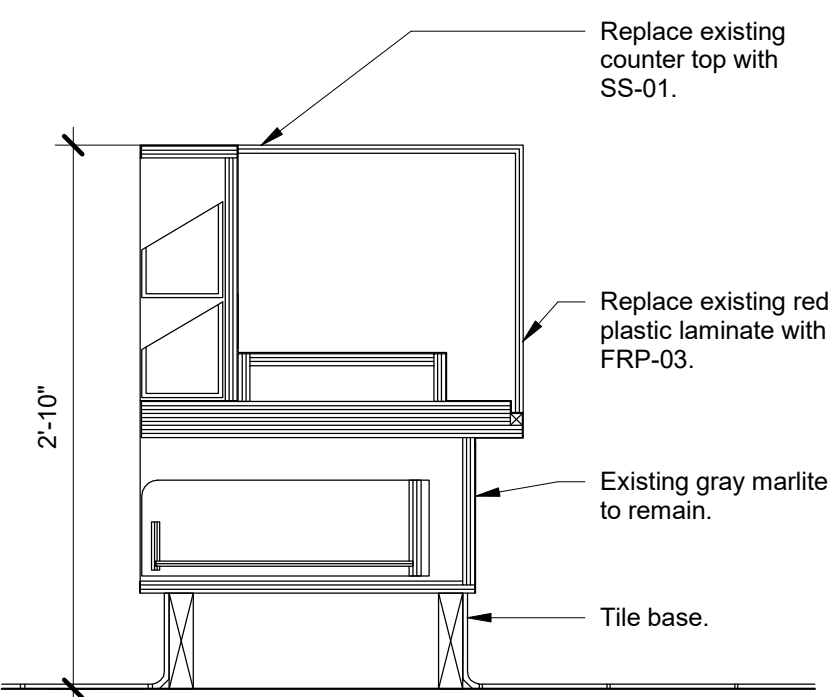

10 Existing Prize Counter Dtl

1" = 1'-0"

Field Inspection consultation is available upon request. Call 303-739-7420 to request a consultation

Code violations that are found during inspection are required to be corrected. Permit issuance does not grant approval of a code violation.



City of Aurora Building Division
Reviewed for Code Compliance
Approved as Noted: **Erick B.**
Date: **Jun 21, 2019**
2015 INTERNATIONAL CODES & 2017 NEC

RSN: 1369378
Permit #: 19-1625136



710

14005 E Exposition Ave.
Aurora, CO 80012

Owner:
CEC ENTERTAINMENT, INC.
Irving, TX 77063
ph: 972.258.5521
Contact: Walter Boyd
wboyd@cecentertainment.com

Architect:
PKWY Architects, LLC
1000 Civic Circle
Lewisville, TX 75087
Ph: 213.122.122
Contact: Greg Klimko

MEP Engineer:
Dialectic Engineering
310 W. 20 th street
200 Kansas City, MO 64108
ph: 816.997.9627
Contact: Joe Hillebrenner, P.E.



Architect: William D. Pounds

No.	Description	Date
-----	-------------	------

DRAWN BY: Author
CHECKED BY: Checker
PROJ. NO: 08-19413
Copyright Parkway C&A, LP 2019 ©

Interior Details

A7.4

ART PACK LEGEND				
Pack	Panel Size	Style	Specification	Location
AP-01		Primary logo sign		EXT.
AP-02		Stacked logo sign		EXT.
AP-03		Primary Wormer sign		EXT.
AP-04		Stacked workmark sign		EXT.
AP-05		Pizzeria & Games (black)		EXT.
AP-06		Pizzeria & Games (stainless)		EXT.
AP-07	8' x 6'	Welcome wall		INT.
AP-08		Veggies Freezer Message		INT.
AP-09	4' x 6'	Exit Message		INT.
AP-10	4' x 4' ; 8'x4'	Mozzarella Message		INT.
AP-11	4' x 4' ; 8'x4'	Veggie message		INT.
AP-12	4' x 4' ; 8'x4'	Dough message		INT.
AP-13	14'-6" x 8"	Where A Kid Can Be A Kid		INT.
AP-14	20' x 6'	Game wall "Alley Classic"		INT.
AP-15	12'x6'; 12'x7'; 16'x8'	Birthday Zone Art		INT.
AP-16	8'x6' ; 8'x7' ; 8'x8'	Character wall - Pasqually		INT.
AP-17	8'x6' ; 8'x7' ; 8'x8'	Character wall - Jasper Jowels		INT.
AP-18	8'x6' ; 8'x7' ; 8'x8'	Character wall - Mr. Munch		INT.
AP-19	8'x6' ; 8'x7' ; 8'x8'	Character wall - Helen Henney		INT.
AP-20	8'x6' ; 8'x7' ; 8'x8'	Character wall - Chuck E Cheese		INT.
AP-21	16'x6' ; 16'x7' ; 20'x8'	Party		INT.
AP-21	20'x6' ; 24'x7' ; 28'x8'	Fresh		INT.
AP-21	20'x6' ; 24'x7' ; 28'x8'	High Five		INT.
AP-22	6'x2'	Drink message		INT.
AP-22-V	5'-6"x1'-7 1/2"	Drink message - vinyl decal		INT.
AP-23	5'-8"x4'-4 1/2"	Pizza Dough Glass		INT.
AP-24	21'-11 1/2"x10 1/4"	Pizzeria Signage		INT.
AP-25-FM	6'-8"x2'-7 3/4"	"You Won" Prize shop sign cabinet - flush mount	Illuminated Cabinet	INT.
AP-25-HK	6'-8"x2'	"You Won" Prize shop sign cabinet - ceiling mount		INT.
AP-25-ST	Dimension Varies x18"	PVC FCO Tickets		INT.
AP-25-LT	Dimension Varies x3'	PVC FCO Tickets		INT.
AP-27		Painted stripes	GC to paint stripes	INT.
AP-28	38"x42"	Pizza sizing guide		INT.
AP-29-HK	9"x10"	Menu board ledge	PVC shelf	INT.
AP-31	4'x4' ; 8'x4'	Tomatoes Message		INT.
AP-32	55'-7 1/4"x8"	Food Proof Point		INT.
AP-33	20'x6' ; 20'x7' ; 24'x8'	Game Wall		INT.
AP-INSTA	6'x6' ; 8'x8'	CEC Instagram wall	Lettering adjustment	INT.
AP-AYCP	4'x4' ; 8'x4'	CEC All you can play signage		INT.
AP-LOGO	1'-6"x1'-6"	Int logo - size determined by CEC		INT.
Notes: Refer to Comet sign package for final decal legend and sizes. Panel height determined by ceiling height: 11' ceiling = 6' panel height 11' ceiling = 7' panel height 12' ceiling = 8' panel height Reference Interior elevations for custom panel dimensions and locations. CEC to approve final location.			Sign Company: Comet Signs 5003 Stout Dr San Antonio, TX 78219 Contact: Michael Gallegos 210-341-7244 micheal.gallegos@cometsign.com	

Key Name	Manufacturer	Color	Color #	Finish
PT-01	Benjamin Moore	Alabaster	OC129	Eggshell
PT-02	Benjamin Moore	Balboa Mist	1549	Satin
PT-02A	Benjamin Moore	Cumulus Cloud	1550	Suede
PT-02B	Benjamin Moore	Lapollama Gray	1551	Suede
PT-02C	Benjamin Moore	River Reflections	1552	Suede
PT-03	Benjamin Moore	Ashwood Moss	1484	Satin
PT-04	Benjamin Moore	Million Dollar Red	2003-10	Eggshell
PT-05	Benjamin Moore	Sabre Grey	1482	Satin
PT-06	Benjamin Moore	Etruscan	AF-355	Satin
PT-07	Benjamin Moore	Iron Mountain	2134-30	Satin
PT-08	Sherwin Williams	Extra White	SW7006	Satin
PT-09	Benjamin Moore	Cabot Trail	998	Satin
PT-10	Sherwin Williams	Latte	SW6108	Satin
PT-11	Benjamin Moore	Sycamore Tree	539	Satin
PT-12	Benjamin Moore	Shades of Spring	537	Satin
PT-13	Benjamin Moore	Huntington Green	406	Satin
PT-14	Sherwin Williams	Outrageous Green	SW6922	Satin
PT-15	Benjamin Moore	Palm Coast Tan	733	Satin
PT-16	Benjamin Moore	Scandinavian Blue	2068-30	Satin
PT-17	Sherwin Williams	Real Red	SW6868	Satin
PT-18	Benjamin Moore	Golden Nugget	2019-20	Satin
PT-19	Benjamin Moore	Deep Ocean	2058-30	Satin
PT-20	Benjamin Moore	Danville Tan	HC-91	Satin
PT-21	Sherwin Williams	Sand	SW2059	Satin
PT-E	Benjamin Moore	Match Existing		
ST-03	Sherwin Williams	Match Existing		

SYMBOL	ITEM	SPECIFICATION & COLOR	DESCRIPTION/ LOCATION OF USE	MANUFACTURER
FLOOR FINISH				
FF-01	PORCELAIN FLOOR TILE	PRODUCT: INTERCERAMIC FORESTLAND CYPRESS SIZE: 6"x24" (OFFSET INSTALL FOR WOOD LOOK) GROUT: MAPEI #7 - "CHOCOLATE" GROUT LINE: USE A 1/16" PATTERN: RUNNING BOND 1/3 OVER LAP COVE: DILEX-HK BRONZE BY SCHULTER SYSTEMS	PUBLIC AREA @ ORDER, MARCH, BEV. BAR FAMILY/GAMES DINNING AREA	COMPANY: INTERCERAMIC CONTACT: LORI HANDS PHONE: 972-243-4405 EXT#4466
		PRODUCT ALTERNATE: GRAINSWOOD SIZE: 6"x24" GW07 WALNUT GROUT: MAPEI #7 - "CHOCOLATE" GROUT LINE: USE A 1/16" PATTERN: RUNNING BOND 1/3 OVER LAP COVE: DILEX-HK BRONZE BY SCHULTER SYS.	PUBLIC AREA @ ORDER, MARCH, BEV. BAR FAMILY/GAMES DINNING AREA	COMPANY: DAL-TILE CONTACT: FREDERICK DAVIS PHONE: 972-423-5465 469-964-3246 FRED.DAVIS@DALTILE.COM
		PRODUCT ALTERNATE: SADDLEBROOK SIZE: 6"x36" SD15 WALNUT GROUT: MAPEI #7 - "CHOCOLATE" GROUT LINE: USE A 1/16" PATTERN: RUNNING BOND 1/3 OVER LAP COVE: DILEX-HK BRONZE BY SCHULTER SYS.	PUBLIC AREA @ ORDER, MARCH, BEV. BAR FAMILY/GAMES DINNING AREA	COMPANY: DAL-TILE CONTACT: FREDERICK DAVIS PHONE: 972-423-5465 469-964-3246 FRED.DAVIS@DALTILE.COM
FF-02	CARPET TILE	PRODUCT: SYNCOPATION STYLE: 1240202500 COLOR LINE: 6491 HEMLOCK 6487 BLUE GRASS SIZE: 50CM X 50CM PRODUCT: ICE BREAKER STYLE: 1473002500 COLOR LINE: 105773 JET MIST SIZE: 50CM X 50CM	PUBLIC AREA 10% - HEMLOCK 20% - BLUE GRASS 70% - ICE BREAKER	COMPANY: INTERFACE CONTACT: JERRY ARNOLD PHONE: 415-515-9316 JERRY.ARNOLD@INTERFACE.COM
FF-03	WALK-OFF CARPET TILE	PRODUCT: HIGH TRAFFIC ENTRANCE CARPET TILE STYLE: SR 999, 104945 ONIX CARPET TILE	ENTRY VESTIBULE	COMPANY: INTERCERAMIC CONTACT: LORI HANDS PHONE: 972-243-4405 EXT#4466
FF-04	PORCELAIN FLOOR TILE	PRODUCT: PINOT/ GOLD CEMUR SIZE: 20"x20" (INSTALL DIAGONAL) GROUT: MAPEI #42 - MOCHA USE GROUT LINE: 1/16"	RESTROOM FLOOR TILE	COMPANY: INTERCERAMIC CONTACT: LORI HANDS PHONE: 972-243-4405 EXT#4466
	PORCELAIN FLOOR TILE	PRODUCT ALTERNATE: SLATE ATTACHE MULTI SIZE: 24"x24" GROUT: MAPEI #15 BONE	RESTROOM FLOOR TILE	COMPANY: DAL-TILE CONTACT: FREDERICK DAVIS PHONE: 972-423-5465 469-964-3246 FRED.DAVIS@DALTILE.COM

SYMBOL	ITEM	SPECIFICATION & COLOR	DESCRIPTION / LOCATION OF USE	MANUFACTURER
Furniture Schedule				
FN-01	DINNING CHAIR	PRODUCT: SPRINT SIDE CHAIR SPRI-SC COLOR: MATTE BLACK PC002/ PL-01 SIZE: 18" W 20" D 18" SH VERIFY SPEC. WITH ARCHITECT	FAMILY DINING BANQUET CHAIR *	COMPANY: DESIGNFORM CONTACT: KAYLA HODGE PHONE: 949-351-4288 EMAIL: kayla@globalsourceindustries.com
FN-02	PARTY BENCH		BIRTHDAY ROOM	
FN-03	DINNING TABLE	PRODUCT: DINNING TABLE EDGE: EASED EDGE FINISH: PL-02 SIZE: 42" X 28" BASE: WRINKLE BLACK, CROSS SHAPED	FAMILY/ GAMES BANQUET TABLE	COMPANY: JAK.W CONTACT: LAURA KAHAR PHONE: 970-376-3151 EMAIL: laura@jak-w.com COMPANY: MIDWEST CABINET CONTACT: SUSAN EICHENBERGER PHONE: 785-242-8181 EXT. 23 EMAIL: seichenberger@midwestcabinet.com
FN-04	DINNING TABLE	PRODUCT: DINNING TABLE EDGE: EASED EDGE FINISH: PL-02 SIZE: 56" X 28" BASE: WRINKLE BLACK, CROSS SHAPED	FAMILY/ GAMES BOOTH TABLE	
FN-05	DINNING TABLE	PRODUCT: DINNING TABLE EDGE: EASED EDGE FINISH: PL-02 SIZE: 46" X 46" BASE: WRINKLE BLACK, CROSS SHAPED	FAMILY/ GAMES CORNER TABLE	
FN-06	DINNING TABLE	PRODUCT: DINNING TABLE EDGE: EASED EDGE FINISH: PL-02 SIZE: 42" X 28" BASE: WRINKLE BLACK, CROSS SHAPED	SHOWROOM LOOSE TABLE	
FN-07	DINNING TABLE	PRODUCT: DINNING TABLE EDGE: EASED EDGE FINISH: PL-02 SIZE: 60" X 28" BASE: WRINKLE BLACK, CROSS SHAPED	SHOWROOM LOOSE TABLE	
FN-08	DINNING TABLE	PRODUCT: DINNING TABLE EDGE: EASED EDGE FINISH: PL-02 SIZE: 90" X 24" BASE: WRINKLE BLACK, CROSS SHAPED	SHOWROOM HIGHTOP TABLE	
FN-09	DINNING TABLE	PRODUCT: DINNING TABLE EDGE: EASED EDGE FINISH: PL-02 SIZE: 42" X 30" BASE: WRINKLE BLACK, CROSS SHAPED	SHOWROOM TABLE	
UPH-01	UPHOLSTERY	PRODUCT: THE SYMPHONY COLLECTION STUDIO STYLE: PERSUASION COLOR: CHINA RED TPE 010 SIZE: 54"	*	-
UPH-01	UPHOLSTERY	PRODUCT: THE SYMPHONY COLLECTION STUDIO STYLE: PERSUASION COLOR: MATADOR TPE 017 SIZE: 54"	*	-
UPH-01	UPHOLSTERY	PRODUCT: THE SYMPHONY COLLECTION STUDIO STYLE: PERSUASION COLOR: BEET TPE 004 SIZE: 54"	*	-

Code violations that are found during inspection are required to be corrected. Permit issuance does not grant approval of a code violation.

Field Inspection consultation is available upon request. Call 303-739-7420 to request a consultation

SYMBOL	ITEM	SPECIFICATION & COLOR	DESCRIPTION / LOCATION OF USE	MANUFACTURER
WALL COVER				
WM-01	MARLITE	PRODUCT: SOLID COLOR COLOR: MORNING HAZE 5446-S2V SIZE: 1/4" BEVEL TONGUE GROVE	INTERIOR WAINSCOT	COMPANY: MARLITE A VERZTEC COMPANY
WT-03	GLAZED CERAMIC BASE	PRODUCT: SISTEMC COLOR: MIRO FUMO-C SIZE: 4"X12" GROUT: LATICRETE: 60 DUSTY GRAY	MENU BOARD WALL	COMPANY: MARAZZI CONTACT: TARYN FISCHER PHONE: 415-554-1937 TARYN.FISCHER@DALTILE.COM
		PRODUCT ALTERNATE: X114 DESERT GREY SIZE: 4"X12" GROUT: LATICRETE: 60 DUSTY GRAY	MENU BOARD WALL	COMPANY: DAL-TILE CONTACT: FREDERICK DAVIS PHONE: 972-423-5465 469-964-3246 FRED.DAVIS@DALTILE.COM
WT-05	GLAZED CERAMIC BASE	PRODUCT: BRITE ALMOND SIZE: 3"X6" GROUT: MAPEL #15 BONE	RESTROOM WALL	COMPANY: INTERCERAMIC CONTACT: LORI HANDS PHONE: 972-243-4405 EXT4466
		PRODUCT ALTERNATE: 0190 ARCTIC WHITE SIZE: 4"X8" GROUT: MAPEL #15 BONE	RESTROOM WALL	COMPANY: DAL-TILE CONTACT: FREDERICK DAVIS PHONE: 972-423-5465 469-964-3246 FRED.DAVIS@DALTILE.COM
WT-06	GLAZED PORCELAIN FLOOR TILE	PRODUCT: PINOT/ GOLD MEUNIER SIZE: 3"X6" GROUT: MAPEL #15 BONE	RESTROOM WALL ACCENT BAND	COMPANY: INTERCERAMIC CONTACT: LORI HANDS PHONE: 972-243-4405 EXT4466
		PRODUCT ALTERNATE: SLATE SA08 MULTI BROWN SIZE: 12"X24" GROUT: MAPEL #15 BONE	RESTROOM WALL ACCENT BAND	COMPANY: DAL-TILE CONTACT: FREDERICK DAVIS PHONE: 972-423-5465 469-964-3246 FRED.DAVIS@DALTILE.COM
FRP-02	FRP	PRODUCT: C 100-G63 STYLE: SUBWAY FRP COLOR: WHITE SIZE: 4' X 10' CAULK BUTT JOINTS W/ PENNY SPACING	KITCHEN WALL OPEN TO PUBLIC VIEW	COMPANY: MARLITE
FRP-03	MOSAIC FRP	PART NUMBER: #204137 VUE-SKY CHUCK E. CHEESE BEVBAR 48X120 ADHESIVE: FRP MARLITE ADHESIVE. USE CAULK TO MATCH FRP LIGHT GREY SEAM JOINT: 6 PENNY SPACING NAIL BETWEEN PANELS. INSTALL PER MANF. INSTALLATION	KITCHEN WALL OPEN TO PUBLIC VIEW	COMPANY: MARLITE

SYMBOL	ITEM	SPECIFICATION & COLOR	DESCRIPTION/ LOCATION OF USE	MANUFACTURER
WALL BASE				
WB-01	VINYL WALL BASE	PRODUCT: 60-JET BLACK COLOR: INTEGRATED COVE: 6" TOELESS	INTERIOR WALL BASE WITH CARPET	COMPANY: ARMSTRONG
WB-04	GLAZED CERAMIC BASE	PRODUCT: BRITE ALMOND SIZE: 6"x6" GROUT: MAPEL #15 BONE	RESTROOM COVE BASE	COMPANY: INTERCERAMIC CONTACT: LORI HANDS PHONE: 972-243-4405 EXT4466
		PRODUCT ALTERNATE: 0190 ARCTIC WHITE SIZE: 4"x8" GROUT: MAPEL #15 BONE	RESTROOM COVE BASE	COMPANY: DAL-TILE CONTACT: FREDERICK DAVIS PHONE: 972-423-5465 469-964-3246 FRED.DAVIS@DALTILE.COM
WB-05	GLAZED CERAMIC BASE	PRODUCT: INTERCERAMIC FORESTLAND CYPRESS (OFFSET INSTALL FOR WOOD LOOK) GROUT: MAPEL #7 - "CHOCOLATE" GROUT LINE: USE A 1/16" COVE: DILEX-HK BRONZE BY SCHULTER SYSTEMS	TILE BASE AROUND PUBLIC TILE AREA	COMPANY: INTERCERAMIC CONTACT: LORI HANDS PHONE: 972-243-4405 EXT4466
		PRODUCT ALTERNATE: SADDLEBROOK SIZE: 6"x36" SD15 WALNUT GROUT: MAPEL #7 - "CHOCOLATE" GROUT LINE: USE A 1/16" PATTERN: RUNNING BOND 1/3 OVER LAP COVE: DILEX-HK BRONZE BY SCHULTER SYS.	TILE BASE AROUND PUBLIC TILE AREA	COMPANY: DAL-TILE CONTACT: FREDERICK DAVIS PHONE: 972-423-5465 469-964-3246 FRED.DAVIS@DALTILE.COM
		PRODUCT ALTERNATE: GRAINSWOOD SIZE: 6"x24" GW07 WALNUT GROUT: MAPEL #7 - "CHOCOLATE" GROUT LINE: USE A 1/16" PATTERN: RUNNING BOND 1/3 OVER LAP COVE: DILEX-HK BRONZE BY SCHULTER SYS.	TILE BASE AROUND PUBLIC TILE AREA	COMPANY: DAL-TILE CONTACT: FREDERICK DAVIS PHONE: 972-423-5465 469-964-3246 FRED.DAVIS@DALTILE.COM

SYMBOL	ITEM	SPECIFICATION & COLOR	DESCRIPTION/ LOCATION OF USE	MANUFACTURER
SURFACES FINISHES				
SS-01	CORIAN	PRODUCT: CORIAN COLOR: 9091 ML - MIDNIGHT MELANGE THICKNESS: 1/2" EDGE: EASTED EDGE; 1/4" ROUND	ORDER/SALAD/BEV. BAR COUNTER	COMPANY: WILSONART
SS-04	SOLID SURFACE	PRODUCT: SAN GABRIEL RIVERSTONE 9138RS	RESTROOM COUNTER & HAND DRYER WALL	COMPANY: WILSONART

SYMBOL	ITEM	SPECIFICATION & COLOR	DESCRIPTION/ LOCATION OF USE	MANUFACTURER
LAMINATE				
PL-05	PLASTIC LAMINATE	PRODUCT: KHAKI BROWN D50-60	RESTROOM FACE DOOR ONLY	COMPANY: WILSONART



710

14005 E Exposition Ave.
Aurora, CO 80012

Owner:
CEC ENTERTAINMENT, INC.
Irving, TX 77063
ph: 972.258.5521
Contact: Walter Boyd
wboyd@cecentertainment.com

Architect:
PKWY Architects, LLC
1000 Civic Circle
Lewisville, TX 75287
Ph: 213.122.122
Contact: Greg Klimko

MEP Engineer:
Dialectic Engineering
310 W. 20 th street
200 Kansas City, MO 64108
ph: 816.997.9627
Contact: Joe Hillebrenner, P.E.



Architect: William D. Pounds

A	Permit Set	5/13/19
No.	Description	Date

DRAWN BY:	Author
CHECKED BY:	Checker
PROJ. NO:	08-19413

Copyright Parkway C&A, LP 2019

Schedules

A8.0



City of Aurora Building Division
Reviewed for Code Compliance
Approved as Noted: **Erick B.**
Date: **Jun 21, 2019**
2015 INTERNATIONAL CODES & 2017 NEC

RSN: **1369378**
Permit #: **19-1625136**

ELECTRICAL SYMBOLS LEGEND

HOME RUN TO PANEL. CIRCUIT NUMBERS, PHASE, NEUTRAL, AND GROUND CONDUCTORS INDICATED ALONG WITH ISOLATED GROUND CONDUCTOR IF APPLICABLE. PARTIAL CIRCUIT.

CONDUIT INSTALLED CONCEALED ABOVE CEILING OR IN WALL.

CONDUIT INSTALLED CONCEALED BELOW FLOOR SLAB OR UNDERGROUND.

GROUND CONNECTION.

SINGLE POLE SWITCH, +3'-10" OR AS NOTED.

THREE-WAY SWITCH, +3'-10" OR AS NOTED.

KEY OPERATED SWITCH, +3'-10" OR AS NOTED.

WEATHERPROOF TOGGLE SWITCH, +3'-10" OR AS NOTED.

SINGLE POLE SWITCH WITH PILOT LIGHT, +3'-10" OR AS NOTED.

WALL MOUNTED OCCUPANCY SENSOR, +3'-10" OR AS NOTED.

CEILING MOUNTED OCCUPANCY SENSOR.

CEILING MOUNTED INTERIOR DAYLIGHT HARVESTING PHOTOCELL SENSOR.

POWER PACK, INSTALLED ABOVE ACCESSIBLE CEILING.

SIMPLEX RECEPTACLE, +18" OR AS NOTED.

ISOLATED GROUND SIMPLEX RECEPTACLE, +18" OR AS NOTED.

DUPLEX RECEPTACLE, +18" OR AS NOTED.

ISOLATED GROUND DUPLEX RECEPTACLE, +18" OR AS NOTED.

QUADRUPLEX RECEPTACLE +18" OR AS NOTED.

ISOLATED GROUND QUADRUPLEX RECEPTACLE, +18" OR AS NOTED.

GROUND FAULT INTERRUPTING RECEPTACLE, +18" OR AS NOTED.

WEATHERPROOF GROUND FAULT INTERRUPTING RECEPTACLE, +18" OR AS NOTED.

SURGE PROTECTED RECEPTACLE, +18" OR AS NOTED.

RECEPTACLE INSTALLED HORIZONTALLY AT +18" OR AS NOTED.

RECEPTACLE INSTALLED HORIZONTALLY, BOTTOM AT +6" ABOVE COUNTER TOP.

RECEPTACLE INSTALLED FLUSH IN CEILING.

ISOLATED GROUND RECEPTACLE INSTALLED FLUSH IN CEILING.

SPECIAL RECEPTACLE, NEMA STYLE AS NOTED, +18" OR AS NOTED.

FLUSH FLOOR MOUNTED RECEPTACLE, LETTER INDICATES TYPE.

JUNCTION BOX.

DISCONNECT SWITCH, TOP AT +6'-0" OR AS NOTED.

DISCONNECT SWITCH PROVIDED WITH EQUIPMENT.

EXTERIOR PHOTOCELL, INSTALLED ON ROOF FACING NORTH.

CONTROL OR POWER RELAY, INSTALLED AS NOTED.

PUSHBUTTON, TOP AT +4'-6" OR AS NOTED.

DOOR BELL CHIMEM, +8'-0" OR AS NOTED.

CONTROL TRANSFORMER, INSTALLED AS NOTED.

THERMOSTAT, TEMPERATURE SENSOR, CARBON DIOXIDE SENSOR AND HUMIDISTAT PROVIDED BY MECHANICAL CONTRACTOR, +3'-10" OR AS NOTED.

ELECTRICALLY OPERATED DAMPER, PROVIDED BY MECHANICAL CONTRACTOR.

120 VOLT DUCT TYPE SMOKE DETECTOR, PROVIDED BY MECHANICAL CONTRACTOR.

SECURITY SYSTEM CONTROL PANEL, TOP AT 6'-0".

KEYPAD, +46" OR AS NOTED.

SECURITY CAMERA.

MOTION DETECTOR, CEILING MOUNTED.

DOOR CONTACTS.

TRANSFORMER, FLOOR MOUNTED OR SUSPENDED FROM STRUCTURE AS NOTED.

BRANCH CIRCUIT PANELBOARD, TOP AT +6'-0" OR AS NOTED.

DISTRIBUTION PANEL, TOP AT +6'-0" OR AS NOTED.

PLYWOOD PHONEBOARD, INSTALLED AS NOTED.

TELEPHONE/DATA OUTLET, +18" WITH 1" CONDUIT TO ABOVE CEILING.

TELEPHONE/DATA OUTLET, +6" WITH ABOVE COUNTER WITH 1" CONDUIT TO ABOVE CEILING.

GENERAL REFERENCES/NOTATIONS:

AC MOUNT DEVICE +6" ABOVE TOP OF COUNTER TO BOTTOM OF DEVICE.

+48" MOUNTING HEIGHT ABOVE FINISHED FLOOR TO CENTERLINE OF DEVICE.

03/E5 DETAIL OR SECTION REFERENCE.

??? FOODSERVICE EQUIPMENT DESIGNATION.

REVISION DESIGNATION.

TYPE EQUIPMENT DESIGNATION.

ABBREVIATIONS:

AFF/AFG	ABOVE FINISHED FLOOR/GRADE.	NEC	NATIONAL ELECTRICAL CODE.
AHJ	AUTHORITY HAVING JURISDICTION.	NPFA	NATIONAL FIRE PROTECTION ASSOCIATION.
BAS	BUILDING AUTOMATION SYSTEM.	NL	NIGHT LIGHT.
DNR	DEPARTMENT OF NATURAL RESOURCES.	NF	NON-FUSED.
EC	ELECTRICAL CONTRACTOR.	PA	PUBLIC ADDRESS.
EM	EMERGENCY.	PC	PLUMBING CONTRACTOR.
ETR	EXISTING TO REMAIN.	SPD	SURGE PROTECTION DEVICE.
FA	FIRE ALARM.	TYP	TYPICAL.
FPC	FIRE PROTECTION CONTRACTOR.	UL	UNDERWRITERS LABORATORIES.
FSEC	FOOD SERVICE EQUIPMENT CONTRACTOR.	UNO	UNLESS NOTED OTHERWISE.
GC	GENERAL CONTRACTOR.	UPS	UNINTERRUPTIBLE POWER SUPPLY.
MC	MECHANICAL CONTRACTOR.	WP	WEATHERPROOF.

SYMBOLS LEGEND NOTES:

1. REFER TO LIGHT FIXTURE SCHEDULE FOR SPECIFICATION AND INFORMATION ON ALL LUMINAIRES.

2. REFER TO SPECIFICATIONS AND PLAN NOTES FOR DETAILED DESCRIPTION OF ALL DEVICES SHOWN IN THIS SCHEDULE, PROVIDED BY THIS CONTRACTOR.

3. MOUNTING HEIGHTS INDICATED ARE MEASURED FROM FINISHED FLOOR TO THE CENTERLINE OF THE DEVICE UNLESS NOTED OTHERWISE.

Suspended Ceiling Systems and the Luminaires they support shall meet the requirements of 410.36(B) of The 2017 NEC.

In indoor locations in other than dwellings and associated accessory structures, fluorescent luminaires that utilize double ended lamps and contain ballast(s) that can be serviced in place shall have a disconnecting means either internal or external to each luminaire. 410.130 (G)(1) 2017 NEC.

Provide Emergency Illumination Equipment that complies with 2017 NEC 700.12(F) or 2017 NEC 700.



Field Inspection consultation is available upon request. Call 303-739-7420 to request a consultation

Code violations that are found during inspection are required to be corrected. Permit issuance does not grant approval of a code violation.

1 LIGHTING FLOOR PLAN

1/8" = 1'-0"

LIGHTING FIXTURE SCHEDULE						
Type Mark	MANUFACTURER	CATALOG NUMBER	DESCRIPTION	LAMPS	VOLTS	FIXTURE WATTS
D	KARTELL FLY SUSPENSION LAMP	KRT-FLY-9031	FLY SUSPENSION LAMP COLOR: ORANGE; DIM 20.5"D X 13"H; 10" MAX HEIGHT	E26 MEDIUM BASE HALOGEN MAP	277 V	0 VA
L1	WAC LIGHTING	WS-W2604-BK	EXTERIOR WALL SCONCE LED TUBE DOWN OUTDOOR WALL LIGHT. COLOR: BLACK; DIM. 5"L X 7"H X 6" EXTENSION	LED LAMP INCLUDED	120 V	43 VA
LP	LIGHTOLIER	LPW2784U	4'-0" LONG VANITY LIGHT OVER RESTROOM LAVITORIES	GE F32T8/XL/SPX41HL/EC	120 V	18 VA

City of Aurora Building Division
Reviewed for Code Compliance
Approved as Noted: **Erick B.**
Date: **Jun 21, 2019**
2015 INTERNATIONAL CODES & 2017 NEC

RSN: 1369378
Permit #: 19-1625136

Dialectic

Dialectic, Inc.
310 W 20th Street, Suite 200
Kansas City, MO 64108

T 816-997-9601
F 816-997-9602
DialecticEng.com

Copyright 2019

THIS SHEET IS PART OF THE CONSTRUCTION DOCUMENTS. OTHER SHEETS INCLUDING SPECIFICATIONS APPLY. THAT SHOWN HERON IS SCHEMATIC IN NATURE AND NOT TO BE USED AS A SHOP DRAWINGS; THEREFORE, INCLUDE ALL MODIFICATIONS REQUIRED TO CONFORM TO SITE CONDITIONS AND THE EQUIPMENT AND MATERIAL USED. VERIFY LOCATIONS AND DIMENSIONS OF ALL ARCHITECTURAL AND STRUCTURAL ELEMENTS AS SHOWN ON THEIR RESPECTIVE DOCUMENTS. THESE ELEMENTS ARE SHOWN FOR REFERENCE AND SHALL BE VERIFIED PRIOR TO CONSTRUCTION AND THE ENGINEER ASSUMES NO LIABILITY FOR THE ACCURACY OF THESE ELEMENTS. NO DESIGN RESPONSIBILITY IS ASSUMED FOR ANY PORTION OF THE WORK THAT THE PROFESSIONAL ENGINEER HAS NOT SIGNED AND SEALED PER STATE REQUIREMENTS.



710

14005 E Exposition Ave.
Aurora, CO 80012

Owner:
CEC ENTERTAINMENT, INC.
Irving, TX 77063
ph: 972.258.5476
Contact: Mark Cramer
mcramer@cecentertainment.com

Architect:
Parkway C&A, LP
1000 Civic Circle
Lewisville, TX 75287
Ph: 213.122.122
Contact: Greg Klimko

MEP Engineer:
Dialectic
300 W 20th St #200
Kansas City, MO 64108
Ph: 816.977.9601
Contact: Joe Hillsbrenner, P.E.



Architect: Greg Klimko

A	Permit Set	2019 05 15
No.	Description	Date

DRAWN BY: JGM
CHECKED BY: ATF
PROJ. NO: 08-19413
Copyright Parkway C&A, LP 2019 ©

LIGHTING FLOOR PLAN

E1.0

ELECTRICAL GENERAL NOTES


- 1 INCLUDE ALLOWANCE FOR UNFORSEEN CONDITIONS THAT MAY AFFECT THE SCOPE OF WORK. MINOR DEVIATIONS REQUIRED FOR ACCOMPLISHING THE INTENT OF THIS DESIGN ARE TO BE INCLUDED IN THIS ALLOWANCE.
- 2 ELECTRICAL DESIGN HAS BEEN BASED ON THE INSTALLATION OF 75°C CONDUCTORS CONNECTED TO TERMINAL LUGS AND EQUIPMENT U.L. LISTED FOR A MINIMUM 75°C CONDUCTORS TERMINATED ON EQUIPMENT WITH A LOWER RATING 60°C) OR NO RATING SHOWN TO HAVE CONDUCTOR SIZE INCREASED TO CONFORM TO ADOPTED ELECTRICAL CODE AND UL/CUL NO. 489 REQUIREMENTS.
- 3 CONDUIT INSTALLED INDOORS SHALL BE ELECTRICAL METALLIC TUBING (EMT), MINIMUM 1/2" OR AS NOTED.
- 4 CONDUIT INSTALLED BELOW SLAB SHALL BE RIGID STEEL, IMC, PVC OR HDPE, MINIMUM 3/4". IF PVC OR HDPE IS USED, TRANSITION TO RIGID STEEL BEFORE TURNING UP AND PENETRATING FLOOR SLAB.
- 5 CONDUCTORS SHALL BE A MINIMUM OF #12 THHN/THWN COPPER UNLESS NOTED OTHERWISE ON PLANS OR IN SPECIFICATIONS. BRANCH CIRCUITS SHALL BE PROVIDED WITH (2) #12 CONDUCTORS AND (1) #12 EQUIPMENT GROUND CONDUCTOR UNLESS NOTED OTHERWISE.
- 6 BRANCH CIRCUITS SHOWN WITH TWO GROUNDING CONDUCTORS SHALL HAVE ONE EQUIPMENT GROUND CONDUCTOR (GREEN) AND ONE ISOLATED GROUND CONDUCTOR (GREEN W/ YELLOW STRIP) INSTALLED IN RACEWAY.
- 7 DIRECT CURRENT WIRING SHALL BE (2) #10 IN 1/2" CONDUIT UNLESS NOTED OTHERWISE.
- 8 CONTROL VOLTAGE WIRING SHALL BE PLENUM RATED OR INSTALLED IN CONDUIT.
- 9 PROVIDE FLEXIBLE CONNECTIONS ONLY FOR FINAL CONNECTION TO EQUIPMENT. 6'-0" MAXIMUM LENGTH. PROVIDE LIQUID TIGHT FLEXIBLE EQUIPMENT. 6'-0" MAXIMUM LENGTH. PROVIDE LIQUID TIGHT FLEXIBLE CONNECTION AT EXTERIOR LOCATIONS AND WHERE EXPOSURE TO MOISTURE IS POSSIBLE.
- 10 ALL EMPTY CONDUITS SHALL BE PROVIDED WITH A PULL WIRE.
- 11 ALL RACEWAYS HALL CONTAIN A GROUNDING ELECTRODE SIZED PER THE ADOPTED ELECTRICAL CODE.
- 12 COORDINATE WORK ABOVE THE CEILING WITH OTHER TRADES TO PROVIDE THE GREATEST POSSIBLE CLEARANCE. CONDUIT RUNS SHALL BE RUN THROUGH TRUSSES WHERE POSSIBLE.
- 13 VERIFY EXACT PLACEMENT OF ALL DEVICES SHOWN ON THE CONSTRUCTION DOCUMENTS PRIOR TO FINAL PLACEMENT.
- 14 ALL PANELBOARDS, SWITCHBOARDS AND LINE VOLTAGE CONTROL EQUIPMENT SHALL BE FIELD MARKED TO WARN QUALIFIED PERSONS OF POTENTIAL ELECTRIC ARC FLASH HAZARDS. MARKING SHALL BE LOCATED SO AS TO BE CLEARLY VISIBLE TO QUALIFIED PERSONS BEFORE EXAMINATION, ADJUSTING, SERVICING OR MAINTENANCE OF EQUIPMENT. MARKING SHALL BE SELF ADHESIVE, COMMERCIAL LABEL CONFORMING TO ADOPTED CODES.
- 15 LIGHT SWITCHES, ELECTRICAL OUTLETS, THERMOSTATS AND OTHER ENVIRONMENTAL CONTROLS LOCATED NO HIGHER THAN 48" AND NO LOWER THAN 15" ABOVE THE FLOOR. IF THE REACH IS OVER AN OBSTRUCTION BETWEEN 20" AND 25" IN DEPTH, THE MAXIMUM HEIGHT IS TO BE REDUCED TO 44" FOR FORWARD APPROACH OR 46" FOR SIDE APPROACH, PROVIDED THE OBSTRUCTION IS NO MORE THAN 24" IN DEPTH. OBSTRUCTIONS SHALL NOT EXTEND MORE THAN 25" FROM THE WALL BENEATH A CONTROL.
- 16 TERMS SHALL - ACTION THAT IS REQUIRED WITHOUT OPTION OR QUALIFICATION. FURNISH - CONTRACTOR SHALL BE RESPONSIBLE FOR OBTAINING. INSTALL - CONTRACTOR SHALL BE RESPONSIBLE FOR LABOR AND CONSTRUCTION EQUIPMENT NECESSARY TO SET IN PLACE. CONNECT - CALIBRATE AND/OR TEST EQUIPMENT FURNISHED BY HIM OR OTHERS. PROVIDE - CONTRACTOR SHALL FURNISH AND INSTALL.

REMODEL GENERAL NOTES

- 1 ALL EXISTING EQUIPMENT, WIRING DEVICES, LIGHTS, CONDUIT, WIRING, CIRCUITING, ETC. NOT DISTURBED BY NEW CONSTRUCTION WORK SHALL BE MAINTAINED AND UNDAMAGED. THESE DEVICES, IF SHOWN, ARE SHOWN FOR INFORMATION PURPOSES ONLY. VISIT THE JOB SITE TO VERIFY ALL EXISTING CONDITIONS AND FAMILIARIZE THEMSELVES WITH ALL WORK TO BE DONE AT THE JOB SITE. FAILURE TO DO SO SHALL NOT RELIEVE CONTRACTOR OF THE RESPONSIBILITY FOR PERFORMING ALL WORK NECESSARY TO PROVIDE A WORKMANLIKE INSTALLATION.
- 2 EXISTING SERVICES (ELECTRICAL, FIRE ALARM, ETC.) SHALL NOT BE INTERRUPTED WITHOUT PRIOR SCHEDULING OF SUCH OUTAGES WITH THE OWNER, ARCHITECT, AND ALL OTHER PARTIES INVOLVED.
- 3 MAINTAIN ACCURATE RECORDS OF ALL MODIFICATIONS TO EXISTING SYSTEMS WHICH ARE TO REMAIN. DELIVER ALL "RECORD" DRAWINGS TO THE OWNER INDICATING SUCH CHANGES.
- 4 DISCONNECT AND LABEL ABANDONED FEEDERS AND CIRCUITS.
- 5 REMOVE ALL EXPOSED CONDUITS, CONDUITS ABOVE LAY-IN CEILINGS, OR EQUIPMENT WHICH IS ABANDONED.
- 6 WHERE NEW WORK INTERFERES WITH CIRCUITS IN ROOMS OTHERWISE UNDISTURBED, EXISTING CIRCUITS SHALL BE REWORKED AS REQUIRED TO MAINTAIN SERVICE.
- 7 ALL EQUIPMENT, FIXTURES, PANELBOARDS, CONDUIT AND WIRING THAT ARE REMOVED SHALL BE REMOVED FROM THE JOB SITE, UNLESS DIRECTED OTHERWISE BY THE ARCHITECT OR OWNER'S REPRESENTATIVE.
- 8 EXISTING ROUGH-IN BOXES AND CONDUIT MAY BE UTILIZED IF THEY ARE OF PROPER SIZE AND IN SUITABLE LOCATION(S) FOR NEW CONSTRUCTION. DEVICES AND WIRING SHALL BE NEW.
- 9 CIRCUIT ROUTINGS SHOWN IN REMODELED AREAS MAY BE MODIFIED TO SUIT FIELD CONDITIONS, KEEP DEVICES AND/OR FIXTURE CIRCUITS APPROXIMATELY AS INDICATED TO LIMIT VOLTAGE DROP OF FEEDER AND BRANCH CIRCUITS.
- 10 VERIFY THE LOCATION AND CONDITION OF ALL EXISTING UTILITIES AND PROTECT DURING THE COURSE OF THEIR WORK. EXISTING UTILITIES, BUILDING MATERIALS AND ANY ASSOCIATED ITEMS WHICH ARE DAMAGED BY CONTRACTOR'S NEGLIGENCE SHALL BE REPAIRED OR REPLACED AT THE CONTRACTOR'S EXPENSE (IN A TIMELY MANNER) AND TO THE OWNER'S APPROVAL.
- 11 COORDINATE THE REMOVAL OR RELOCATION OF ALL MECHANICAL AND PLUMBING EQUIPMENT. DISCONNECT AND REMOVE ALL ELECTRICAL POWER AND CONTROL CIRCUITS FOR EQUIPMENT BEING REMOVED OR RELOCATED. EXISTING CONDUIT AND ROUGH-IN MAYBE USED FOR RELOCATED OR NEW EQUIPMENT. ALL CONDUCTORS SHALL BE NEW.
- 12 REMOVE ALL EXISTING DATA, TELEPHONE, FIRE ALARM CABLING AND ANY OTHER LOW VOLTAGE WIRING THAT ARE NOT TO BE USED.
- 13 DESIGN IS BASED ON FIELD INFORMATION, AS-BUILT DRAWINGS AND OWNER FURNISHED INFORMATION. VERIFY ACCURACY OF ALL EXISTING CONDITIONS. IN CASE OF DISCREPANCY, PROVIDE ALL NECESSARY CONDUIT, WIRE, BOXES, FITTINGS, ETC. FOR A COMPLETE OPERATING ELECTRICAL SYSTEM. ENTIRE INSTALLATION TO COMPLY WITH SPECIFICATIONS AND ADOPTED ELECTRICAL CODE.

Code violations that are found during inspection are required to be corrected. Permit issuance does not grant approval of a code violation.

Field Inspection consultation is available upon request. Call 303-739-7420 to request a consultation

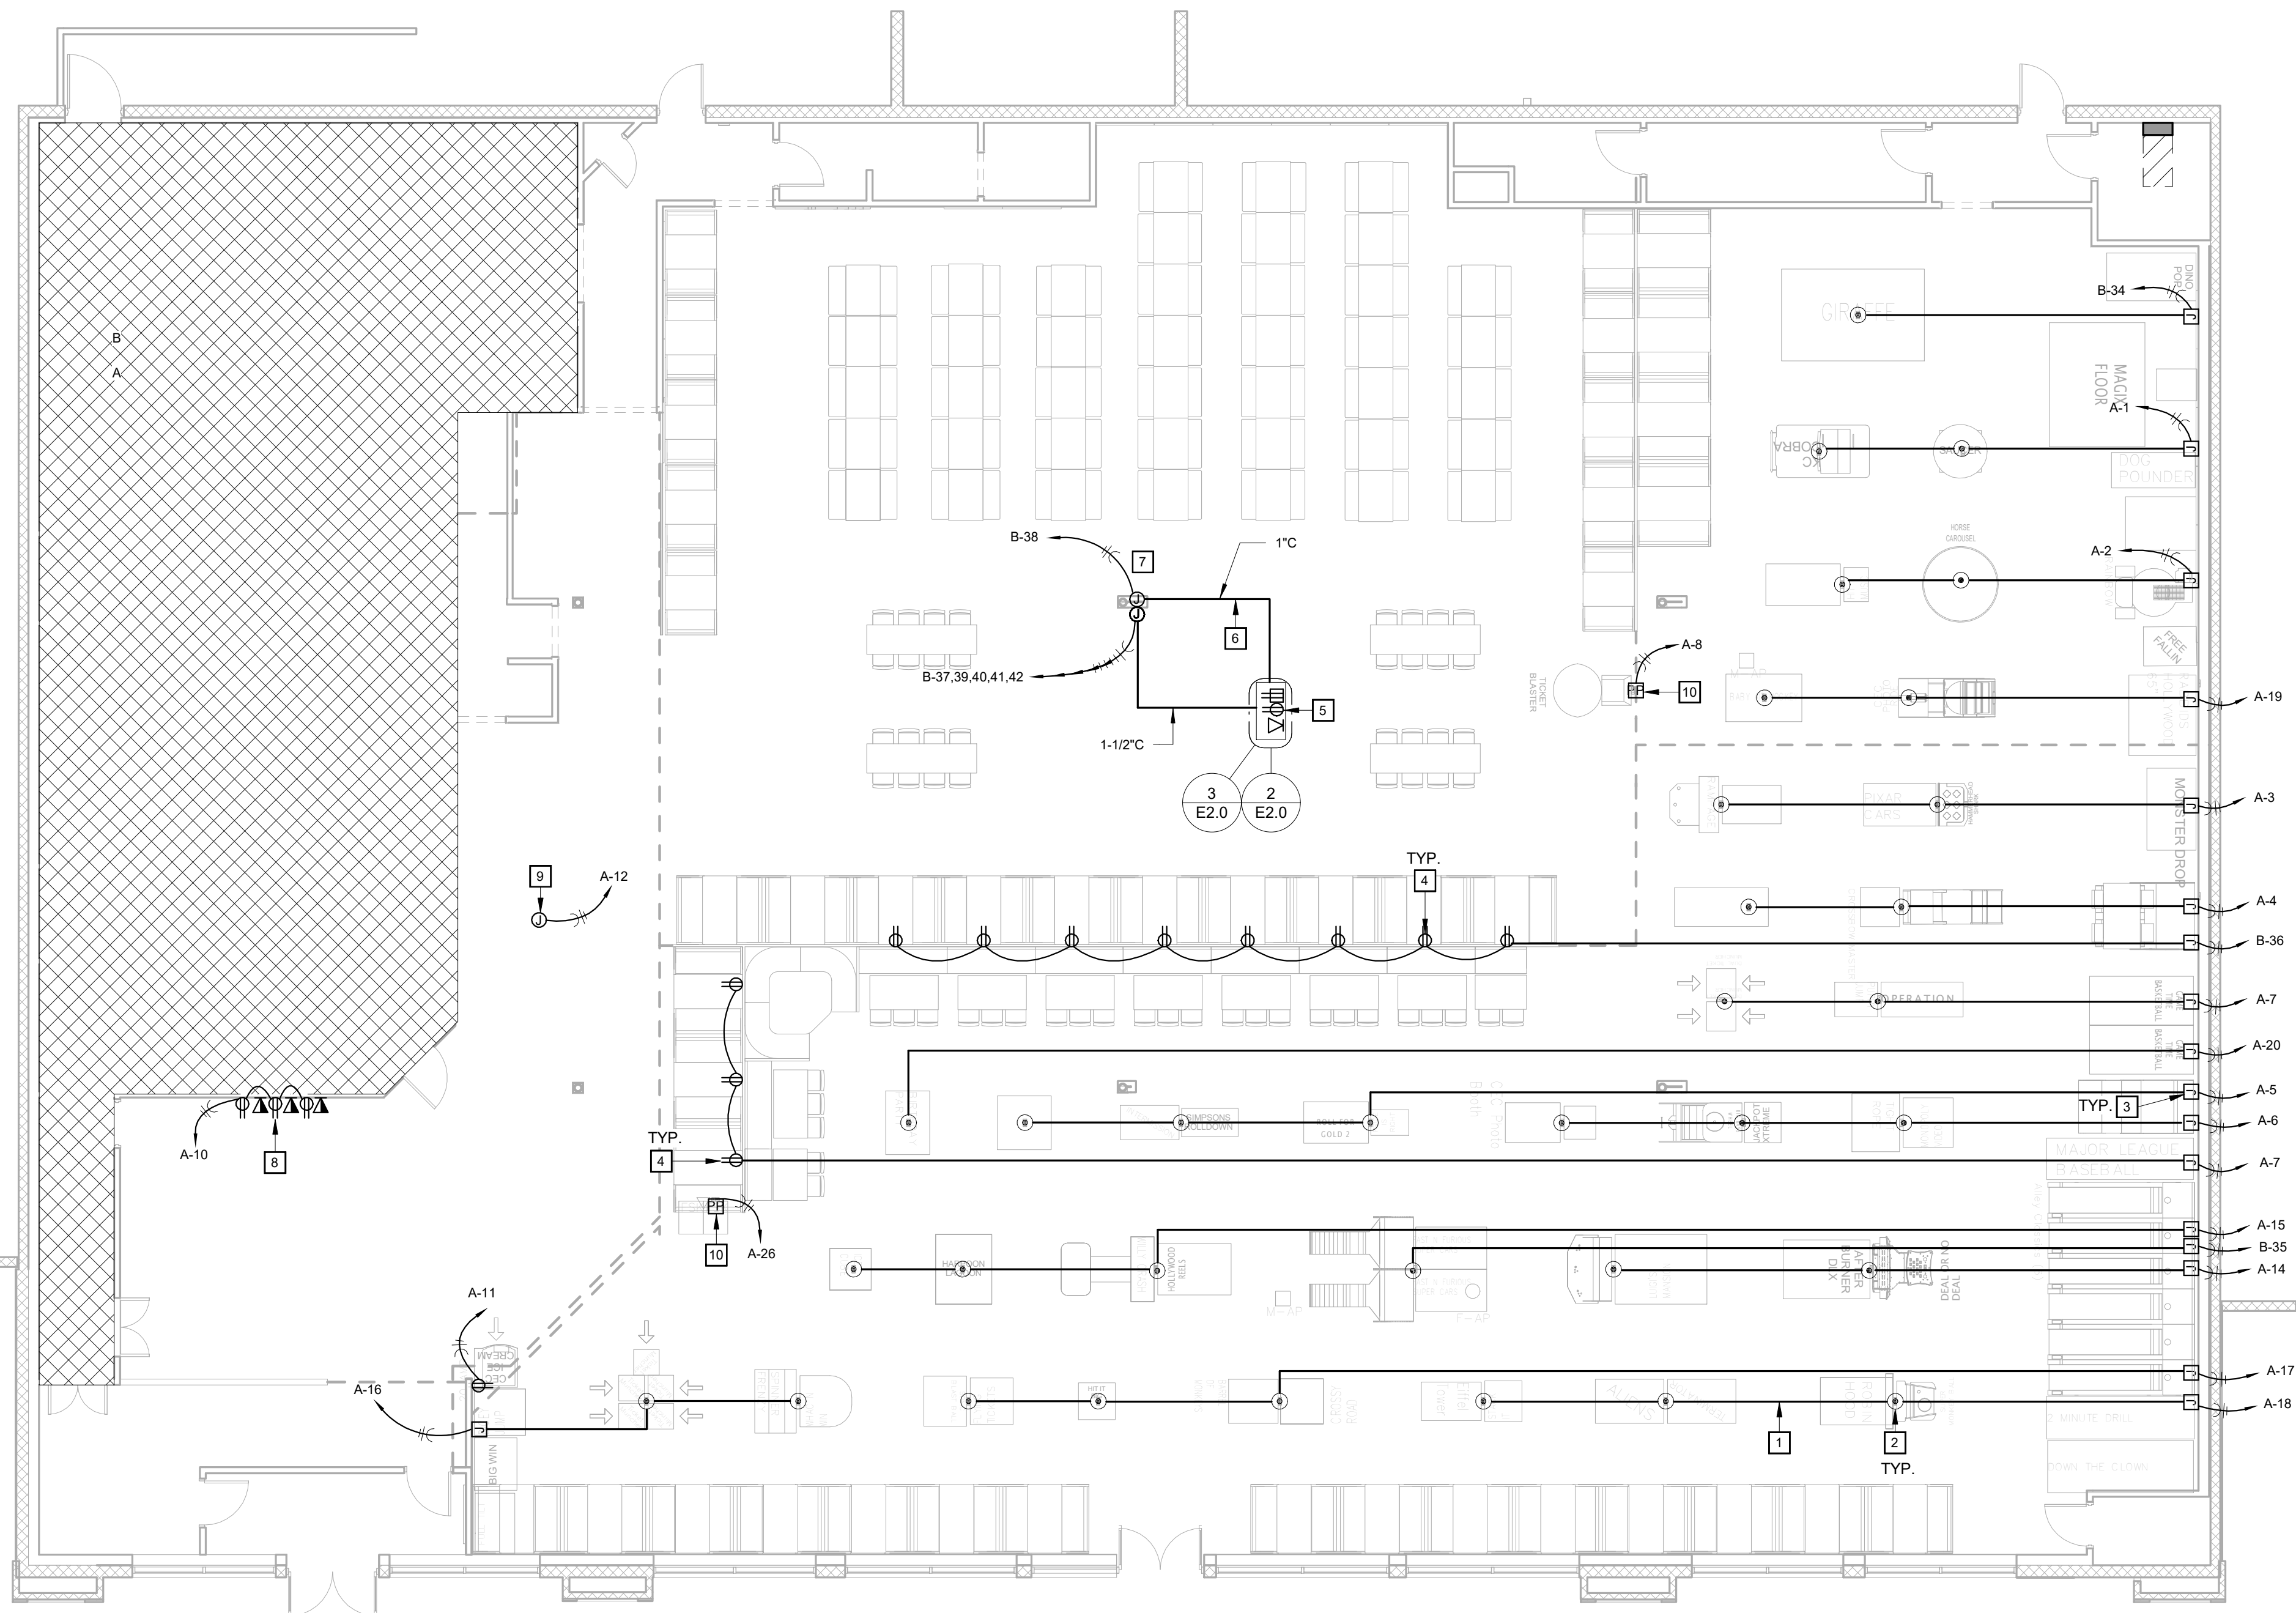

1 POWER FLOOR PLAN
1/8" = 1'-0"

BID NOTES


- 1 CONTRACTOR SHALL PROVIDE BID TO INSTALL UNDER CARPET WIRING SYSTEM FOR POWER DISTRIBUTION TO ARCADE GAMES. SYSTEM SHALL COMPLY WITH NEC REQUIREMENTS AND BE AS PROVIDED BY TYCOAMP SYSTEMS. CONTACT SARAH MAKE (817) 213 1533, Sarah.Moake@graybar.com) FOR INFORMATION AND QUANTITIES OF FCC AND ACCESSORIES FOR UNDER CARPET WIRING INSTALLATION.
- 2 ADDITIONAL CABLE/FLOOR PREPARATION SHALL BE REQUIRED FOR PROPER INSTALLATION. E.G. FLOOR PREPARATION, TOP SHIELD, ADHESIVE, HOLD-DOWN TAPE, PATCHING, BONDING CLIPS, ETC. COORDINATE WITH MANUFACTURERS RECOMMENDED INSTALLATION TECHNIQUES AND ACTUAL FIELD CONDITIONS. PROVIDE AS NEEDED.

POWER GENERAL NOTES


- 1 ALL OUTLETS ACCESSIBLE TO PUBLIC SHALL BE TAMPER RESISTANT.
- 2 OUTLETS SHALL BE CONCEALED FROM PUBLIC AND LOCATED BEHIND EQUIPMENT.
- 3 REFER TO SHEET A1.2 FOR FLOOR RECEPTACLE LOCATIONS.
- 4 ELECTRICAL CONTRACTOR TO FIELD VERIFY ALL CIRCUIT REQUIREMENTS WITH OWNER AND EXISTING SPARE PANEL SPACE IS AVAILABLE IN PANELS.
- 5 ELECTRICAL CONTRACTOR TO FIELD VERIFY WORKING ORDER AND QUANTITY OF EXISTING CIRCUITS SERVING GAMES.

ELECTRICAL KEYNOTES

- 1 TYCOAMP UNDER CARPET WIRING SYSTEM CABLE ROUTE. INSTALL PER MANUFACTURERS RECOMMENDATIONS AND REQUIREMENTS.
- 2 TYCOAMP UNDER CARPET WIRING SYSTEM ACTIVATION AND OUTLET BOX. INSTALL PER MANUFACTURERS RECOMMENDATIONS AND REQUIREMENTS. VERIFY WITH PROJECT MANGER ANY FINAL CHANGE TO GAME LAYOUT PRIOR TO INSTALLING.
- 3 PROVIDE FULLY RECESSED TRANSITION BOX FOR UNDER CARPET WIRING SYSTEM CONNECTION.
- 4 PROVIDE DUPLEX RECEPTACLE WITH TWO(2) INTEGRAL USB CHARGING PORT AT EACH RECEPTACLE. MOUNT DEVICE HORIZONTALLY ALONG DIMENSION MOUNT @2'-8" A-F-F. INSTALL MC CABLE OR FLEX CONDUIT IN FURNITURE HOLLOW SPACE BETWEEN BOOTHS. VERIFY REQUIREMENTS AT IN FIELD.
- 5 12"X12"X8" BOX RECESSED INTO FLOOR BELOW RAMP. (1) QUAD RECEPTACLE SPLIT TO RECEIVE (4) DEDICATED 20A CIRCUITS AND (1) DUPLEX RECEPTACLE TO RECEIVE (1) DEDICATED 20A CIRCUIT. (1) SINGLE GANG DATA BOX (RJ45 KEYSTONE PLATE AND PORTS PROVIDED BY CEC) INSTALLED BY GC.
- 6 (2) YELLOW CAT6 CABLES FROM FLOOR BOX TO AV ROOM WITH 12' OF SLACK. YELLOW CAT6 PROVIDED BY CEC AND INSTALLED BY GC.
- 7 EXTEND 1" CONDUIT TO ABOVE ACCESSIBLE CEILING SPACE WITH (2)YELLOW CAT6 BACK TO AV ROOM. YELLOW CAT6 BY CEC AND INSTALLED BY GC.
- 8 DISCONNECT AND RECONNECT WIRING FROM EXISTING MENU BOARDS. INSTALL (3) DATA AND (3) DUPLEX OUTLETS FOR DIGITAL MENU BOARDS. REF MENU BOARD SECTION DETAIL 2 ON ARCHITECTURAL SHEET A403.
- 9 PROVIDE FINAL CONNECTIONS TO STRUCTURE HUNG "YOU WON" SIGN. VERIFY LOCATION WITH ARCHITECT.
- 10 SATIN ANODIZED ALUMINUM, 10'-5" TELE-POWER POLE WITH TWO SEPARATE WIREWAY COMPARTMENTS. ONE COMPARTMENT FOR POWER WIRING WITH TWO DUPLEX, 20AMP, 125 VOLT RECEPTACLES IN COVER FACE AND POWER JUNCTION BOX AT TOP OF POLE. SECOND COMPARTMENT FOR COMMUNICATION WIRING WITH REMOVABLE COVER SECTION AT BOTTOM OF POLE FOR CABLE ACCESS. WIREMOLD #AMDTP-4.

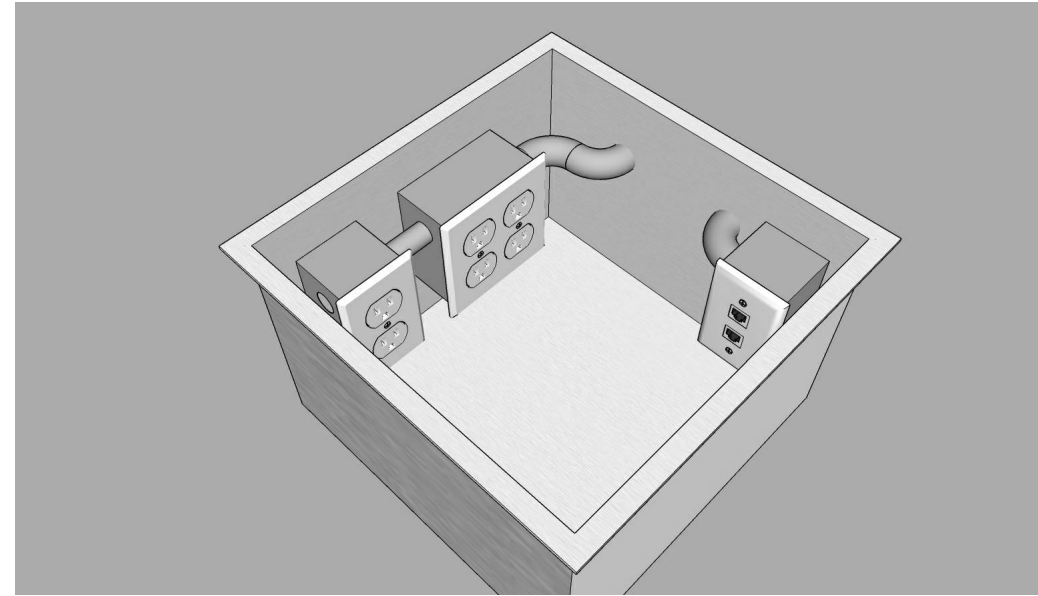

2 DANCE FLOOR POWER BOX
NOT TO SCALE

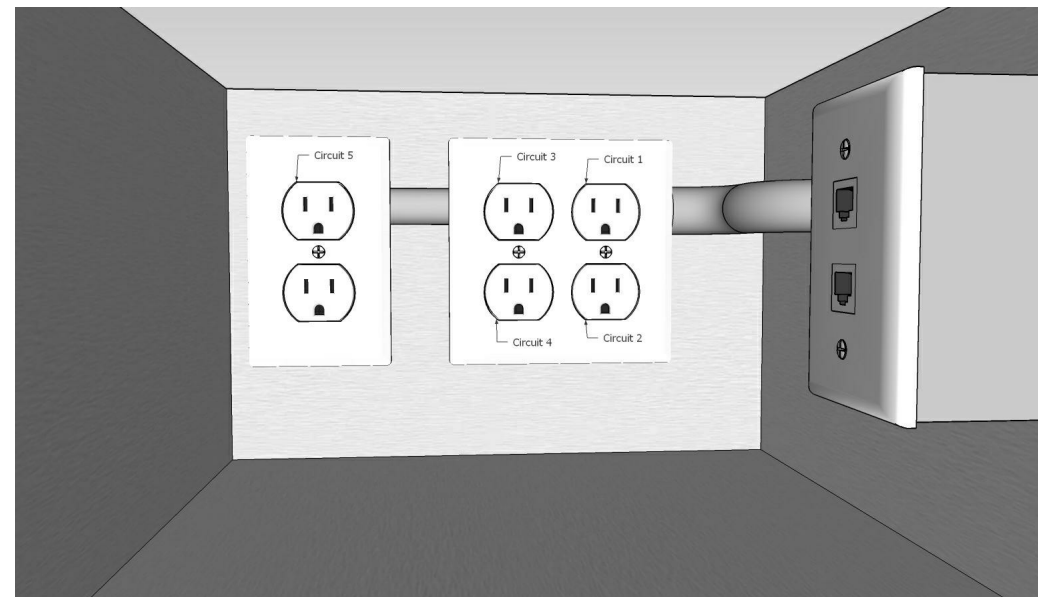

3 DANCE FLOOR POWER BOX ELEVATION
NOT TO SCALE

THIS SHEET IS PART OF THE CONSTRUCTION DOCUMENTS. OTHER SHEETS INCLUDING SPECIFICATIONS APPLY. THAT SHOWN HEREON IS SCHEMATIC IN NATURE AND NOT TO BE USED AS A SHOP DRAWINGS; THEREFORE, INCLUDE ALL MODIFICATIONS REQUIRED TO CONFORM TO SITE CONDITIONS AND THE EQUIPMENT AND MATERIAL USED. VERIFY LOCATIONS AND DIMENSIONS OF ALL ARCHITECTURAL AND STRUCTURAL ELEMENTS AS SHOWN ON THEIR RESPECTIVE DOCUMENTS. THESE ELEMENTS ARE SHOWN FOR REFERENCE AND SHALL BE VERIFIED PRIOR TO CONSTRUCTION AND THE ENGINEER ASSUMES NO LIABILITY FOR THE ACCURACY OF THESE ELEMENTS. NO DESIGN RESPONSIBILITY IS ASSUMED FOR ANY PORTION OF THE WORK THAT THE PROFESSIONAL ENGINEER HAS NOT SIGNED AND SEALED PER STATE REQUIREMENTS.

Dialectic

Dialectic, Inc.
310 W 20th Street, Suite 200
Kansas City, MO 64108

T 816-997-9601
F 816-997-9602
DialecticEng.com

Copyright 2019

City of Aurora Building Division
Reviewed for Code Compliance
Approved as Noted: **Erick B.**
Date: **Jun 21, 2019**
2015 INTERNATIONAL CODES & 2017 NEC

RSN: 1389378
Permit #: 19-1625136



710

14005 E Exposition Ave.
Aurora, CO 80012

Owner:
CEC ENTERTAINMENT, INC.
Irving, TX 77063
ph: 972.258.5476
Contact: Mark Cramer
mcramer@cecentertainment.com

Architect:
Parkway C&A, LP
1000 Civic Circle
Lewisville, TX 75087
Ph: 213.122.122
Contact: Greg Klimko

MEP Engineer:
Dialectic
300 W 20th St #200
Kansas City, MO 64108
Ph: 816.977.9601
Contact: Joe Hillebrenner, P.E.






Architect: Greg Klimko

A	Permit Set	2019 05 15
No.	Description	Date

DRAWN BY: JGM
CHECKED BY: ATF
PROJ. NO: 08-19413
Copyright Parkway C&A, LP 2019 ©

POWER FLOOR PLAN

E2.0

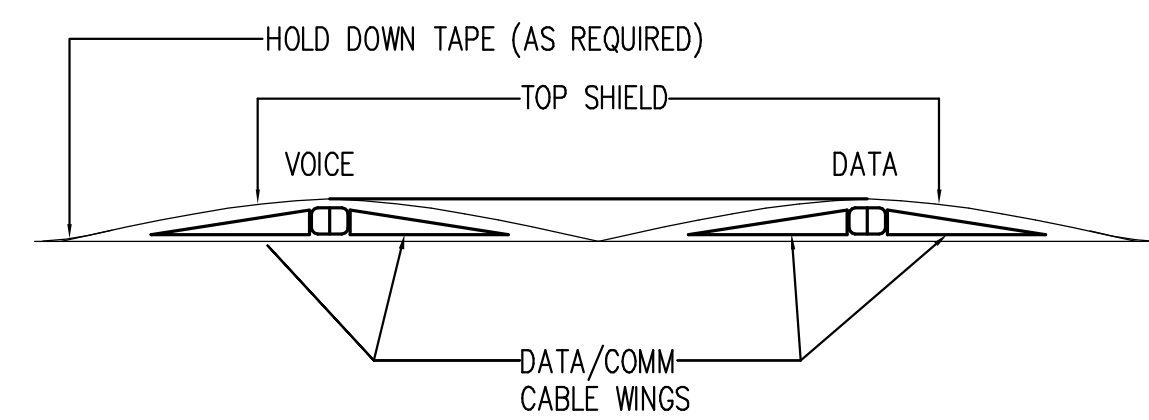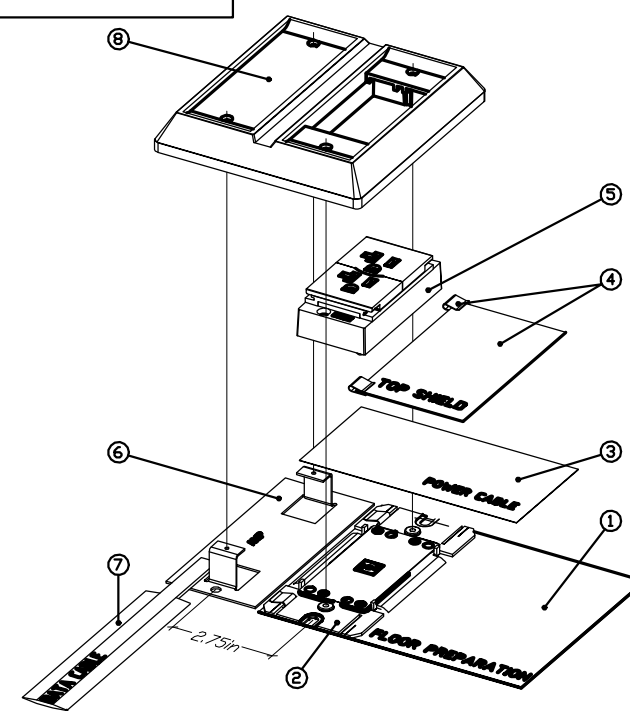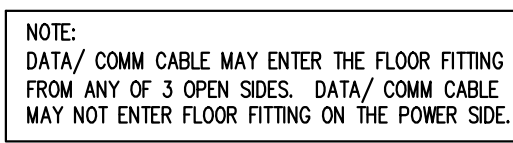

3 INSTALLATION DETAIL

2 INSTALLATION STEPS 1-8

1 DATA/COMM UNDERCARPET DETAIL

EXISTING PANEL: B				LOCATION: Kitchen 126				NEMA ENCLOSURE: Type 1						
SYSTEM: 120/208V - 3P				BUS RATING: 100 A				CABINET MOUNTING: Surface						
FEEDER: SEE RISER DIAGRAM				MAINS: 100 A - MCB				LUGS: EXISTING						
OPTIONS:								AIC RATING: EXISTING 10,000						
LOAD DESCRIPTION	BKR SIZE	BKR POLR	NOTE	CKT NO.	A	B	C	CKT NO.	NOTE	BKR POLR	BKR SIZE	LOAD DESCRIPTION		
RELAY PB-1	20 A	1	EX	15	800	800		2	EX	1	20 A	SPARE		
RELAY PB-1	20 A	1	EX	3		800	800	4	EX	1	20 A	SPARE		
RELAY PB-2	20 A	1	EX	5				6	EX	1	20 A	SPARE		
ERLAY PB-2	20 A	1	EX	7	900	800		8	EX	1	20 A	SPARE		
COMPUTER/ LIGHTS	20 A	1	EX	9		800	800	10	EX	1	20 A	SPARE		
DIMMER PANEL	20 A	1	EX	11			800	800	12	EX	1	20 A	SPARE	
DIMMER PANEL	20 A	1	EX	13	800	800		14	EX	1	20 A	SPARE		
CONSOLE AND LIGHTING	20 A	1	EX	15		800	800	16	EX	1	20 A	SPARE		
ROBO SCANS	20 A	1	EX	17			800	800	18	EX	1	20 A	SPARE	
STAGE LIGHTS	20 A	1	EX	19	800	800		20	EX	1	20 A	SPARE		
ROBO COLOS	20 A	1	EX	21		800	800	22	EX	1	20 A	SPARE		
SPARE/RECEPTACLES	20 A	1	EX	23			800	800	24	EX	1	20 A	SPARE	
DTU 1 & 2	20 A	1	EX	25	800	800		26	EX	1	20 A	SPARE		
SHOW RACK	20 A	1	EX	27		800	800	28	EX	1	20 A	SPARE		
RECEPTACLES	20 A	1	EX	29				30	R	1	20 A	EXTERIOR LIGHTING		
BALCONY, HALLWAY RCPT	20 A	1	EX	31	800	645		32	R	1	20 A	PENDANT LIGHTING		
BALCONY RCPT	20 A	1	EX	33		800	180	34	R	1	20 A	NEW GAME CIRCUIT		
NEW GAME CIRCUIT	20 A	1	R	35			180	1440	36	R	1	20 A	BOOTH USB	
DANCE FLOOR DEDICATED	20 A	1	R	37	180	180			38	R	1	20 A	DANCE FLOOR DEDICATED	
DANCE FLOOR DEDICATED	20 A	1	R	39			180	180	40	R	1	20 A	DANCE FLOOR DEDICATED	
DANCE FLOOR DEDICATED	20 A	1	R	41				180	180	42	R	1	20 A	DANCE FLOOR DEDICATED
PHASE A: 9905 W								CONNECTED		DEMAND				
PHASE B: 9340 W								28477 W		28651 W				
PHASE C: 9232 W								79 A		80 A				

EXISTING PANEL: A				LOCATION: Kitchen 126				NEMA ENCLOSURE: Type 1				
SYSTEM: 120/208V - 3P				BUS RATING: 200 A				CABINET MOUNTING: Surface				
FEEDER: SEE RISER DIAGRAM				MAINS: 200 A - MCB				LUGS: EXISTING				
OPTIONS:								A/C RATING: EXISTING 10,000				
LOAD DESCRIPTION	BKR SIZE	BKR POL	NOTE	CKT NO.	A	B	C	CKT NO.	NOTE	BKR POL	BKR SIZE	LOAD DESCRIPTION
NEW GAME CIRCUIT	20 A	1	r	1	540	180		2	R	1	20 A	NEW GAME CIRCUIT
NEW GAME CIRCUIT	20 A	1	R	3		540	540	4	R	1	20 A	NEW GAME CIRCUIT
NEW GAME CIRCUIT	20 A	1	R	5				6	R	1	20 A	NEW GAME CIRCUIT
BOOTH USB	20 A	1	R	7	360	0		8	R	1	20 A	Other
DANCE FLOOR TV MONITORS	20 A	1	R	9		1440	540	10	R	1	20 A	DIGITAL MENU BOARD
CEC ICE CREAM	20 A	1	R	11			180	12	R	1	20 A	YOU WON SIGN
TICKET BLASTER CAMERA	20 A	1	R	13	360	180		14	R	1	20 A	NEW GAME CIRCUIT
NEW GAME CIRCUIT	20 A	1	R	15		540	360	16	R	1	20 A	NEW GAME CIRCUIT
NEW GAME CIRCUIT	20 A	1	R	17			540	18	R	1	20 A	NEW GAME CIRCUIT
NEW GAME CIRCUIT	20 A	1	R	19	180	180		20	R	1	20 A	NEW GAME CIRCUIT
EYEBROW SIGN	20 A	1	R	21		800	110	22	R	1	20 A	RESTROOM LIGHTING
EXISTING CIRCUIT	20 A	1	EX	23			360	24	R	1	20 A	SIGN
SIGN	20 A	1	R	25	1200	0		26	R	1	20 A	Other
EXISTING CIRCUIT	20 A	1	EX	27		360	360	28	EX	1	20 A	EXISTING CIRCUIT
EXISTING CIRCUIT	20 A	1	EX	29			360	30	EX	1	20 A	EXISTING CIRCUIT
EXISTING CIRCUIT	20 A	1	EX	31	360	360		32	EX	1	20 A	EXISTING CIRCUIT
EXISTING CIRCUIT	20 A	1	EX	33		360	360	34	EX	1	20 A	EXISTING CIRCUIT
EXISTING CIRCUIT	20 A	1	EX	35			360	36	EX	1	20 A	EXISTING CIRCUIT
EXISTING CIRCUIT	20 A	1	EX	37	360	360		38	EX	1	20 A	EXISTING CIRCUIT
EXISTING CIRCUIT	20 A	1	EX	39		360	360	40	EX	1	20 A	EXISTING CIRCUIT
EXISTING CIRCUIT	20 A	1	EX	41			360	42	EX	1	20 A	EXISTING CIRCUIT
				PHASE A: 4620 W				CONNECTED		DEMAND		
				PHASE B: 7030 W				18250 W		18270 W		
				PHASE C: 6600 W				51 A		51 A		

Every circuit and circuit modification shall be legibly identified as to its clear, evident and specific purpose or use. The identification shall include an approved degree of detail that allows each circuit to be distinguished from all others. 2017 NEC 408.4

UNDERCARPET CABLING SYSTEM DETAILS														
TE	CONTRACTOR	BOM	PART NAME	NOTE	DESCRIPTION	AREA 2	AREA 3	AREA 4	AREA 5	AREA 6	AREA 7	CABLE AREA	TOTALS	NOTES
POWER														
1375045-X			FLRUS BY WALL		TRANSITION BOX AT WALL	1	1	1			1	---	---	TRANSITION BOX AT WALL
545482-1			POWER TRANSITION KIT		TRANSITION BOX	1	1	1				---	---	TRANSITION BLOCK, GOES IN TRANSITION BOX AT WALL
545482-1			POWER TRANS KIT		FLOOR TRANSITION BOX						1	---	---	FLOOR TRANSITION BOX
545425-X			1 FLOOR PREP									100	---	MOISTURE BARRIER, REQUIRED FOR SLAB-ON-GRADE INSTALLATIONS
553536-Y		2	2" POWER SHEL									100	---	METAL SHEL, REQUIRED FOR POWER CABLE
3-553079-Y		3	3C PWR CABLE, 12 AWG									100	---	ONE LINE, ONE NEUTRAL, ONE GROUND
545442-X			3C PWR CBL		FLOOR RECEPTACLE							---	---	FLOOR RECEPTACLE
545442-X			3C PWR CBL									---	---	TWO WIRED AT EACH TOP SHEL DIRECTIONAL CHANGE, TURN OR SPLICE
553534-X		4	TOP SHEL DIRECTIONAL CLIP			2	2	4				---	---	
DATA/COM														
1375045-X			FLRUS BY WALL		TRANSITION BOX AT WALL	1	1	1				---	---	TRANSITION BOX AT WALL
1470905-1			CAT 6 DATA/COM TRANS		JAMPER BLOCK, GOES IN TRANSITION BOX AT WALL - UP TO (6) 4-PR CABLES END			1				---	---	
553536-Y		5	2" POWER SHEL									100	---	METAL SHEL, OPTIONAL FOR DATA CABLE
1499539-Z		3	CAT 6 DATA/COM CBL			1	1	1				---	---	
1933377-1			MOD JACK BRACKET / OUTLET ADPT.			2	2	2				---	---	
MATERIALS														
6-553452-6			SPRAY ADHESIVE									3	---	REQUIRED TO HELP BOND CABLING TO FLOOR AND SEAL SYSTEM FROM MOISTURE
553481-1		8	HOLD DOWN TAPPS									---	---	REQUIRED TO FASTEN POWER CABLE SYSTEM TO FLOOR
1756086-1		7	DATA/COM CABLE NOTING LUG									1	---	RECOMMENDED FOR NOTING DATA CABLE JOINTS FOR DIRECTIONAL CHANGES OR TURNS
BOM NOTES														
1. FLOOR PREP REQUIRED FOR SLAB-ON-GRADE OR MOISTURE-SENSITIVE INSTALLATIONS, BUT RECOMMENDED FOR ALL POWER CABLE INSTALLATIONS.														
2. 1 FT FLOOR PREPARATION REQUIRED PER 1 FT POWER CABLE, NOT REQUIRED FOR COMMUNICATIONS CABLE.														
3. TOP SHEL REQUIRED FOR ALL POWER CABLE INSTALLATIONS.														
4. ACTUAL CABLE QUANTITIES SHALL BE VERIFIED BY INSTALLER.														
5. INCLUDE ADDITIONAL LENGTH FOR WALL TERMINATION, APPROXIMATELY 2 FT PER LOCATION.														
6. TOP SHEL DIRECTIONAL CLIPS REQUIRED AT ALL TAPS, SPLICES AND TURNS.														
7. 2 CLIPS REQUIRED FOR LOCATION.														
8. TOP SHEL OPTIONAL FOR DATA/COM CABLEING INSTALLATIONS.														
9. 1 FT SHEL REQUIRED PER LOCATION, PER 1 FT COMMUNICATIONS CABLE, EXCEPT THAT MULTIPLE COMMUNICATIONS CABLES IN THE SAME CIRCUIT PATH MAY BE PLACED SIDE BY SIDE UNDER ONE TOP SHEL.														
10. SPRAY ADHESIVE REQUIRED FOR PROPER POWER CABLEING INSTALLATION, SPRAY ADHESIVE OPTIONAL FOR DATA/COM INSTALLATION.														
11. ONE CAN SPRAY ADHESIVE REQUIRED PER 100 FT POWER CABLE. ON CAN SPRAY ADHESIVE OPTIONAL, PER 200 FT COMMUNICATIONS CABLE.														
12. HOLD DOWN LUGS REQUIRED FOR PROPER INSTALLATION.														
13. ONE ROLL HOLD DOWN TAPPS PER 75 FT POWER CABLE (TAPE APPLIED CONTINUOUSLY ALONG EDGES).														
14. NOTING OF COMMUNICATIONS CABLE "WINGS" REQUIRED AT ALL DATA/COM CABLEING TURNS, NOTING LUGS RECOMMENDED. DO NOT FOLD DATA/COM CABLE.														

- * INDICATES ITEMS THAT MAY BE USED FOR BOTH POWER AND DATA CABLE APPLICATIONS
- X INDICATES COLOR: -1 = BLACK, -3 = GRAY
- Y INDICATES POWER CABLEING LENGTH: L= 250 FT, -3 = 50FT, -4 = 100 FT
- Z INDICATES COMMUNICATIONS CABLEING LENGTH: L= 250 FT, -3 = 50FT, -4 = 100 FT


STEP 1:
FLOOR PREPARATION (MUST BE USED FOR SLAB-ON-GRADE APPLICATION - FIGURE 1):
THE FLOOR PREPARATION IS A YELLOW-COLORED, POLYVINYL MATERIAL, THAT IS DESIGNED TO PROTECT THE SYSTEM FROM FLOOR MOISTURE, CHEMICAL REACTION, AND ABRASION IN SLAB-ON-GRADE LEVEL APPLICATION.

1. BEGIN LAYING FLOOR PREPARATION AT THE POWER SOURCE TRANSITION FITTING. CENTER FLOOR PREPARATION OVER CIRCUIT CHALKING IN FLOOR.
2. TAPE FLOOR PREPARATION TO FLOOR, USING 4" HOLD DOWN TAPE, EVERY 10 TO 12 FEET. (FIGURE 1)


NOTE:
ADDITIONAL CABLE/FLOOR PREPARATION SHALL BE
REQUIRED FOR PROPER INSTALLATION. E.G.: FLOOR
PREPARATION, TOP SHIELD, ADHESIVE, SPRAY
ADHESIVE, HOLD DOWN TAPE, PATCHING, BONDING
CLIPS, ETC., COORDINATE INSTALLATION TECHNIQUES
AND ACTUAL FIELD CONDITIONS. PROVIDE AS NEEDED.

MAIN RUN INSTALLATION:

1. PROCEED TO LAY THE MAIN CABLE RUN, MAINTAIN ALIGNMENT, TAPE EDGES USING 4" HOLD DOWN TAPE, EVERY 6 TO 12 FEET, TO MAINTAIN ON CENTER OF FLOOR PREPARATION. (SEE FIGURE 3)
2. MAKE NECESSARY FOLDS BY HAND TO ACCOMPLISH DIRECTIONAL CHANGES USE 4" HOLD DOWN TAPE, ACROSS FLOOR PREPARATION & UNDER CARPET WIRE, BEFORE AND AFTER FOLD. (SEE FIGURE 2)
3. INSTALL TOP SHEILD, USING HOLD DOWN TAPE CONTINUOUSLY, ON EDGES OF TOP SHEILD. (SEE FIGURE 3)

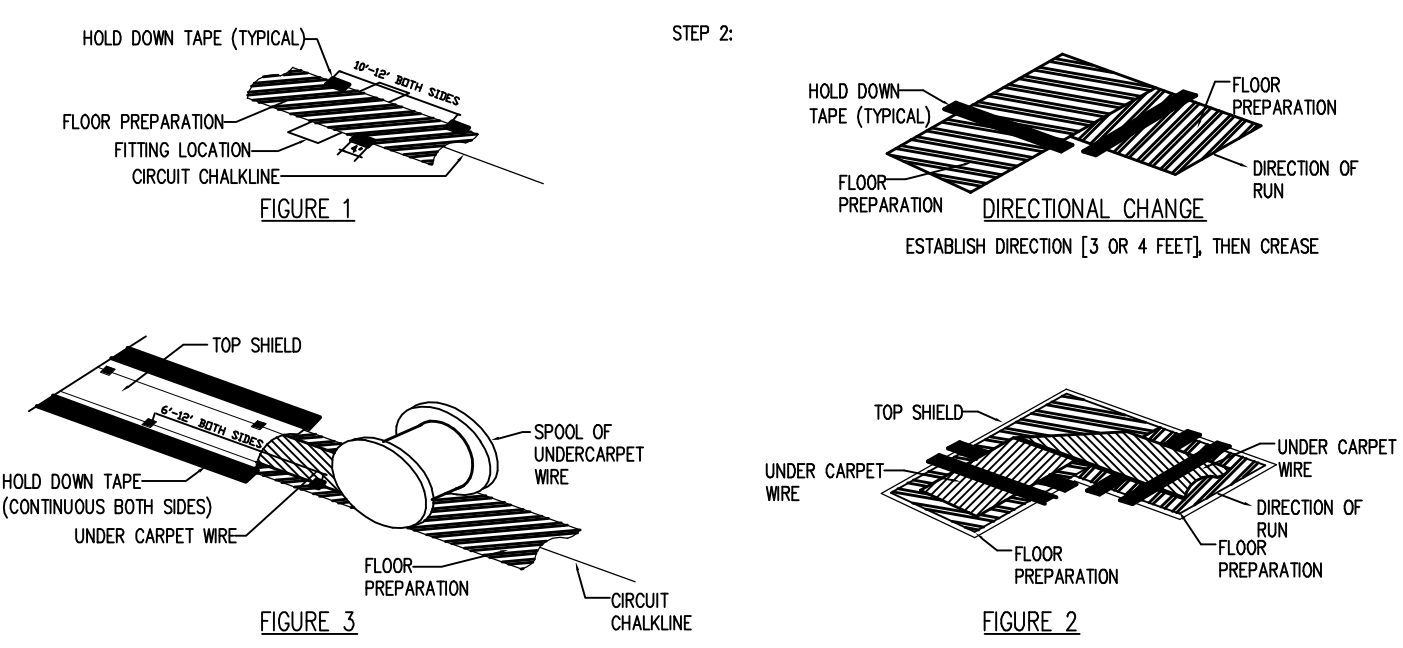

4 POWER CABLE DIRECTIONAL DETAIL

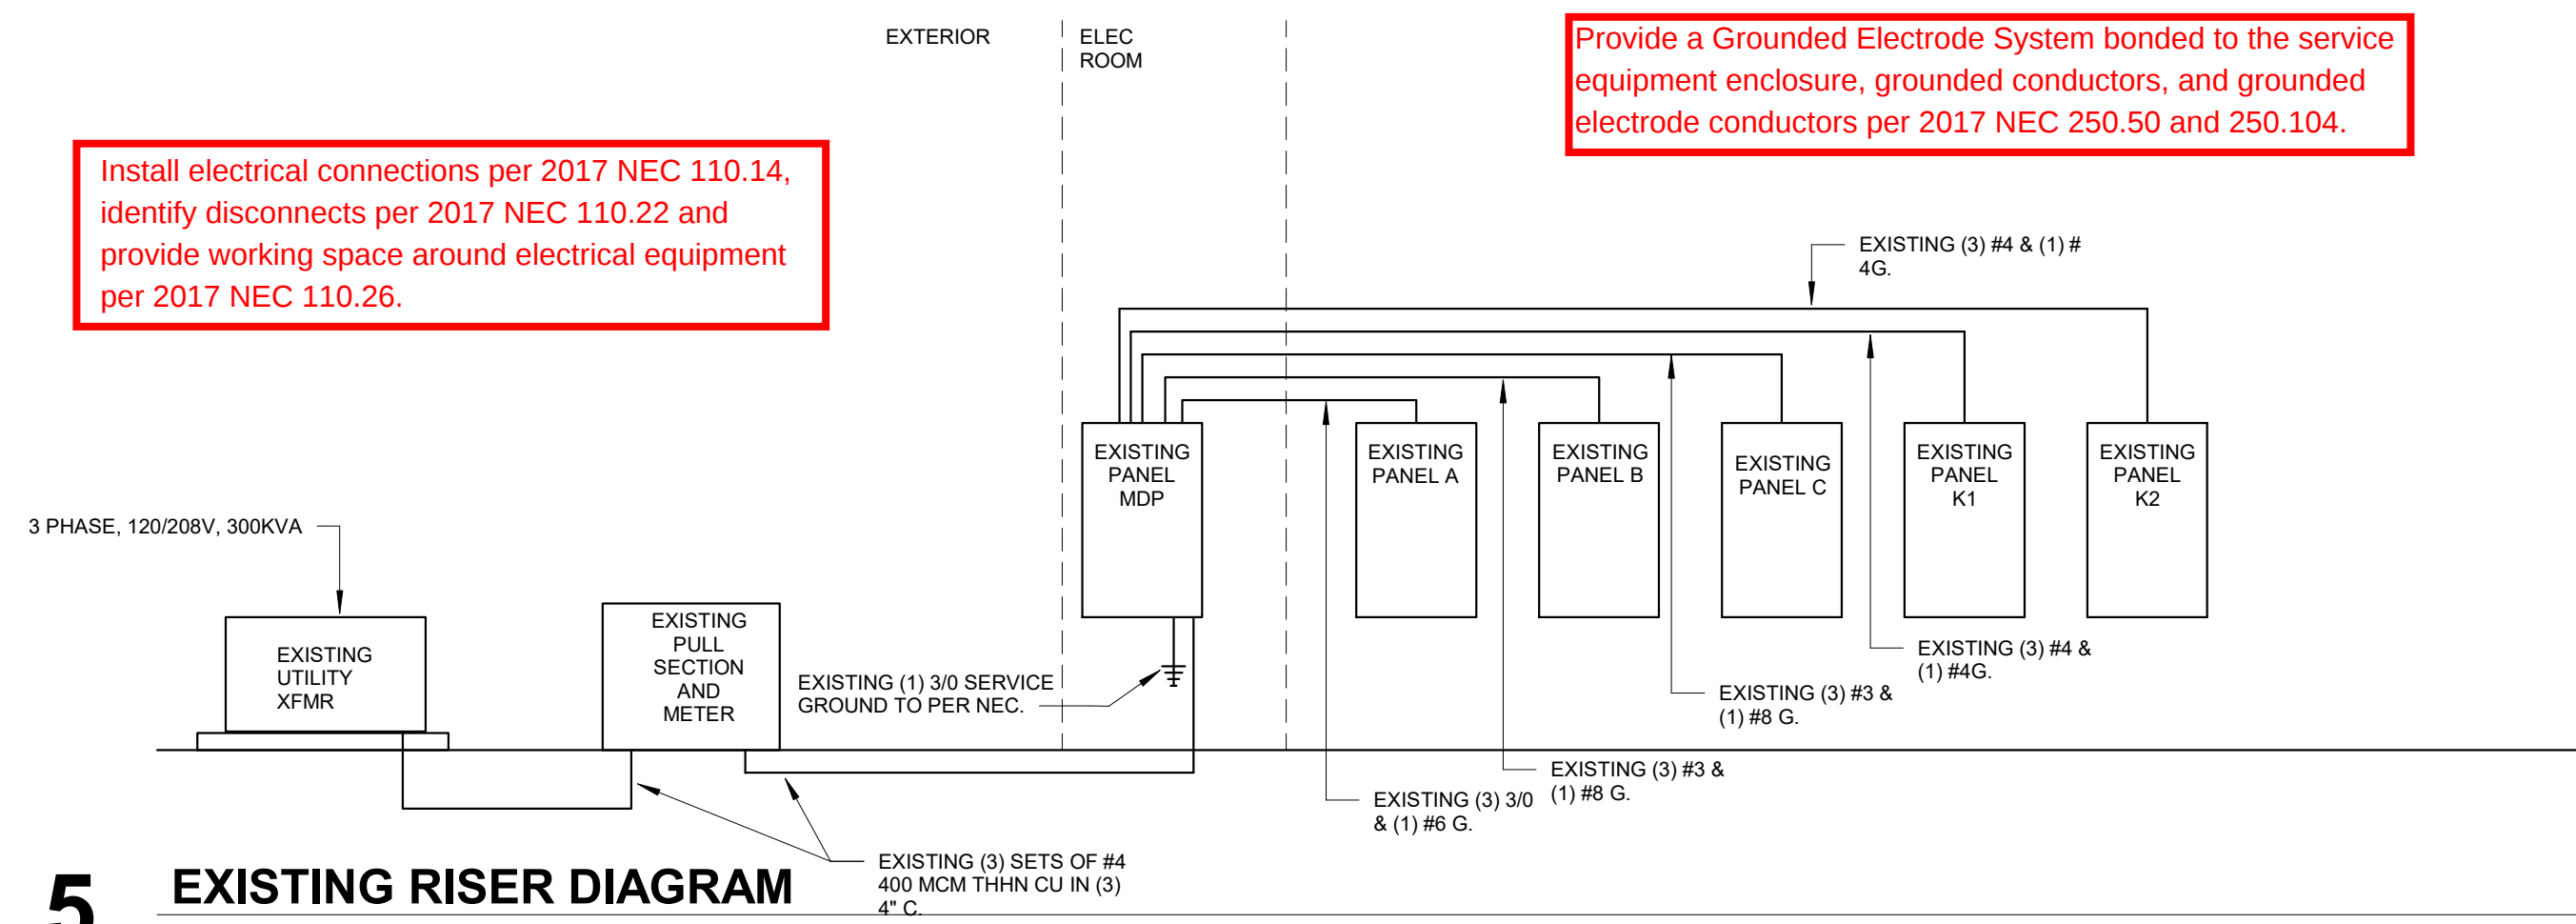

Install electrical connections per 2017 NEC 110.14, identify disconnects per 2017 NEC 110.22 and provide working space around electrical equipment per 2017 NEC 110.26.

Provide a Grounded Electrode System bonded to the service equipment enclosure, grounded conductors, and grounded electrode conductors per 2017 NEC 250.50 and 250.104.

5 EXISTING RISER DIAGRAM

Service Equipment shall be permanently and legibly marked to show the available fault current and date the calculation was performed. 2017 NEC 110.24(A)(B).

TYPE	DESIGNATION	FED FROM	VOLTAGE	INPUT 2	INPUT 3	INPUT 4	INPUT 5	BEGINNING FAULT	ENDING FAULT	LOAD (KVA)	VOLT DROP	% VOLT DROP	TOTAL % DROP		
FEEDER CU	MDP	XFM R	VOLTAGE	208	LENGTH 25	# OF SETS 3	SIZE 400	METALLIC	YES	42900	37475	135	0.17	0.08%	0.08%
FEEDER CU	A	MDP	VOLTAGE	208	LENGTH 170	# OF SETS 1	SIZE 300	METALLIC	YES	37475	7304	19	0.82	0.40%	0.48%
FEEDER CU	B	MDP	VOLTAGE	208	LENGTH 170	# OF SETS 1	SIZE 3	METALLIC	YES	37475	3086	29	3.28	1.58%	1.66%
FEEDER CU	C	MDP	VOLTAGE	208	LENGTH 170	# OF SETS 1	SIZE 3	METALLIC	YES	37475	3086	12	1.38	0.65%	0.73%
FEEDER CU	K1	MDP	VOLTAGE	208	LENGTH 170	# OF SETS 1	SIZE 400	METALLIC	YES	37475	8296	25	0.92	0.44%	0.52%
FEEDER CU	K2	MDP	VOLTAGE	208	LENGTH 170	# OF SETS 1	SIZE 400	METALLIC	YES	37475	8296	36	1.33	0.64%	0.72%



City of Aurora Building Division
Reviewed for Code Compliance
Approved as Noted: **Erick B.**
Date: **Jun 21, 2019**
2015 INTERNATIONAL CODES & 2017 NEC

RSN: **1369378**
Permit #: **19-1625136**

THIS SHEET IS PART OF THE CONSTRUCTION DOCUMENTS
OTHER SHEETS INCLUDING SPECIFICATIONS APPLY, THAT
SHOWN HEREON IS SCHEMATIC IN NATURE AND NOT TO BE
USED AS A SHOP DRAWINGS; THEREFORE, INCLUDE ALL
MODIFICATIONS REQUIRED TO CONFORM TO SITE
CONDITIONS AND THE EQUIPMENT AND MATERIAL USED.
V. CONTRACTOR TO OBTAIN ALL NECESSARY PERMITS
ARCHITECTURAL AND STRUCTURAL ELEMENTS AS SHOWN
IN THEIR RESPECTIVE DOCUMENTS, THESE ELEMENTS
ARE SHOWN FOR REFERENCE AND SHALL BE VERIFIED
PRIOR TO CONSTRUCTION AND THE ENGINEER ASSUMES
NO LIABILITY FOR THE ACCURACY OF THESE ELEMENTS
NOR DESIGN RESPONSIBILITY IS ASSUMED FOR ANY
PORTION OF THE WORK THAT THE PROFESSIONAL
ENGINEER HAS NOT SIGNED AND SEALED PER STATE
REQUIREMENTS.

Dialectic

Dialectic, Inc. T 816-997-9601
310 W 20th Street, Suite 200 F 816-997-9602
Kansas City, MO 64108 DialecticEng.com

T 816-997-9601
F 816-997-9602
DialecticEng.com

Copyright 2019



710

14005 E Exposition Ave.
Aurora, CO 80012

Owner:
CEC ENTERTAINMENT, INC.
Irving, TX 77063
ph: 972.258.5476
Contact: Mark Cramer
mrcramer@cecentertainment.com

Architect:
Parkway C&A, LP
1000 Civic Circle
Lewisville, TX 75287
Ph: 213.122.122
Contact: Greg Klimko

MEP Engineer:
Dialectic
300 W 20th St #200
Kansas City, MO 64108
Ph:816.977.9601
Contact: Joe Hillebrenner, P.E.



Architect: Greg Klimko

A	Permit Set	2019 05 15
No.	Description	Date

DRAWN BY: JGM

CHECKED BY: ATF

PROJ. NO: 08-19413

Copyright Parkway C&A, LP 2019 ©

ELECTRICAL DETAILS

E3.0

(2) Outdoor. Outdoor installations shall comply with 110.26(E)(2)(a) through (c). 2017 NEC

(a) Installation Requirements. Outdoor electrical equipment shall be the following: (1) Installed in identified enclosures. (2) Protected from accidental contact by unauthorized personnel or by vehicular traffic. (3) Protected from accidental spillage or leakage from piping systems.

(b) Work Space. The working clearance space shall include the zone described in 110.26(A). No architectural appurtenance or other equipment shall be located in this zone. Exception: Structural overhangs or roof extensions shall be permitted in this zone.

(c) Dedicated Equipment Space. The space equal to the width and depth of the equipment, and extending from grade to a height of 1.8 M (6 FT) above the equipment, shall be dedicated to the electrical installation. No piping or other equipment foreign to the electrical installation shall be located in this zone.

THIS SHEET IS PART OF THE CONSTRUCTION DOCUMENTS, OTHER SHEETS INCLUDING SPECIFICATIONS APPLY. THAT SHOWN HEREIN IS SCHEMATIC IN NATURE AND NOT TO BE USED AS A SHOP DRAWINGS; THEREFORE, INCLUDE ALL MODIFICATIONS REQUIRED TO CONFORM TO SITE CONDITIONS AND THE EIGHT AND NINE INCHES. VERIFY CONDITIONS AND DIMENSIONS OF ALL ARCHITECTURAL AND STRUCTURAL ELEMENTS AS SHOWN ON THEIR RESPECTIVE DOCUMENTS, THESE ELEMENTS ARE SHOWN FOR REFERENCE AND SHALL BE VERIFIED PRIOR TO CONSTRUCTION AND THE ENGINEER ASSUMES NO LIABILITY FOR THE ACCURACY OF THESE ELEMENTS. THE DESIGN RESPONSIBILITY IS ASSUMED FOR ANY PORTION OF THE WORK THAT THE PROFESSIONAL ENGINEER HAS NOT SIGNED AND SEALED PER STATE REQUIREMENTS.

Dialectic

Dialectic, Inc.
310 W 20th Street, Suite 200
Kansas City, MO 64108
Texas Certificate of
Authorization Number F-1367

T 816-997-9601
F 816-997-9602
DialecticEng.com

Copyright 2017

City of Aurora Building Division
Reviewed for Code Compliance
Approved as Noted: **Erick B.**
Date: **Jun 21, 2019**
2015 INTERNATIONAL CODES & 2017 NEC

RSN: 1369378
Permit #: 19-1625136




Parkway C&A, LP
1000 Civic Circle Lewisville, TX 75067
pkwycon.com (972) 221-1979

<u>Project Manager:</u>	<u>Architect:</u>
PA #1	CPM #1
123.456.7891	123.456.7891

14005 E Exposition Ave.
Aurora, CO 80012

Owner:
CEC ENTERTAINMENT, INC.
Irving, TX 77063
ph: 972.258.5476
Contact: Mark Cramer
mccramer@cecentertainment.com

Architect:
Parkway C&A, LP
1000 Civic Circle
Lewisville, TX 75287
Ph: 213.122.122
Contact: Greg Klimko

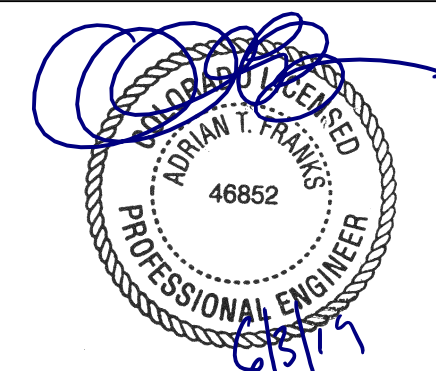

No.	Description	Date
-----	-------------	------

DRAWN BY: Author
CHECKED BY: Checker
PROJ. NO: 08-19413
Copyright Parkway C&A, LP 2019 ©

SITE PLAN

ES1.0

Owner:
CEC ENTERTAINMENT, INC.
Irving, TX 77063
ph: 972.258.5476
Contact: Mark Cramer
mrcramer@cecentertainment.com

Architect:
Parkway C&A, LP
1000 Civic Circle
Lewisville, TX 75087
Ph: 213.122.122
Contact: Greg Klimko

MEP Engineer:
Dialectic
300 W 20th St #200
Kansas City, MO 64108
Ph:816.977.9601
Contact: Joe Hillebrenner, P.E.



Architect: Greg Klimko

[illegible]

A	Permit Set	2019 05 15
No.	Description	Date

DRAWN BY: Author

CHECKED BY: Checker

PROJ. NO: 08-19413

Copyright Parkway C&A, LP 2019 ©

PLUMBING FLOOR PLAN

P101

REFER TO ARCHITECTURAL SHEET A103 ENLARGED RESTROOM PLAN FOR FINAL PLUMBING FIXTURE SPECIFICATIONS					
ID	FIXTURE TYPE	MANUFACTURER	MODEL NO.	DESCRIPTION	TRIM AND REMARKS
LAV	LAVATORY	WILSONART	#BV123 CREAM 1572-SL	SOLID SURFACE INTEGRAL MOUNT SINK	PROVIDE WITH A TOTO #LTG03301U#CP 1.2 GPM, MANUAL SINGLE HANDLE, ADA COMPLIANT, CHROME FINISH, BRASS CONSTRUCTION, LEVER HANDLE, CERAMIC DISC VALVE CARTRIDGE CONSTRUCTION, WILKINS #2W/3887OOT MIXING VALVE SET TO 105 DEGREES. PROVIDE WITH GRID STRAINER DRAIN WITH TAILPIECE, CHROME PLATED CAST BRASS P-TRAP WITH CLEANOUT, WASTE ARM TO WALL WITH ESCUTCHEON, AND LOOSE KEY ANGLE STOPS. INSULATE WATER AND WASTE PIPING UNDER LAVATORY WITH TRUEBRO "LAV GUARD2" #102E-Z.
UR	URINAL	TOTO	#UT105U 1.25 GPF	HIGH-EFFICIENCY 0.125 GPF WALL HUNG WHITE VITREOUS CHINA WASHOUT URINAL	PROVIDE WITH AN TOTO "ECOPOWER" #TEU1UA12#CP FLUSH VALVE.
WC2	WATER CLOSET ADA	AMERICAN STANDARD	#3043.001	ADA FLOOR MOUNT FLUSHOMETER VALVE TOILET, VITREOUS CHINA 16-1/2" HEIGHT	PROVIDE WITH AMERICAN STANDARD MANUAL TOILET FLUSH VALVE #6047.002, WHITE HEAVY-DUTY OPEN FRONT LESS COVER SEAT #5901-100. PROVIDE WITH VACUUM BREAKER, ANGLE CHECK STOP, AND FITTINGS REQUIRED FOR INSTALLATION.
WC1	WATER CLOSET	AMERICAN STANDARD	#2243.001	FLOOR MOUNT FLUSHOMETER VALVE TOILET, VITREOUS CHINA 15" HEIGHT	PROVIDE WITH AMERICAN STANDARD MANUAL TOILET FLUSH VALVE #6047.002, WHITE HEAVY-DUTY OPEN FRONT LESS COVER SEAT #5901-100. PROVIDE WITH VACUUM BREAKER, ANGLE CHECK STOP, AND FITTINGS REQUIRED FOR INSTALLATION.

1 PROVIDE NEW PLUMBING FIXTURE AND ACCESSORIES IN SIMILAR LOCATION. EXISTING WASTE, VENT, AND SUPPLY PIPING TO BE MODIFIED AS NECESSARY FOR CONNECTIONS TO NEW FIXTURE. REFER TO ARCHITECTURAL DRAWINGS FOR FIXTURE LOCATIONS AND DETAILS.

ABBREVIATIONS:

AFF/AFG	ABOVE FINISHED FLOOR/GRADE
AHJ	AUTHORITY HAVING JURISDICTION
AS	ANGLE STOP
BFP	BACKFLOW PREVENTER
CO	CLEANOUT
ETR	EXISTING TO REMAIN
FPC	FIRE PROTECTION CONTRACTOR
FFCO/FGCO	FLUSH FLOOR/GRADE CLEANOUT
FSEC	FOOD SERVICE EQUIPMENT CONTRACTOR
GC	GENERAL CONTRACTOR
IW	INDIRECT WASTE
OC	ON CENTERS
MC	MECHANICAL CONTRACTOR
NFPA	NATIONAL FIRE PROTECTION ASSOCIATION
PC	PLUMBING CONTRACTOR
RI	ROUGH-IN
TYP	TYPICAL
VTR	VENT THRU ROOF
WCO	WALL CLEANOUT

LINETYPES:

— — — — —	COLD WATER (CW)
— — — — —	HOT WATER (HW)
— — — — —	HOT WATER RETURN (HWR)
— — — — —	SANITARY WASTE (SAN) - BELOW SLAB/GRADE
— — — — —	PLUMBING VENT (V)
— — V — —	PLUMBING VENT (V) - BELOW SLAB/GRADE
— — CW — —	COLD WATER BELOW SLAB/GRADE
— — HW — —	HOT WATER BELOW SLAB/GRADE
— — BEV — —	BEVERAGE CONDUIT (BEV)
— — CO2 — —	CO2 CONDUIT (CO2)

PIPE SYMBOLS:

	PIPE TURNING UP/DOWN
	TEE TURNING UP/DOWN
	SHUTOFF VALVE (BALL TYPE)
	END CAP
	CONNECT TO EXISTING

THIS SPACE IS CURRENTLY SERVED BY AN AUTOMATIC WET PIPE FIRE SPRINKLER SYSTEM. CONTRACTOR SHALL BE RESPONSIBLE FOR THE MODIFICATION OF THE EXISTING FIRE SPRINKLER SYSTEM IN ACCORDANCE WITH NFPA REQUIREMENTS. PROVIDE ALL MATERIALS AND LABOR REQUIRED FOR COMPLETE INSTALLATION. SYSTEM MODIFICATIONS SHALL BE DESIGNED UNDER THE SUPERVISION OF A LICENSED PROFESSIONAL ENGINEER, AND CONTRACTOR SHALL PREPARE ALL REQUIRED SIGNED/SEALED DRAWINGS. CONTRACTORS ARE TO OBTAIN APPROVAL FROM THE STATE, LOCAL, AND INSURANCE UNDERWRITING AUTHORITIES. THE SPRINKLER SYSTEM SHALL BE TESTED UNDER PRESSURE BY CONTRACTOR, AND INSPECTED AND APPROVED BY LOCAL FIRE MARSHAL, PRIOR TO ACCEPTANCE BY OWNER.

THIS SHEET IS PART OF THE CONSTRUCTION DOCUMENTS. OTHER SHEETS INCLUDING SPECIFICATIONS APPLY. THAT SHOWN HEREIN IS SCHEMATIC IN NATURE AND NOT TO BE USED AS A SHOP DRAWINGS; THEREFORE, INCLUDE ALL MODIFICATIONS REQUIRED TO CONFORM TO SITE CONDITIONS AND THE EQUIPMENT AND MATERIAL USED. VENDOR: _____ ARCHITECTURAL AND STRUCTURAL ELEMENTS AS SHOWN ON THEIR RESPECTIVE DOCUMENTS, THESE ELEMENTS ARE SHOWN FOR REFERENCE AND SHALL BE VERIFIED PRIOR TO CONSTRUCTION AND THE ENGINEER ASSUMES NO LIABILITY FOR THE ACCURACY OF THESE ELEMENTS. NO DESIGN RESPONSIBILITY IS ASSUMED FOR ANY PORTION OF THE WORK THAT THE PROFESSIONAL ENGINEER HAS NOT SIGNED AND SEALED PER STATE REQUIREMENTS.

Dialectic

Dialectic, Inc.
310 W 20th Street, Suite 200
Kansas City, MO 64108
T 816-997-9601
F 816-997-9602
DialecticEng.com

Copyright 2019



City of Aurora Building Division
Reviewed for Code Compliance
Approved as Noted: **bmckinzi**
Date: **Jun 04, 2019**
2015 INTERNATIONAL CODES & 2017 NEC

01 ENLARGED RESTROOM PLAN

$$1/4" = 1'-0"$$

See revised sheet
A9.2 for the
required urinal
partition 2015 IPC
405.3.5

Provide drains no smaller than allowed by **2015 IPC 709.1 and 710.1(1)**